



148
876

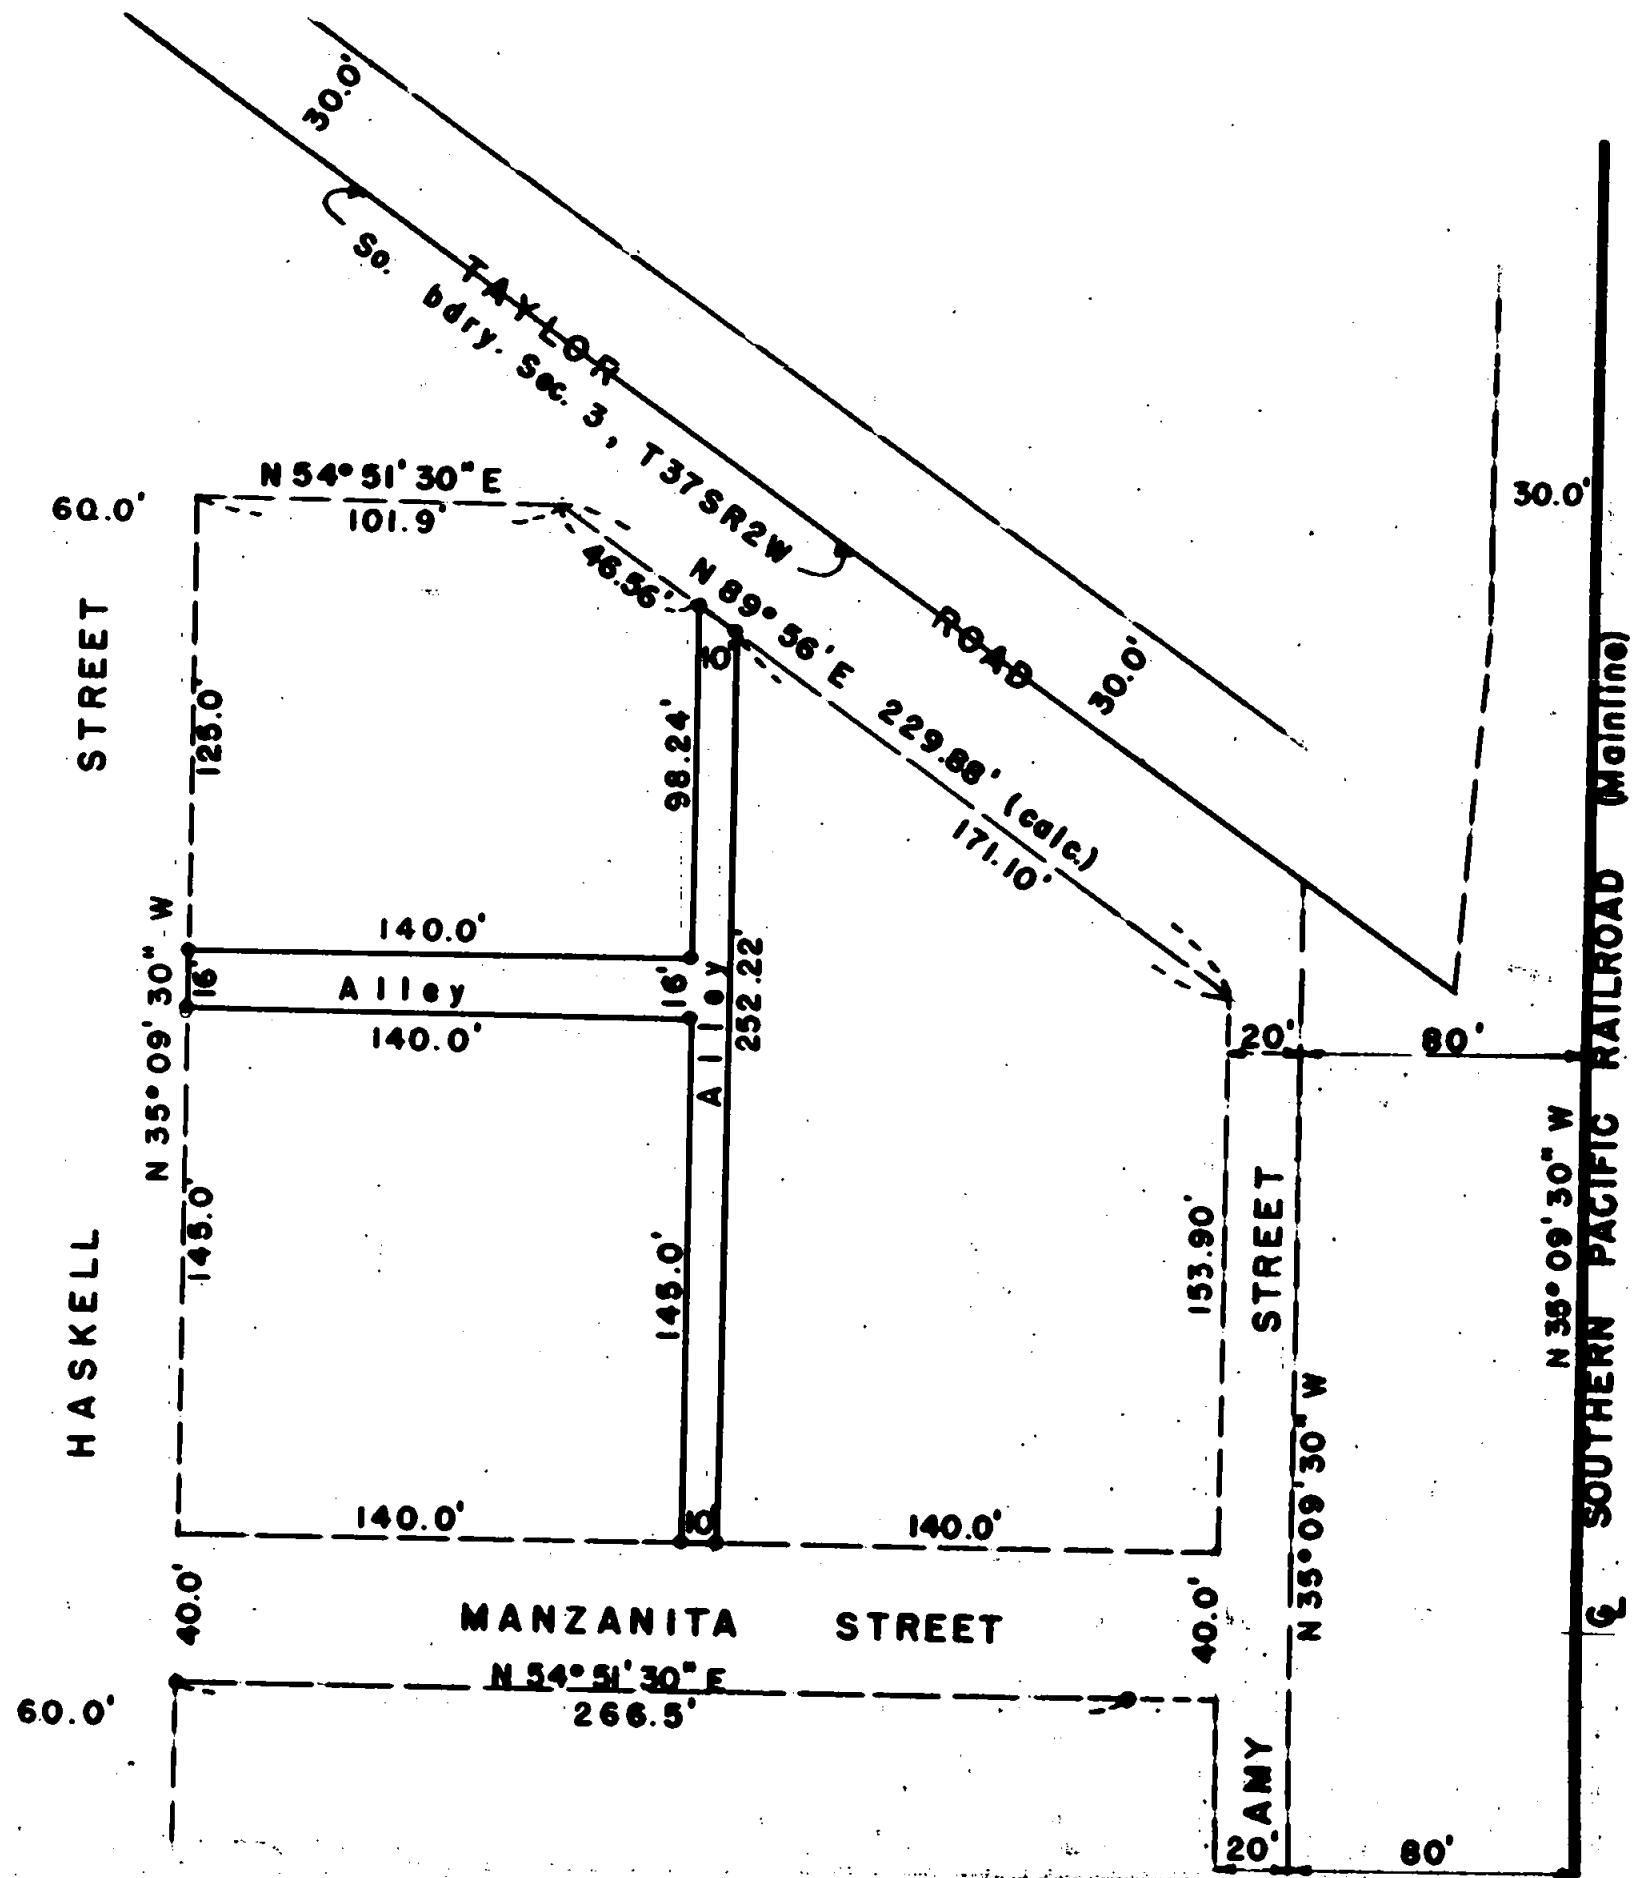


Survey For
THE MT. PITT CO.
Located In Block 2 of
AMY B. HARBAUGH'S ADD. to
Central Point, Oregon
By: Mark E. Boyden
Aug. 1956

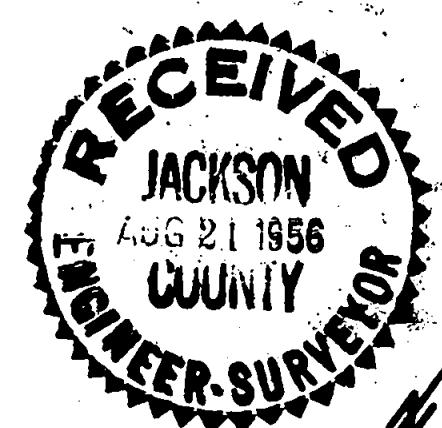

SCALE : 1" = 60'

- found iron pin
- set 1/2" iron pipe

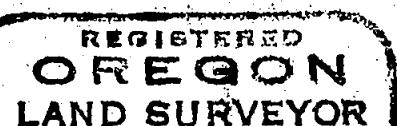

NOVEMBER 9, 1951
MARK E. BOYDEN
281

Survey Narrative to Comply with Paragraph 209.250,
Oregon Revised Statutes

FOR: The Mt. Pitt Company

PURPOSE: To monument the alley boundaries in Block 2 of AMY &
HARBAUGH'S ADDITION to Central Point, Oregon.

PROCEDURE: Found control points set on Record Survey No. 629 to
establish the boundaries of Haskell and Manzanita streets.

Enclosed said Block 2 using the plat record distances
and calculated the closure along the North boundary of the Block.

Proportionate measurement closing to the Section line
was not considered in this particular case as it is readily apparent
that the Section line used at the time of the plat was considerably
South of its present established position.

August 1956

