
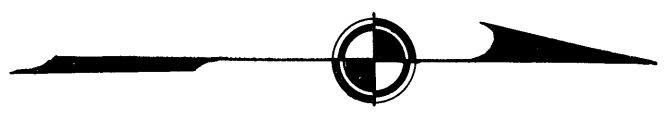


81.4 ± ACRES

RETACEMENT OF SURVEY BY  
 TOM R. PEARCE FILE NO. 1027  
 FOR THE PURPOSE OF CHECKING  
 BEARINGS AND DISTANCES  
 LOCATED IN SEC'S 21 & 22, T. 37S, R. 2W, W.M.  
 SCALE: 1"=200'  
 PAUL B. RYNNING  
 CO. SURVEYOR  
 OCT. 1957

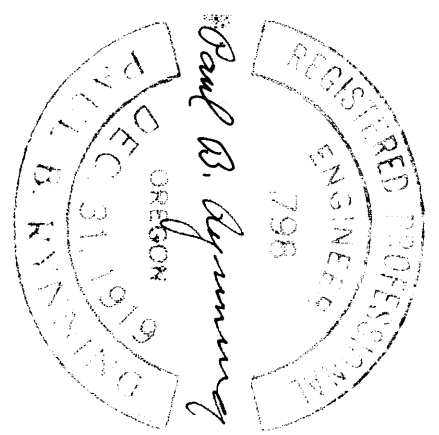

NOTE:  
 THE BASALT STONE AT THE N.W. CORNER D.L.C.  
 NO. 67 AND ALL PIPES SHOWN WERE FOUND  
 IN PLACE.  
 MERIDIAN BY SOLAR OBSERVATION

SURVEY NARRATIVE TO COMPLY WITH SECTION 87-330  
1947 OREGON LAWS

Survey For: Jackson County

Location: Township 37 South, Range 2 West, Willamette Meridian.

Purpose of Survey: To check distances and bearings of survey made by Tom R. Pearce, File 1017. Also to tie to the Northwest corner of Donation Land Claim 67.

Procedure: Found the stone monument at the Northwest corner of D.L.C. 67; thence ran Southerly tying in the Northeast corner of D.L.C. 41 and then to the  $1\frac{1}{2}$ " pipe set by Tom R. Pearce for the Northwest corner of the property to be deeded by Claire, Martha, and Mary Hanley to Jackson County. From that point, followed the boundary as laid out by the said Tom R. Pearce. Each pipe was found in place but found differences in both distances and bearings.

October 1957

Paul B. Rynning  
County Surveyor

