


Map To

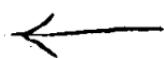

1227

Next

Survey Narrative to Comply With Paragraph 209.250
Oregon Revised Statutes

FOR: Ralph Cook and Crystal Springs Packing Co., Inc.

- PURPOSE: 1. To monument and prepare a description of all of Lot No. 13 of CREST BROOK ORCHARD TRACTS excepting the West 5.00 acres of the North 10.94 acres.
2. To monument and describe orchard land to be sold by Cook, located in FAIR OAKS ORCHARD TRACTS and D.L.C. #58, Township 37 South, Range 1 West.
3. To monument and describe the residence parcel to be retained by Cook.

PROCEDURE: From Recorded Survey No. 1205, the controls for proportionment of lot corners in CREST BROOK ORCHARD TRACTS was established. Calculated the location of the property corners from said base line controls, monumenting same as shown.

The Southerly boundary of the Cook residence tract and the Southerly boundary of that orchard tract being sold is the Northerly boundary of a 40' road dedicated in the FAIR OAKS ORCHARD TRACTS. Traversed Easterly along said roadway in search of the original corner pipes, but extensive orchard cultivation has destroyed all of the interior roadway corners. From the control pipes found at each end, a calculation concluded that the plat record would not fit the monuments as found on the ground. Therefore, the record angles and distances as reported by Mr. C. Z. Boyden in a survey made in 1928 when the original 1/2" pipe monuments were found, was used to control the two most Easterly tangents of said road and a mean of proportionate measurement, angles and ties to subdivisional control points were used to compute the remaining westerly road points.

Control for the centerline North Phoenix Road was established from the stone located at the Southeast corner of CREST BROOK ORCHARD TRACTS to the stone at the Northeast corner of D.L.C. #59.


The North property boundary was established on the North boundary of D.L.C. #58 as located between stone monuments found.

In Recorded Survey No. 35, the Dodge residence tract was monumented with 3/4" iron pipes. Found all four of these pipes, using their present position to control for this survey except where these pipes were set in the road right-of-way. No attempt was made to definitely establish the East boundary of D.L.C. #58 or the North boundary of FAIR OAKS ORCHARD TRACTS, as the Cook ownership has now merged these old ownerships. The boundaries that are at present within the Cook ownership were established on the existing fence lines or canal centerlines as designated by Cook and the purchaser.


Set iron monuments at the property corners as shown.

The bearings for this survey are based on the City of Medford plane coordinate system, corrected to true. Coordinate base line was Picture Point #25 (iron pin) and Woods (Roxy Anne) with the bearing of North $0^{\circ} 04'$ West determined for the centerline of the North Phoenix Road after using a Theta angle of $1^{\circ} 35' 08''$ at Picture Point No. 25 and then correcting same for convergency.

March 1959

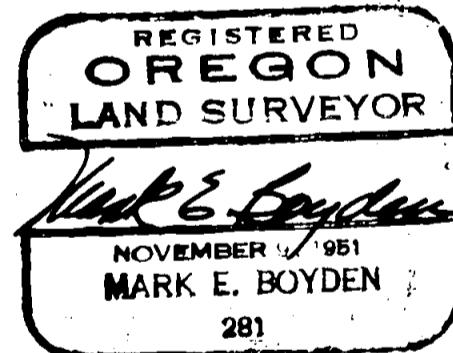



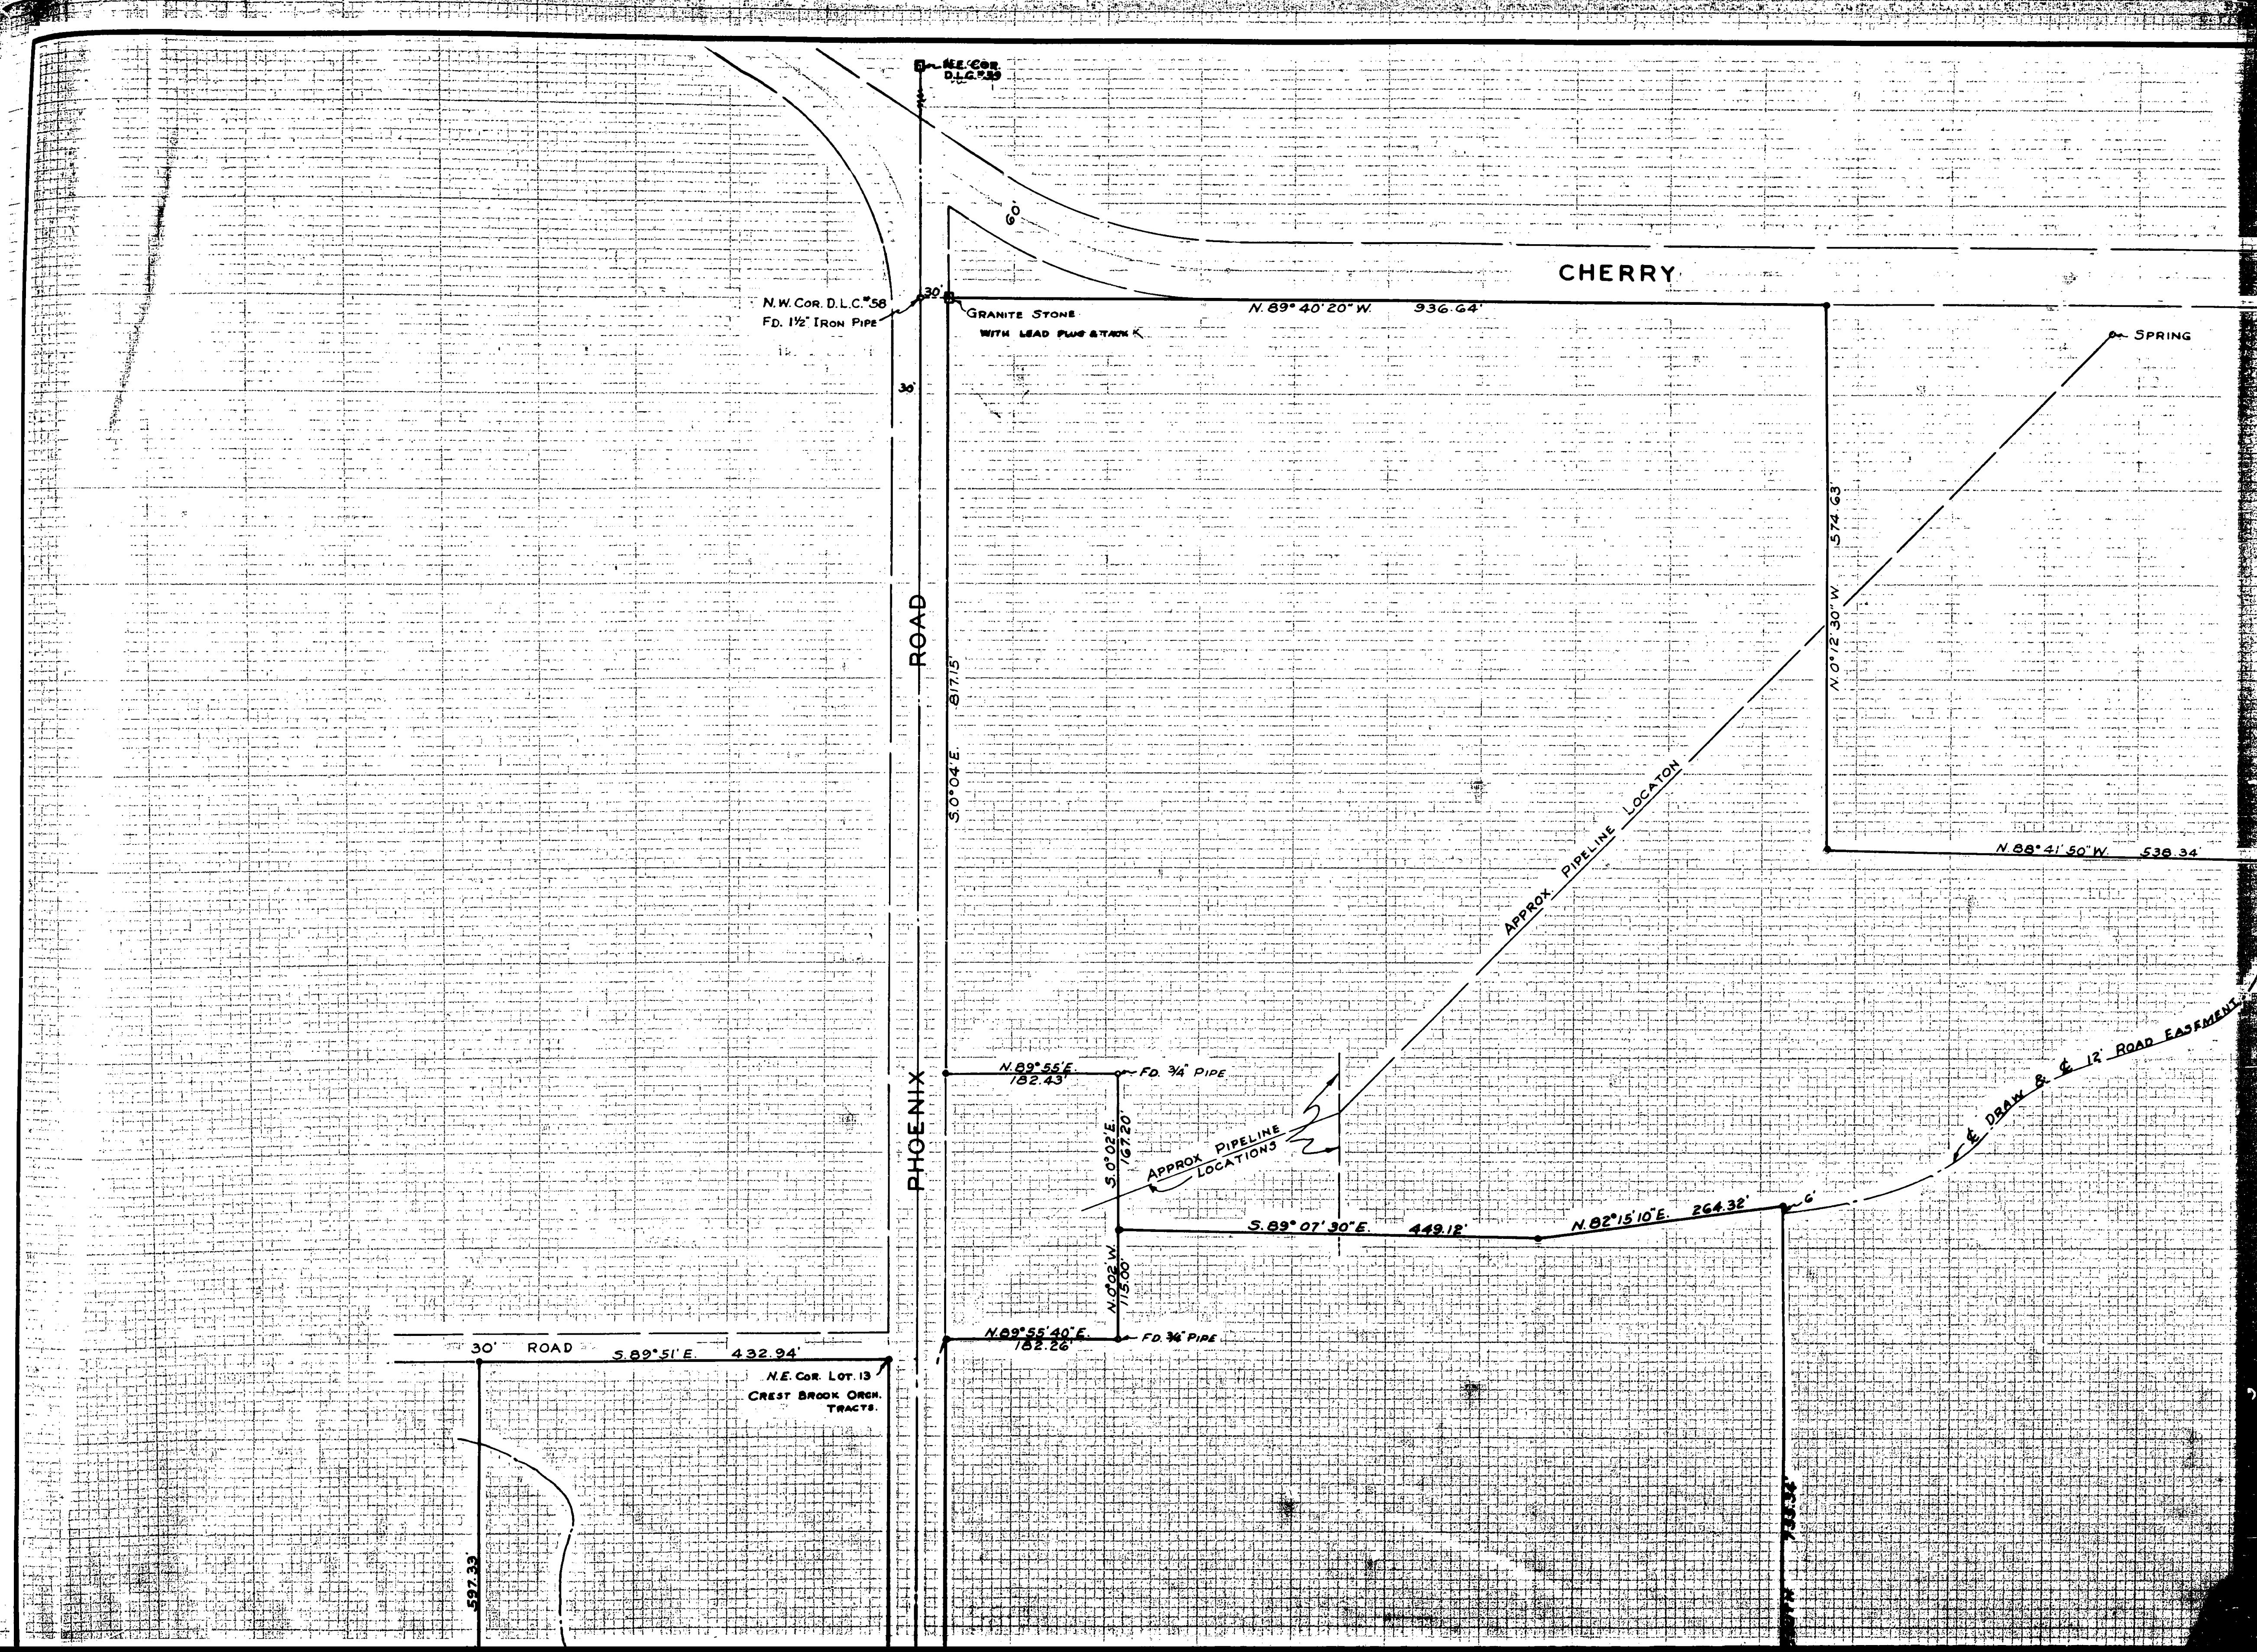

SOUTH

108.61 ACRES

5.89°08'50"E
296.90'

DOMESTIC WATER
PUMP HOUSE

As-Built
PIPE Location
PIPE Line

5.0°08'40"W
6.7916
262.7
278.47'

DOMESTIC WATER TANK
PIPE TRENCH
PUMP

186.93'
157.75'
5.89°12'E

N 73°04'E
40°

630.85'
DEDICATED


N 78°09'E
423.00'
ROAD

5.62°03'10"E
674.50'
N 70°54'3"

CHERRY

LANE





APPROV.
PIPELINE
LOCATION

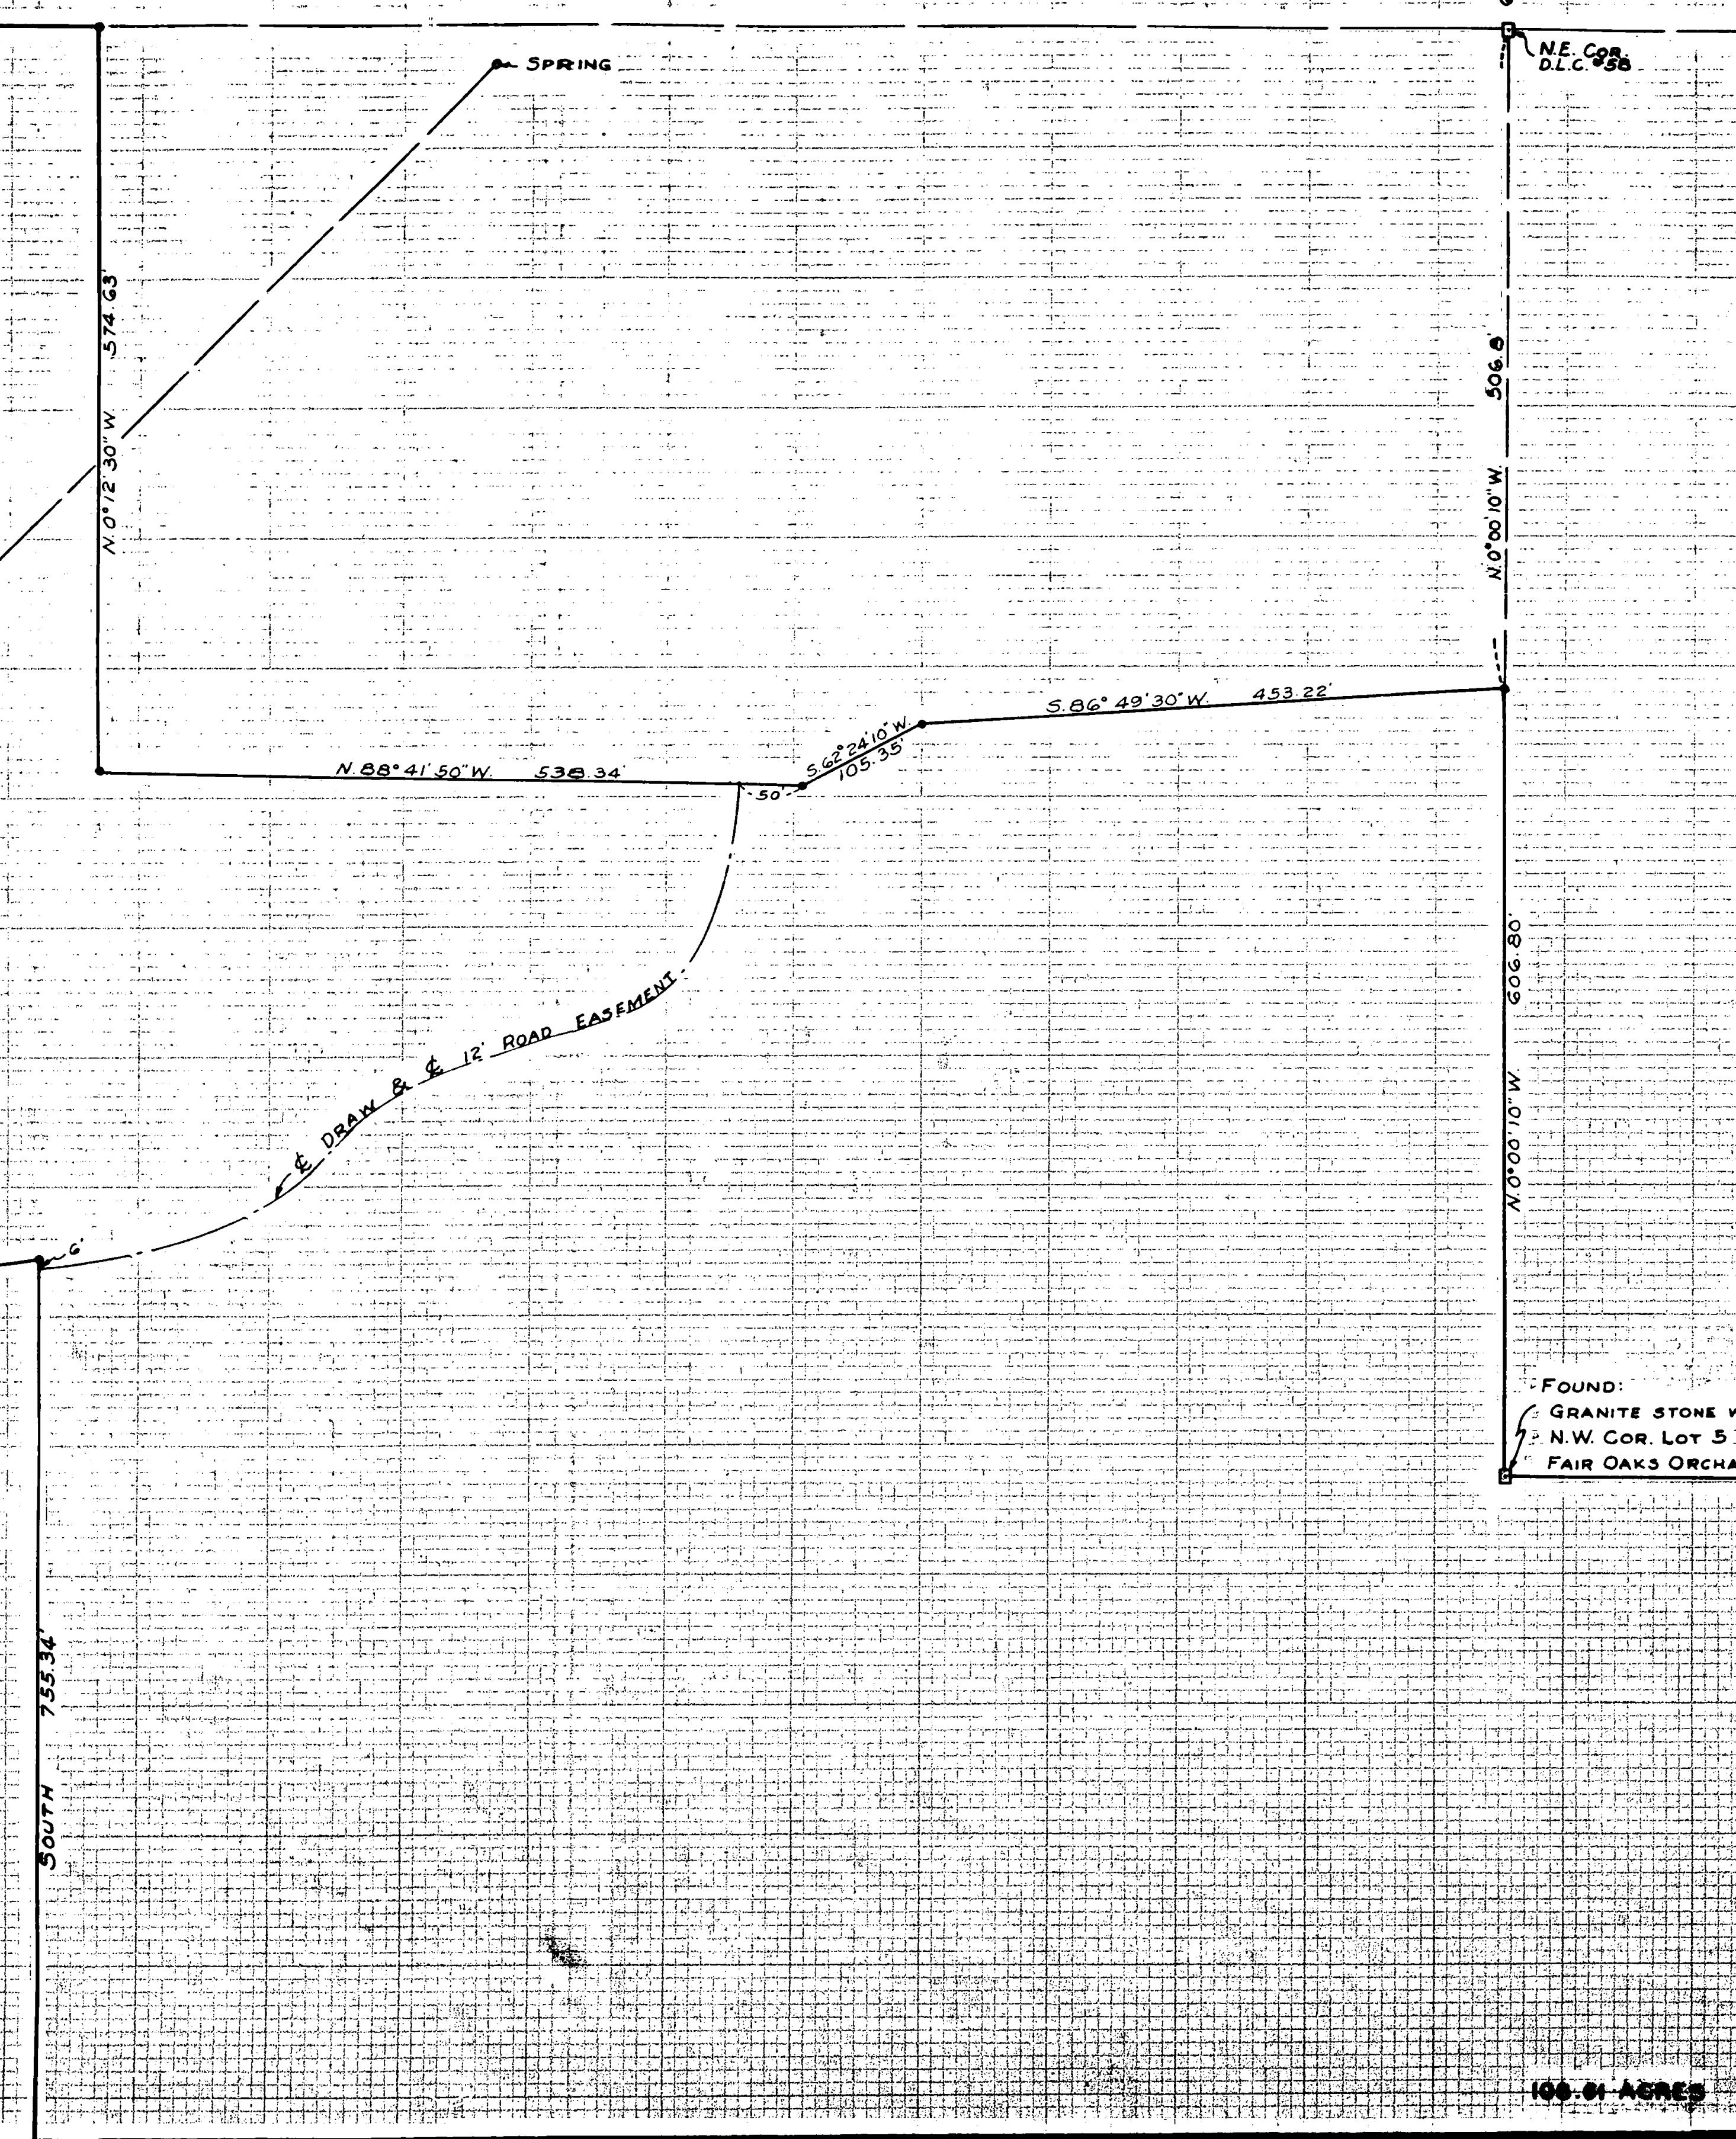

LOCATED IN
LOT NO. 13, CREST BROOK ORCHARD TRACTS
LOTS 1-10, FAIR OAKS ORCHARD TRACTS
D.L.C. NO. 58, SEC. 27, T. 37 S., R. 1 W. W.M.

BY: MARK E. BOYDEN

FEB. 1959

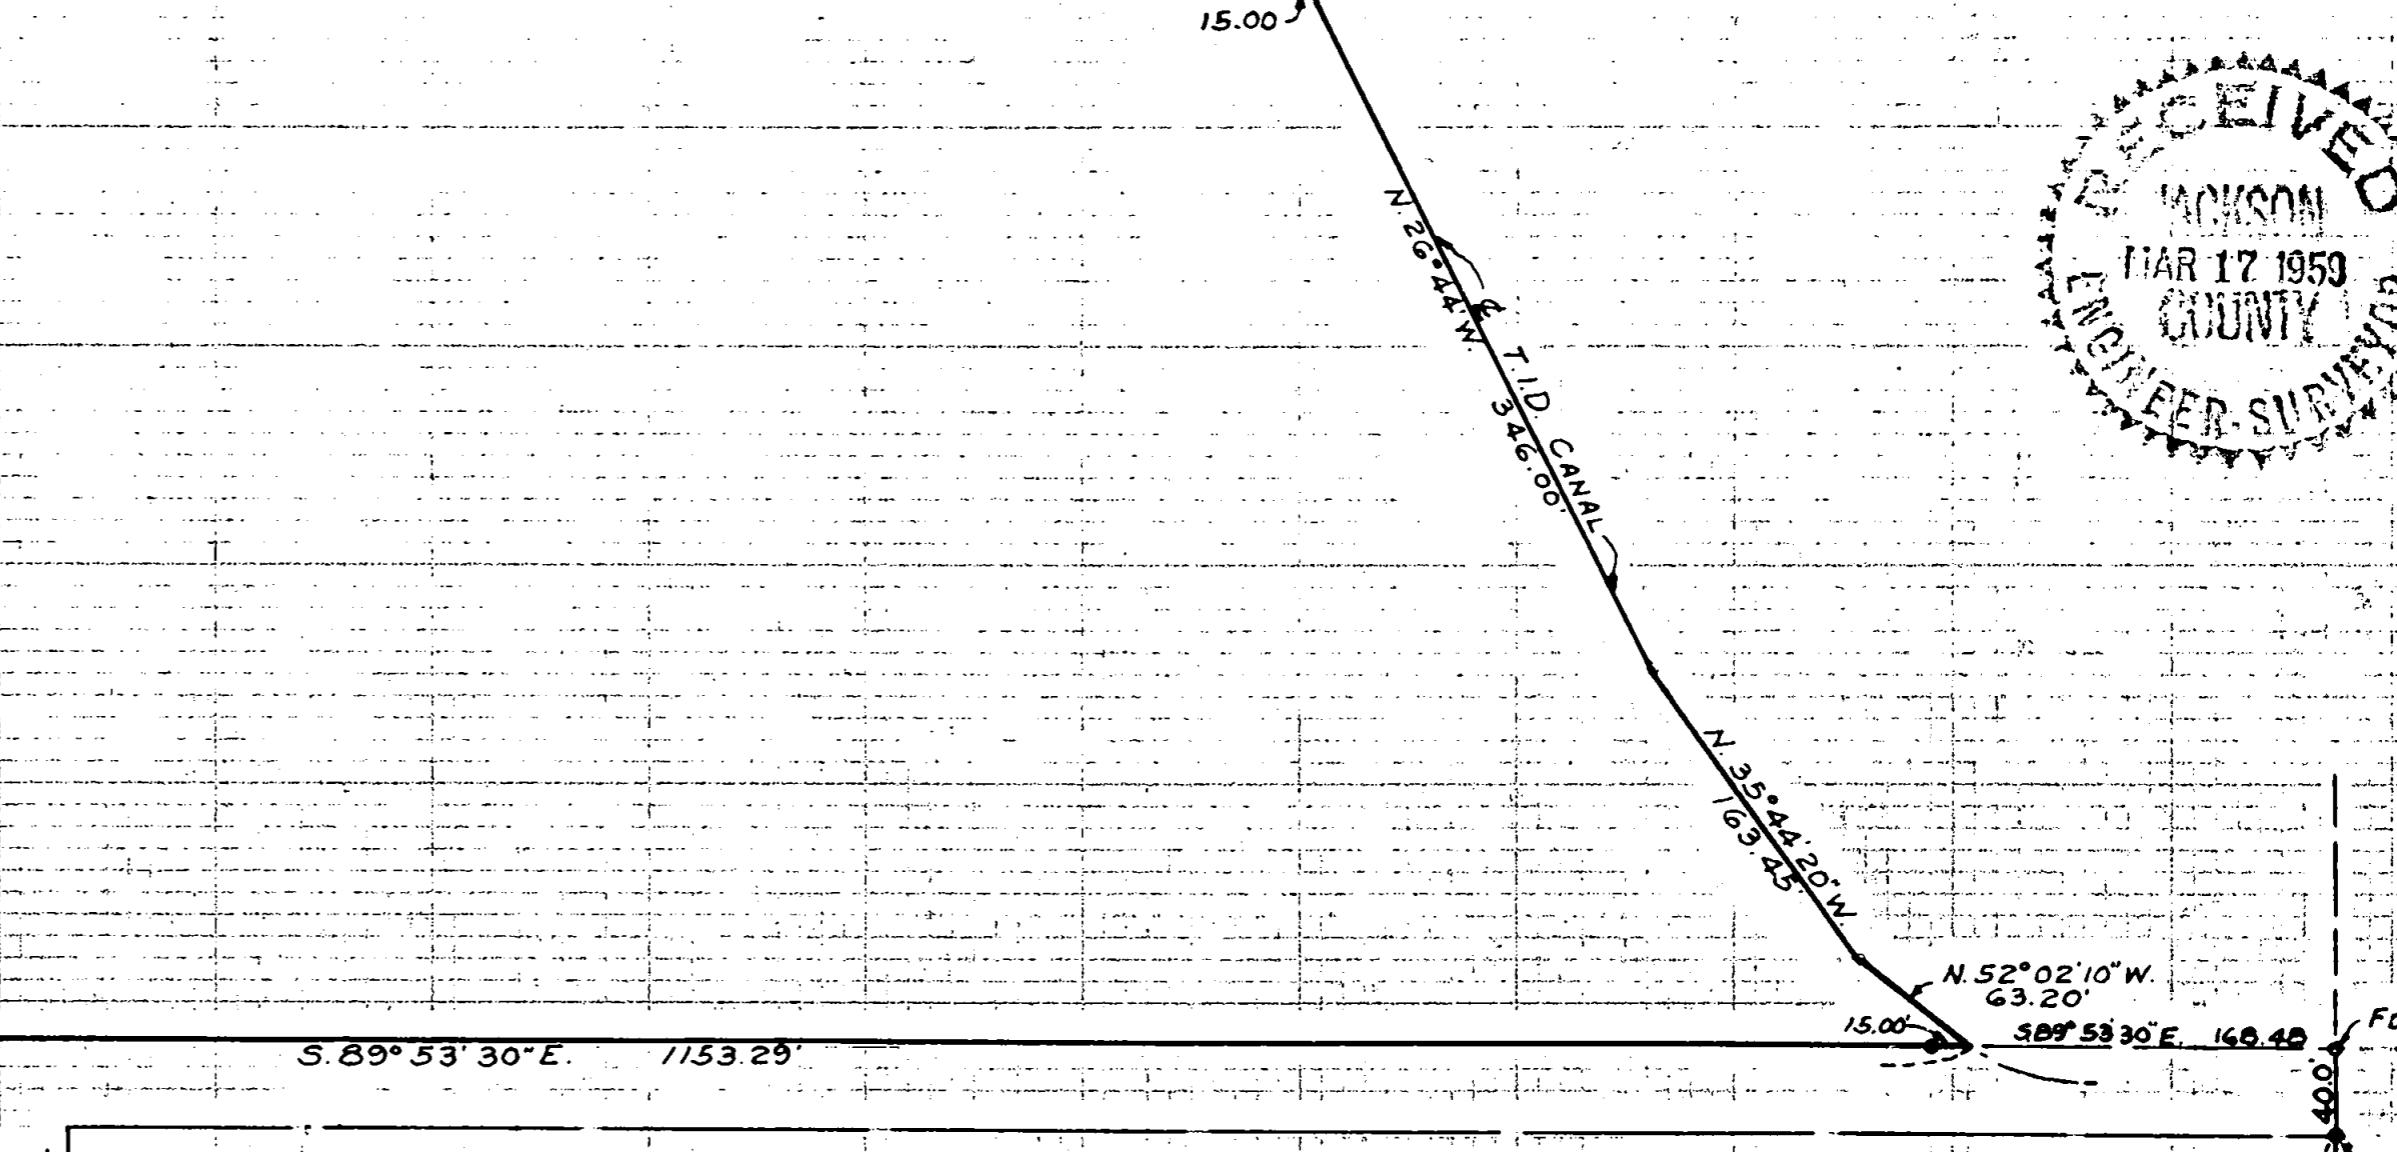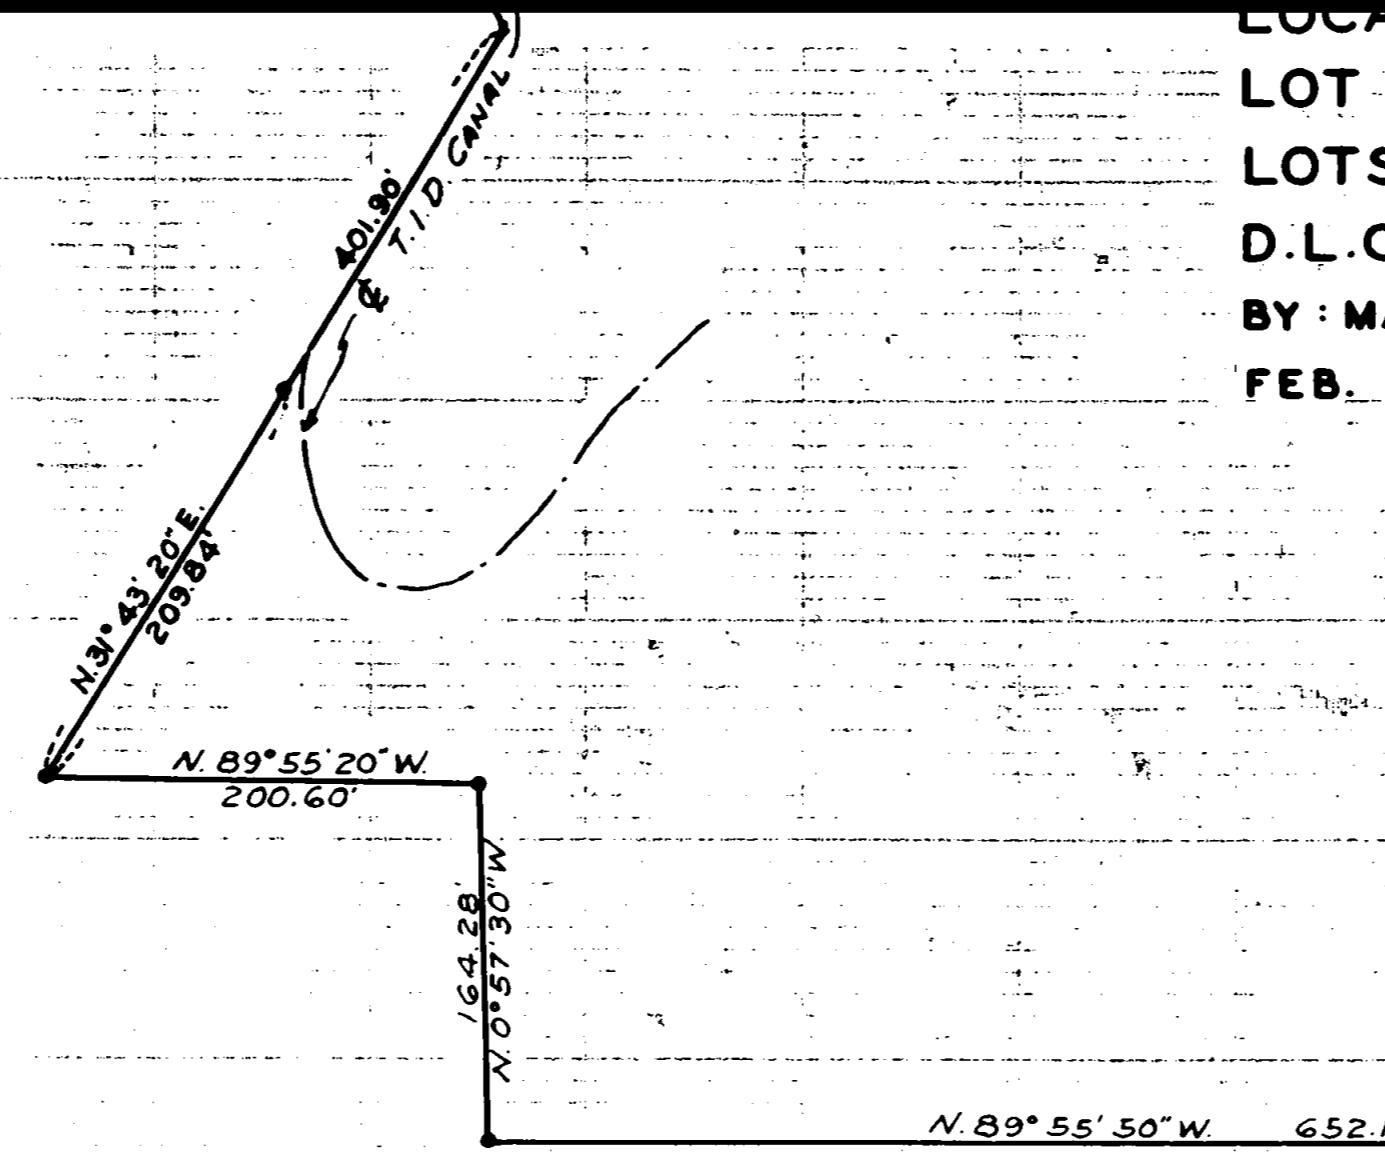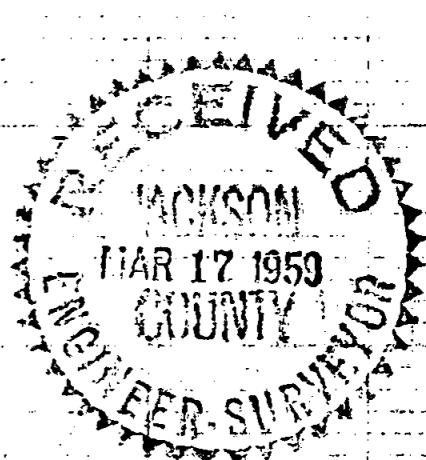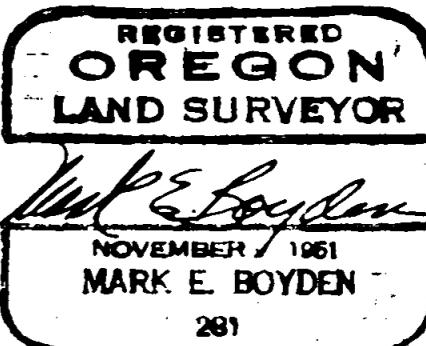

NO. 27 30" W.

FO. 1/8 IRON PIPE


FO. 1/4 IRON PIPE

SCALE - 1" = 100'


LEGEND

- = FOUND 8" X 8" GRANITE STONE WITH LEAD CENTER POINT
- = IRON PIPE FOUND
- = 5/8" X 30" IRON PIN SET IN CONCRETE

THIS POINT IS
850.8' SOUTH &
2994.0' EAST OF
THE N.W. COR.
D.L.C. #58, T.37S, R.I.W.

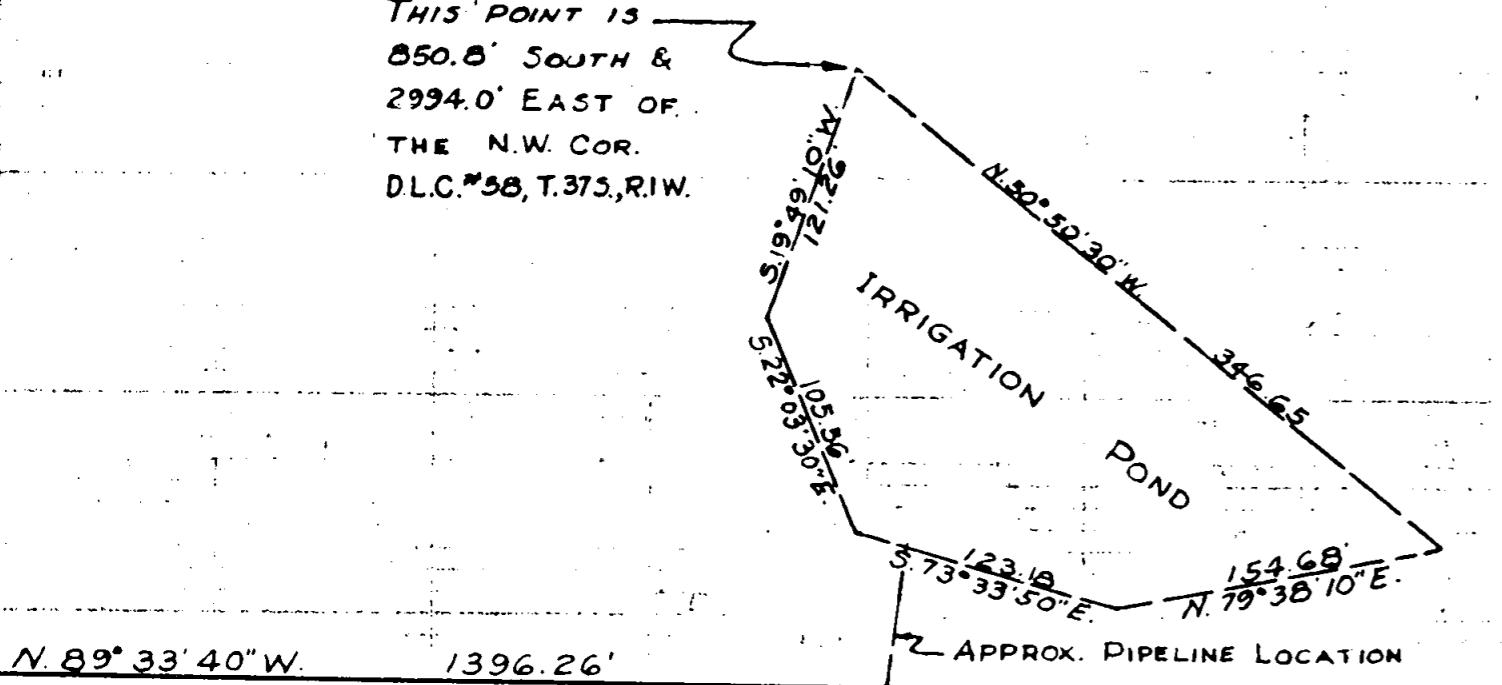

N 89° 33' 40" W 1396.26'

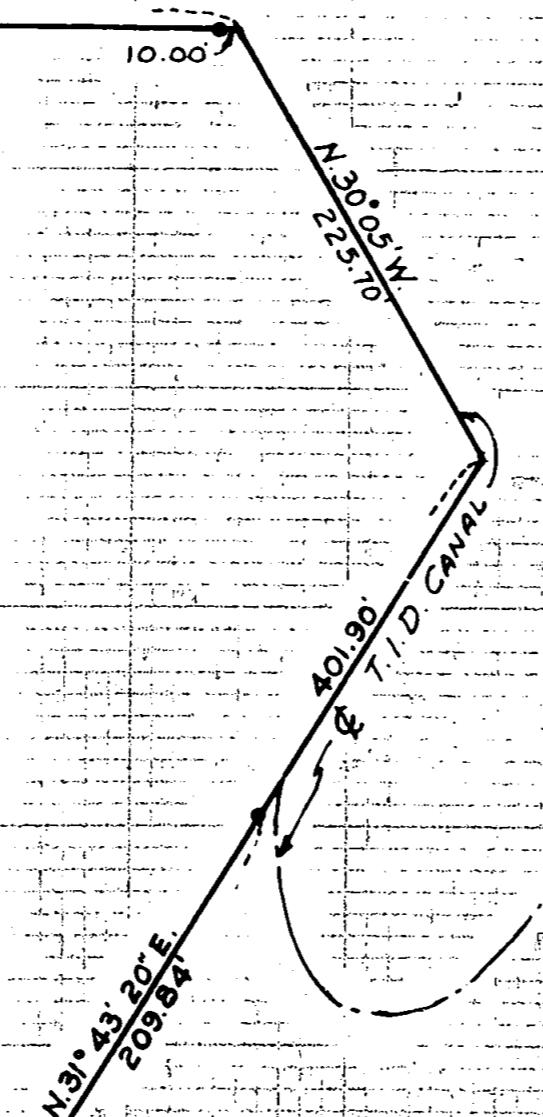

N 89° 55' 20" W
200.60'

208.84

SURVEY FOR
RALPH COOK & CRYSTAL SPRINGS PACKING CO., INC.
LOCATED IN:
LOT NO. 13, CREST BROOK ORCHARD TRACTS
LOTS 1-10, FAIR OAKS ORCHARD TRACTS
D.L.C. NO. 58, SEC. 27, T.37S, R.I.W.M.
BY: MARK E. BOYDEN
FEB. 1959

REGISTERED
OREGON
LAND SURVEYOR

NOVEMBER 7, 1951
MARK E. BOYDEN
201

CECIL
INCORPORATED
MAR 1951