
## MAP OF SURVEY

LOCATED IN THE NORTHEAST QUARTER. SECTION 34, TOWNSHIP 34 SOUTH, RANGE I WEST, W. M., JACKSON COUNTY, OR.

ENVIRONMENTAL TIMBER MANAGEMENT SURVEY FOR 11232 HWY. 62 EAGLE POINT, OR. 97524

SURVEY BY ARTHUR R. RAMBO 735 VISTA PARK DRIVE EAGLE POINT, OR. 97524

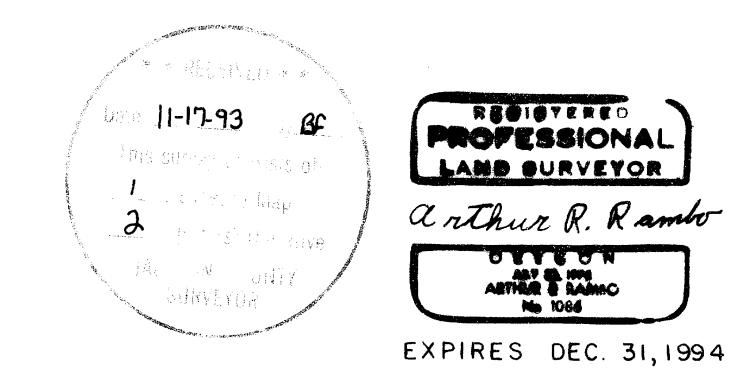

DATE NOVEMBER 12, 1993

BASIS OF BEARING RECORD SURVEY 12900

Set 5/8" x 30" Rebar With 2" Alum. Cap Marked LS 1086 (See Narrative)

Line Marked This Survey

1/4 COR. (GOV'T REC= EAST 2643.96) FD. I"G. I. PIPE S89° 41' 56" F WITH BR CAP EXP. 2" (C.S.1978) EXP. 8" (C.S.1974) 1327.40 1327. 40 ≃E 1/16 COR NORT S89°54′36″E S89°54'36"E' ≶ 1323.19 1323.19 SCALE 1" = 500' CN 1/16 COR. NE 1/16 COR. N 1/16 COR. 2640 = 4 0 33 CTR I/4 COR. \_C E 1/16COR. 34 N 89° 52′ 38″ E N89°52'38"E N89° 52′ 38″ E 2645.50 1319.00 35 I/4 COR. FD. I'G.I. PIPE WITH BR. CAP EXP 4" (C. S. 1978) 1/4 COR. | 34 FD. 1" G.I. PIPE WITH BR. CAP (C.S. 1989) 1319.00 (R.S. 12900 N89° 52' 45" E 2645.34') (R.S. 12900 N89°52'45"E 2637. 27') (R.S LEGEND  $\bigcirc$ Found Brass Cap Monument as Noted 43" W

0 O N

<u>o</u>\_

43"W

2656, 23')

1/4 COR.

FD. 1" G. I PIPE WITH BR. CAP EXP 8"(C.S. 1974)

TAX LOT 34 IW 34 - 800 -


AT THE EAST ONE-SIXTEENTH CORNER COMMON TO SECTIONS 27 AND 34, TOWNSHIP 34 SOUTH, RANGE 1 WEST, I SET A 5/8 BY 30 INCH IRON PIN WITH A 2 INCH DIAMETER ALUMINUM CAP, EXPOSED 11 INCHES MARKED:

T34S R1W S27 E + 1/16 S34 LS 1086

## FROM WHICH:

A 6 1/2 INCH DIAMETER MADRONA BEARS N20°09'28"W, 22.3 FEET MARKED E1/16S27 IN THE UPPER FACE, BT IN THE LOWER FACE.

AN 8 1/2 INCH DIAMETER MADRONA BEARS \$54°07'40"W, 23.4 FEET MARKED E1/16S34 IN THE UPPER FACE, BT IN THE LOWER FACE.

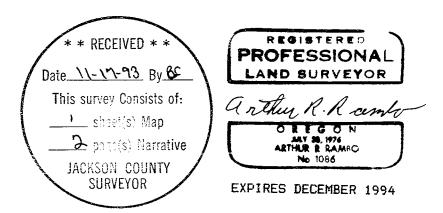

## SURVEY NARRATIVE TO COMPLY WITH O.R.S. 209.250

LOCATION:

NORTH EAST QUARTER SECTION 34, TOWNSHIP 34 SOUTH,

RANGE 1 WEST, JACKSON COUNTY, OREGON.

SURVEY FOR:

ENVIRONMENTAL TIMBER MANAGEMENT

11232 HWY. 62

EAGLE POINT, OREGON, 97524

SURVEY BY:

ARTHUR R. RAMBO

LS 1086

735 VISTA PARK DRIVE

EAGLE POINT, OREGON 97524

DATE

NOVEMBER 12, 1993

BASIS OF BEARING: SURVEY #12900

PURPOSE:

TO SET THE EAST 1/16 CORNER COMMON TO SECTIONS 27 AND 34, AND THE NORTHEAST 1/16 CORNER SECTION 34 TOWNSHIP 34 SOUTH RANGE 1 WEST. TO MARK THE LINE FROM THE NORTH 1/4 CORNER SECTION 34 TO THE EAST 1/16 CORNER COMMON TO SECTIONS 27 AND 34, AND THE LINE FROM THE EAST 1/16 CORNER COMMON TO SECTIONS 27 AND 34 TO THE NORTH EAST 1/16 CORNER SECTION 34.

PROCEDURE:

SEARCH OF THE RECORDS REVEALED THAT THE JACKSON COUNTY SURVEYOR HAD REMONUMENTED ALL OF THE EXTERIOR CORNERS OF SAID SECTION 34 NEEDED FOR CONTROL OF THIS SURVEY. I RAN A TRAVERSE TYING TO THE NORTH 1/4 CORNER, WEST 1/4 CORNER, THE SOUTH 1/4 CORNER, THE EAST 1/4 CORNER, AND THE NORTH EAST SECTION CORNER OF SAID SECTION 34. ALL ANGLES AND DISTANCES WERE DOUBLE MEASURED, THEN CALCULATED SUBDIVISION OF NORTH EAST QUARTER OF SAID SECTION 34. I THEN RAN LINES AND SET CORNERS AS SHOWN ON THE PLAT TO ACCOMPANY THIS NARRATIVE.

## CORNERS SET THIS SURVEY

ALL MEASUREMENTS TO TREES ARE TO THE CENTER OF THE TREE AT THE BASE UNLESS OTHERWISE STATED. ALL TREES MARKED THIS SURVEY HAVE A BRASS WASHER MARKED LS 1086 NAILED TO LOWER FACE.

AT THE NORTH EAST ONE- SIXTEENTH CORNER SECTION 34, TOWNSHIP 34 SOUTH RANGE 1 WEST, I SET A 5/8 BY 30 INCH IRON PIN WITH A 2 INCH DIAMETER ALUMINUM CAP EXPOSED 8 INCHES MARKED:

T34S R1W S34 NE+1/16 LS 1086

FROM WHICH:

A 5 INCH DIAMETER MADRONA BEARS N71°55'10"E, 10.9 FEET MARKED NE1/16S34 IN UPPER FACE, BT IN LOWER FACE.

A 10 INCH DIAMETER OAK BEARS N61°41'30"W, 13.4 FEET MARKED NE1/16S34 IN THE UPPER FACE, BT IN THE LOWER FACE.