

14025

Survey for
LeRoy Kobza
P.O. Box 211
Eagle Point, Oregon
97524

Location
SW 1/4 Section 27 and the
SE 1/4 of Section 28,
T.35S., R.1E., W.M.,
Jackson County, Oregon

Survey by
Kaiser Surveying
19440 Highway 62
Eagle Point, Oregon
97524

Date
May 17, 1994



Scale: 1" = 100'

Legend

S.N. = Filed Survey Number
(County Surveyors Office)

W.C. = Witness Corner


REGISTERED
PROFESSIONAL
LAND SURVEYOR

G. D. K.

OREGON
JULY 18, 1987
GARY D. KAISER
NO. 803

Exp. 6-30-95

** RECEIVED **
Date ~~5-20-94~~ By ~~BF~~
This survey consists of:
1 sheet(s) Map
1 page(s) Narrative
JACKSON COUNTY
SURVEYOR

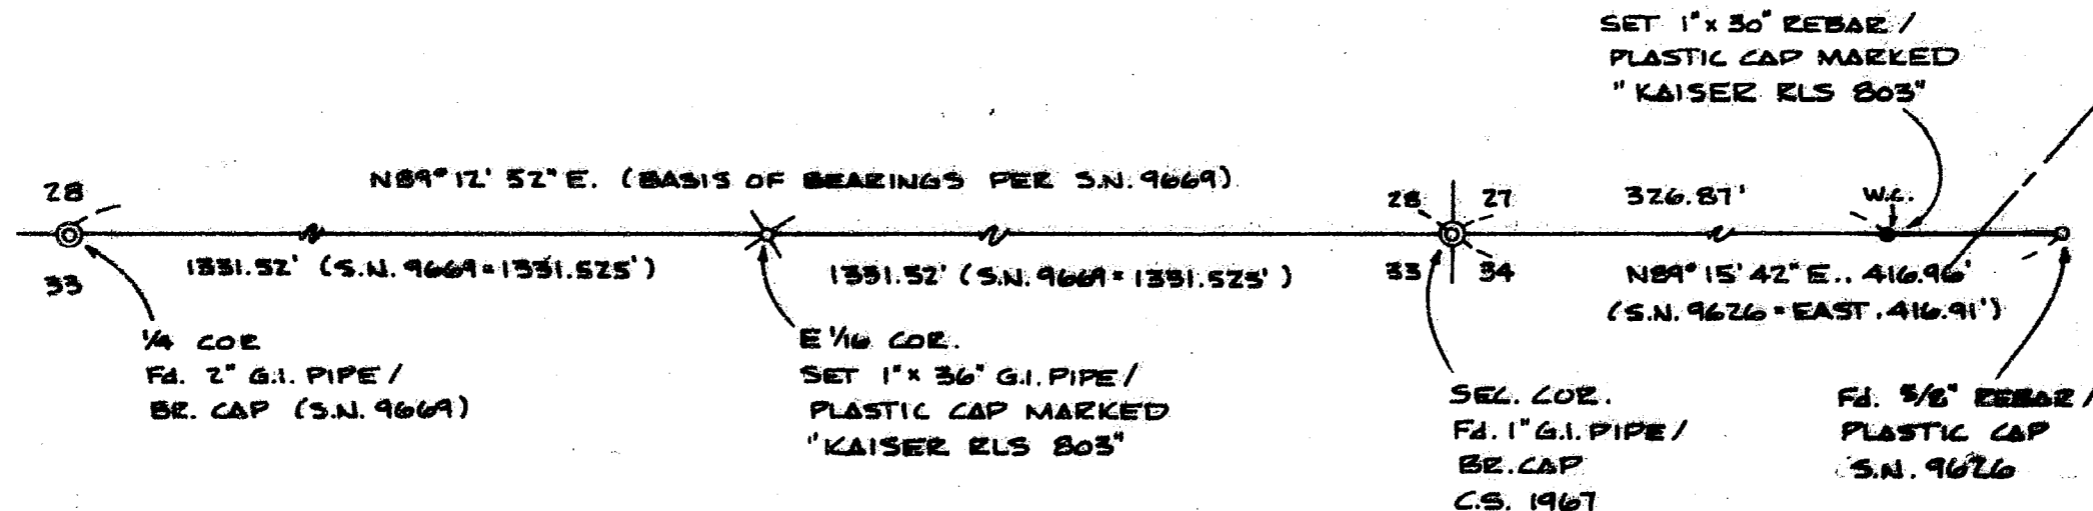

T.L.No. 351E (28) - 9304

14025

GARY D. KAISER
R.P.L.S. ORE. 803
C.W.R.E. ORE. 73

KAISER SURVEYING
19440 HIGHWAY 62
EAGLE POINT, OREGON 97524

PHONE
SHADY COVE (503) 878-3995
Fax (503) 878-3995

SURVEY NO. 14025

SURVEY NARRATIVE TO COMPLY WITH O.R.S. 209.250

SURVEY FOR: LEROY KOBZA
P.O. BOX 211
EAGLE POINT, OR 97524

SURVEY BY: KAISER SURVEYING
19440 HWY. 62
EAGLE POINT, OR 97524

LOCATION: SW ¼ of Section 27 and the SE ¼ of
Section 28, T. 35 S., R. 1 E., W.M.,
Jackson County, Oregon

BASIS OF BEARINGS: Filed Survey No. 9669 (South bdry.
Section 28)

DATE: May 17, 1994

PURPOSE: To set the E 1/16 corner common to
Sections 28 and 33 and to set a
witness corner near the
Northwesterly right-of-way line of
Worthington Road. Also to mark the
South boundary of the clients
property from Worthington Road
Westerly to the South quarter corner
to Section 28 for fencing.

PROCEDURE: Utilizing EDM equipment, traversed
between found monuments as shown on the annexed map and set
monuments as shown.

At the East-onesixteenth corner common to Sections 28
and 33 set a 1" x 36" G.I. pipe exp. 5" with a plastic cap
marked "Kaiser RLS 803" from which:

A 8" white oak scribed "E 1/16 S 33-BT" bears S 25° 36'
E, 12.2 feet

A 9" white oak scribed "E 1/16 S 28-BT" bears N 46° 46'
W, 15.8 feet

A ½" rebar (origin unknown) bears S 44° 10' E, 18.09'

** RECEIVED **
Date 5-20-94 By GC
This survey Consists of:
1 sheet(s) Map
1 page(s) Narrative
JACKSON COUNTY
SURVEYOR

REGISTERED
PROFESSIONAL
LAND SURVEYOR
G. D. Kaiser
OREGON
JULY 16, 1967
GARY D. KAISER
No. 803
EXP 6-30-95