


NARRATIVE:

I FOUND A BRASS CAP FOR THE 1/4 CORNER COMMON TO SECTIONS 8 AND 9 TOWNSHIP 37 SOUTH, RANGE 2 WEST, WILLAMETTE MERIDIAN, JACKSON COUNTY, OREGON AND A 5/8" IRON ROD FOR THE SOUTHEAST CORNER OF GOVERNMENT LOT 2 PER RECORD SURVEY 5772. I ALSO FOUND A 5/8" IRON ROD ON THE SECTION LINE NORTH OF THE 1/4 CORNER AS PER BOUNDARY LINE AGREEMENT VOLUME 399, PAGE 172. USING THESE I ESTABLISHED THE PARCEL AT RECORD DISTANCE NORTH ON THE SECTION LINE AND RECORD DISTANCE EAST, HOLDING THE EAST LINE PARALLEL TO THE SECTION LINE AND THE NORTH AND SOUTH LINES PARALLEL TO THE SOUTH LINE OF THE NORTHWEST 1/4 OF SECTION 9. THE OWNER OF THE PARCEL TO THE SOUTH TOLD ME THAT HE HAD PLACED 2" PIPE FENCE POST OVER THE 5/8" IRON RODS ON HIS NORTH LINE AS SHOWN ON RECORD SURVEY 5772 I FOUND THESE AS NOTED.

FIELD CREW: S. COREY, B. COREY, & R. PALMER
 EQUIPMENT: NIKON TOTAL STATION
 OFFICE: SAM COREY
 DRAFTING: TIM ADAMS

LEGEND:

- SET 5/8" x 30" IRON ROD w/CAP MKD "I.E.ENG."
- FD 5/8" IRON ROD UNLESS OTHERWISE NOTED
- △ CALCULATED POINT
- () RECORD DATA PER SURVEY 5772

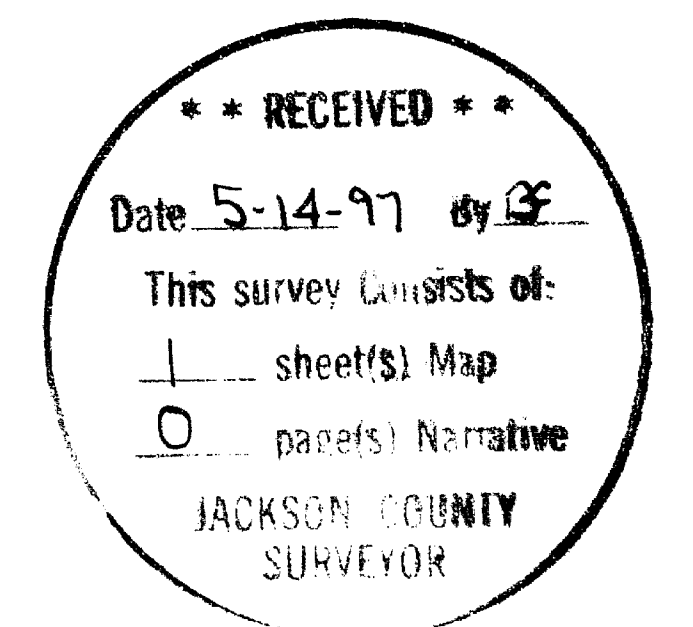

<p>REGISTERED PROFESSIONAL LAND SURVEYOR</p> <p><i>Donald A. Bentz</i></p> <p>OREGON JULY 12, 1988 DONALD A. BENTZ 839</p> <p>EXPIRES: 12/31/97</p>	<p>SURVEY</p> <p>IN THE NW1/4 OF SEC. 9, T37S, R2W, W.M., JACKSON COUNTY, OREGON</p>		
	<p>SURVEYED FOR: REBECCA A. LUEHANN 3498 OLD MILITARY RD. CENTRAL POINT, OREGON</p>	<p>SURVEYED BY: i.e. ENGINEERING</p> <p>548 S.E. Jackson Suite 3 Roseburg, Oregon 97470 PHONE (541) 673-0166 FAX (541) 440-9392</p>	
SCALE: 1" = 50'	DATE: MAY 1997	JOB NO.	PAGE: 1 OF 1