
ASSESSORS MAP FILE NO. 38 2W 12 TL 1101

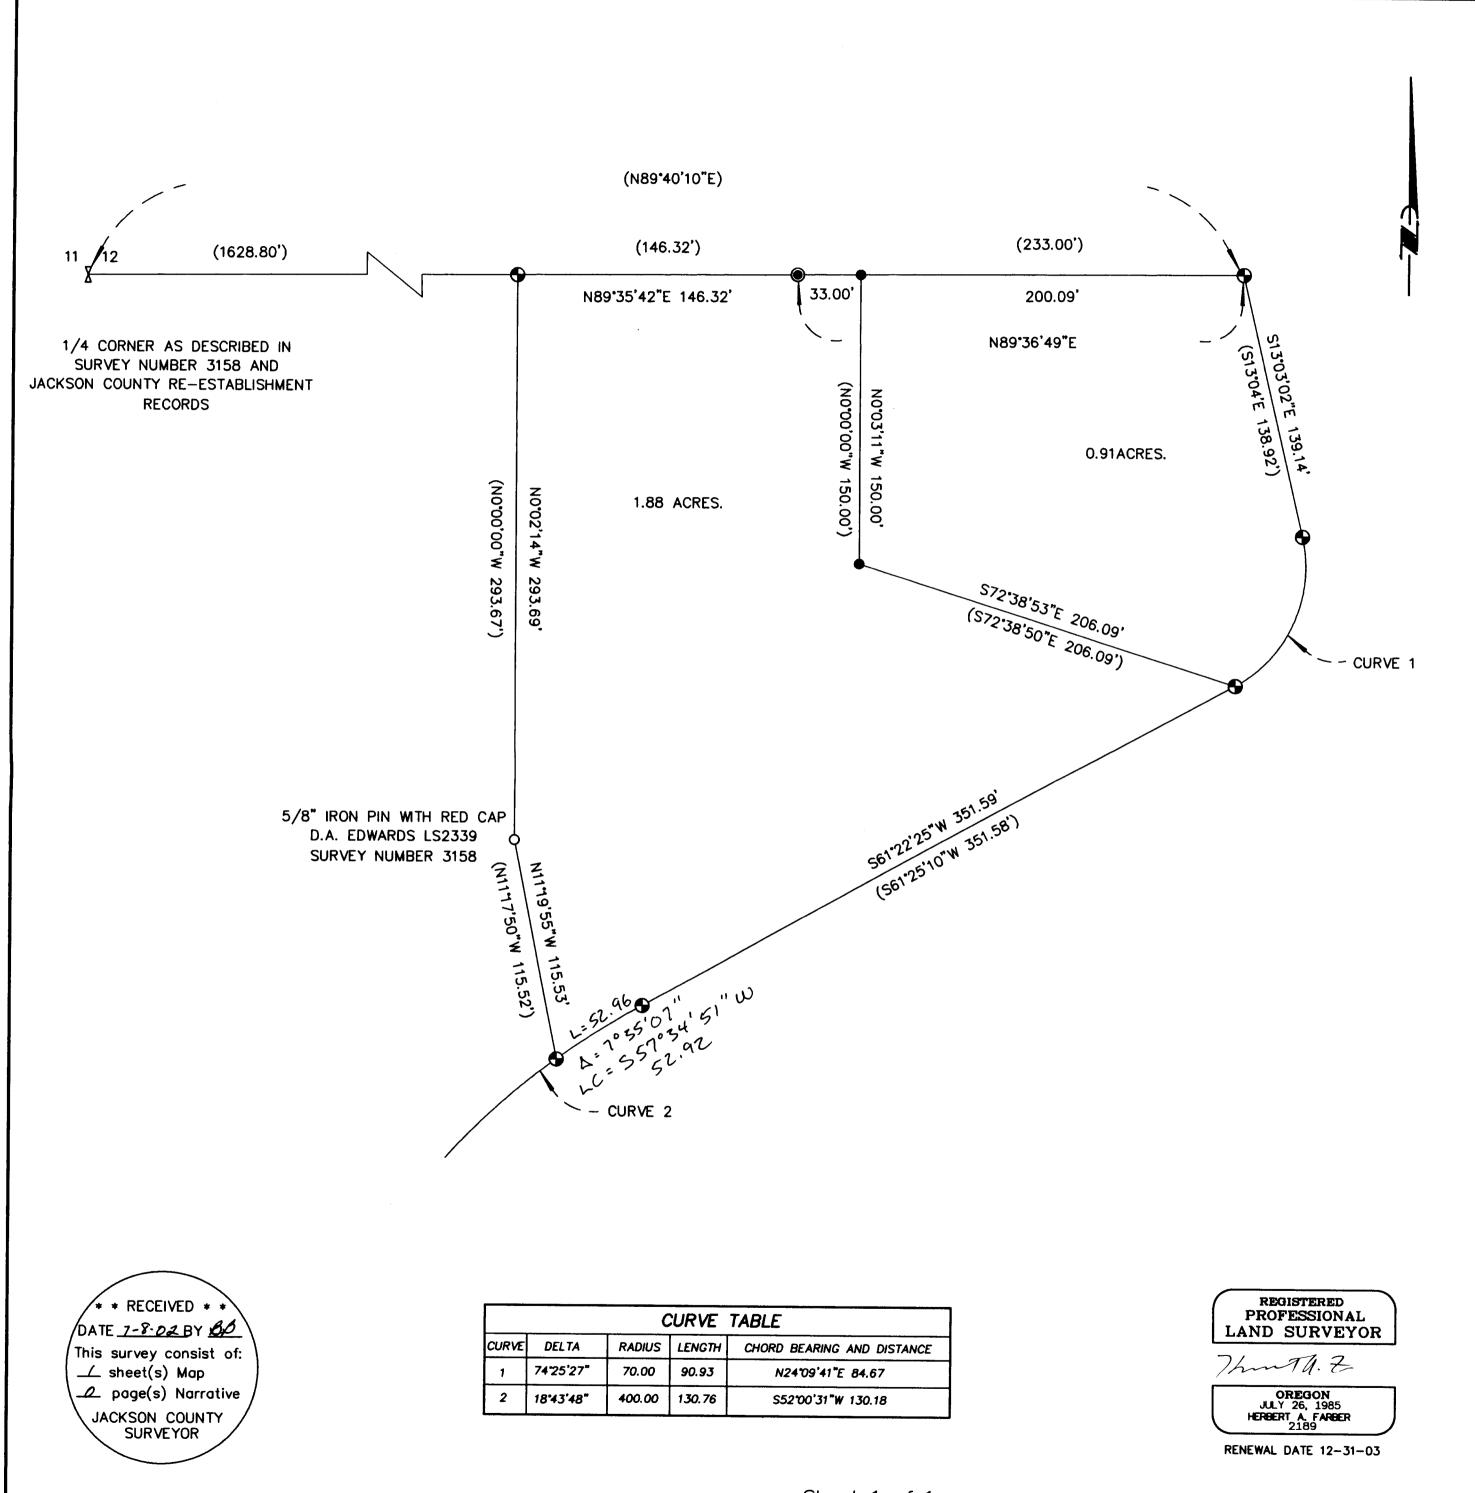

MAP OF SURVEY

located in

SOUTHWEST ONE QUARTER OF SECTION 12 TOWNSHIP 38 SOUTH, RANGE 2 WEST

WILLAMETTE MERIDIAN, JACKSON COUNTY, OREGON

LONNIE AND ANN HARPER

3450 DARRELL DRIVE MEDFORD, OREGON 97501

LEGEND

FOUND 2 1/2" BRASS CAP-1/4 SECTION CORNER

FOUND 5/8" IRON PIN, PER SURVEY 3158

FOUND 5/8" IRON PIN, AS DESCRIBED

FOUND 5/8" IRON PIN, PER SURVEY 2764

SET 5/8" x 24" IRON PIN w/ YELLOW PLASTIC CAP MARKED "FARBER PLS 2189"

S/N = RECORD FILED SURVEY NUMBER

- BASIS OF BEARING IS TRUE NORTH, NAD 83/91 DATUM, AS DERIVED BY GLOBAL POSITIONING SYSTEM OBSERVATIONS.

- RECORD SURVEY DATA IS SHOWN IN PARENTHESIS ADJACENT TO MEASURED SURVEY DATA WHERE APPLICABLE PER SURVEY 3158

- INST. No. = INSTRUMENT NUMBER AS RECORDED IN THE OFFICIAL RECORDS OF JACKSON COUNTY, OREGON.

SURVEY NARRATIVE TO COMPLY WITH O.R.S. 209.250

PURPOSE:

TO SURVEY AND MONUMENT THE BOUNDARY LINE BETWEEN TAX LOT NUMBER 1101 AND 1102 PER INSTRUMENT NUMBER 84-16373

PROCEDURE:

A CLOSED TRAVERSE WAS PERFORMED TO TIE IN EXISTING MONUMENT SHOWN HERE. A DISTANCE DISTANCE INTERSECTION WAS USED TO CALCULATE THE PROPERTY LINE. MONUMENTS WERE SET PER THIS PROCEDURE.

Surveyed by: FARBER & SONS, INC. dba FARBER SURVEYING (541) 776-0846

OFFICE LOCATION: 120 MISTLETOE MEDFORD, OREGON 97501

MAILING ADDRESS: P.O. BOX 5286 CENTRAL POINT, OREGON 97502

1" = 50' SCALE: DATE: JULY 5, 2002 JOB NO.: 1071-02

DRAWING FILE: JOBS\MEDFORD_SW\HARPER-DARRELL DRIVE\MAP OF SURVEY.FLX

Sheet 1 of 1