
ASSESSORS MAP NO. 38 2W 33 TL 107, 111

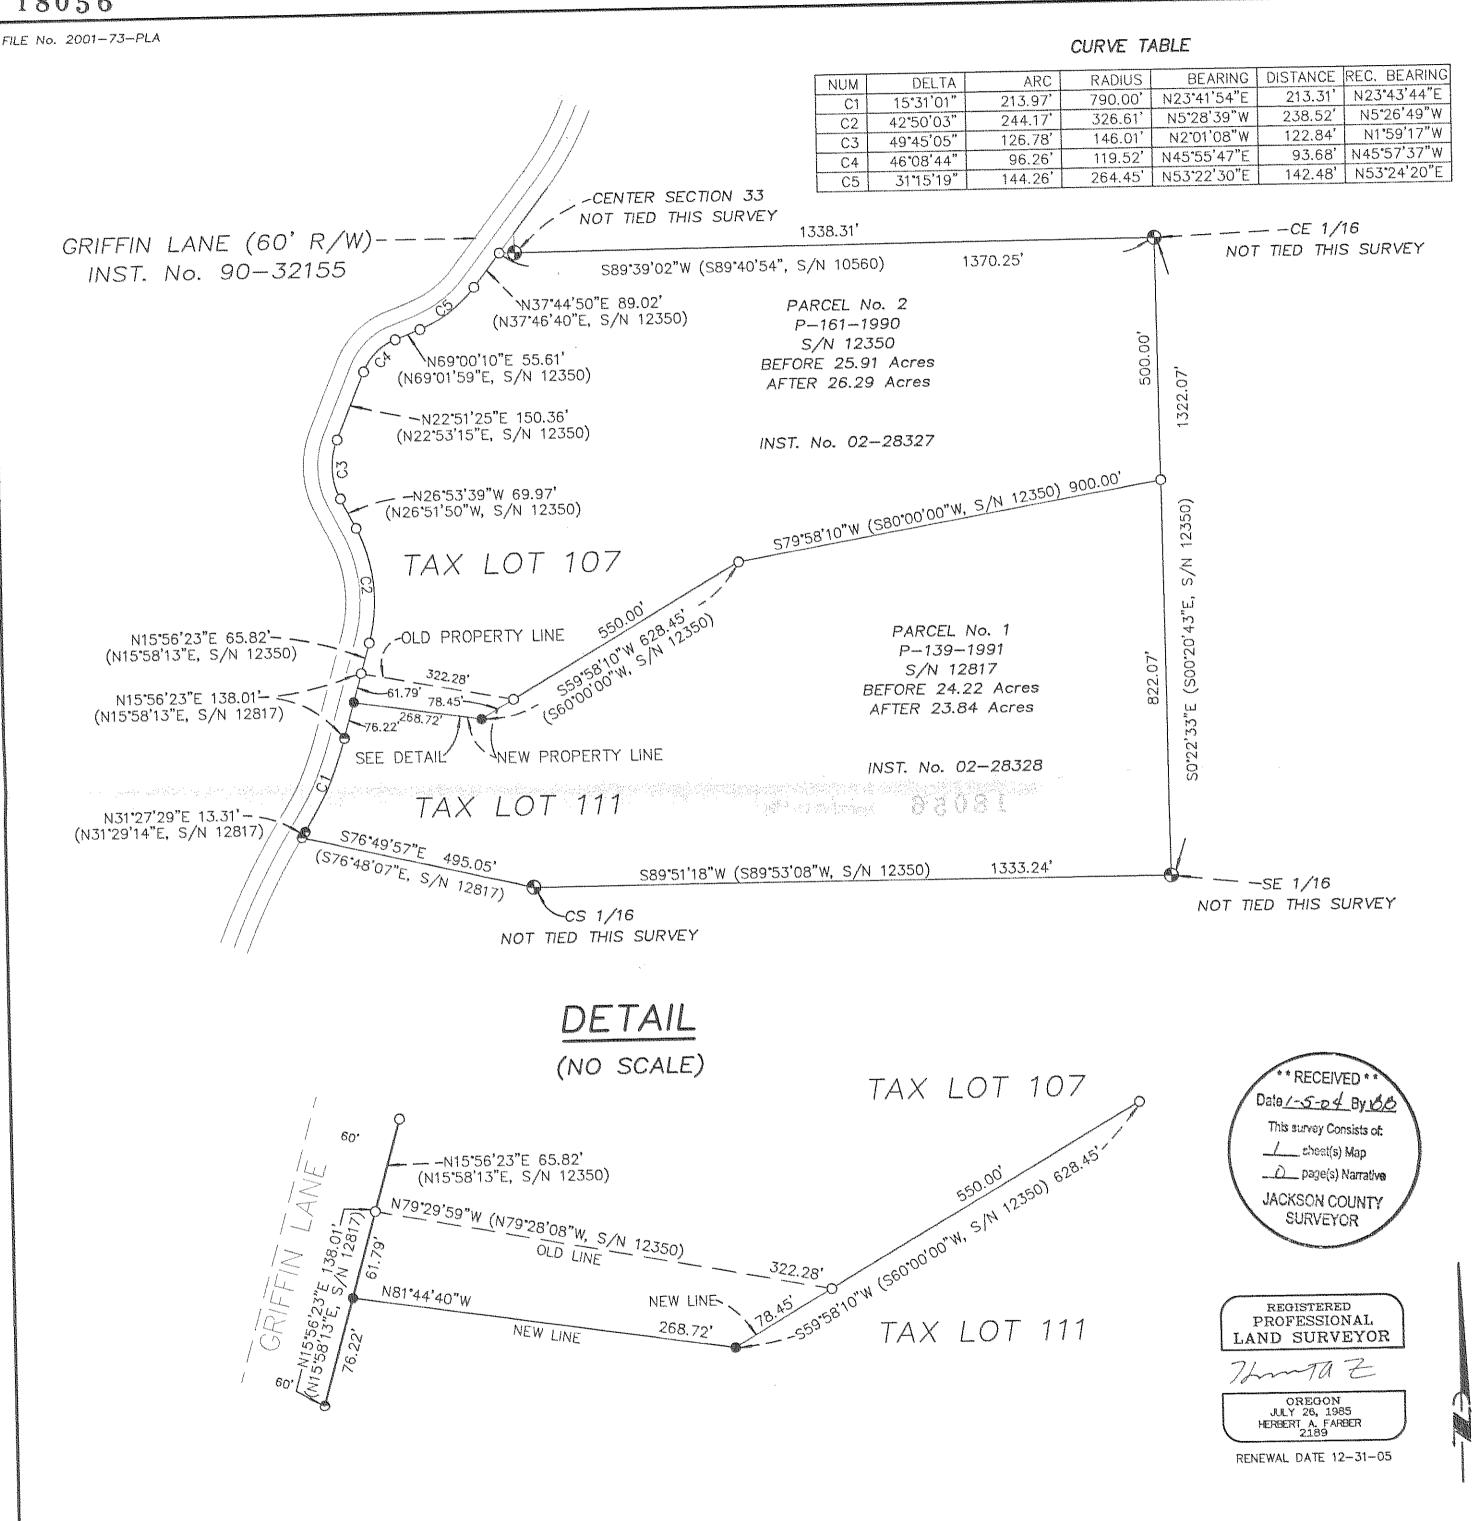

Sheet 1 of 1

# MAP OF SURVEY PROPERTY LINE ADJUSTMENT

located in

NORTHWEST ONE—QUARTER OF SECTION 36, TOWNSHIP 38 SOUTH, RANGE 2 WEST, WILLAMETTE MERIDIAN, JACKSON COUNTY, OREGON

for

### TOM SHERWOOD

PO BOX 1810 JACKSONVILLE, OREGON 97530

and

## STERLING MINE PROPERTIES

c/o Larry Preston, CPA 823 WEST 8th STREET MEDFORD, OREGON 97501

### LEGEND

= FOUND 5/8" IRON PIN, S/N 12817, NOT TIED THIS SURVEY

) = FOUND 5/8" IRON PIN, S/N 12350, NOT TIED THIS SURVEY

FOUND 2 1/2" BRASS CAP PER BLM NOTES OF DEPENDENT RESURVEY OF SECTION 33 COMPLETED JULY 9, 1996.

SET 5/8" x 24" IRON PIN w/ YELLOW PLASTIC CAP MARKED "FARBER PLS 2189"

S/N = COUNTY SURVEYOR FILE SURVEY NUMBER

R/W = RIGHT-OF-WAY

- BASIS OF BEARING IS TRUE NORTH, NAD 83/91 DATUM, AS DERIVED BY GLOBAL POSITIONING SYSTEM OBSERVATIONS.

- RECORD SURVEY DATA IS SHOWN IN PARENTHESIS ADJACENT TO MEASURED SURVEY DATA WHERE APPLICABLE.

- INST. No. = INSTRUMENT NUMBER AS RECORDED IN THE OFFICIAL RECORDS OF JACKSON COUNTY, OREGON.

#### SURVEY NARRATIVE TO COMPLY WITH O.R.S. 209.250

PURPOSE:

TO SURVEY AND MONUMENT THIS PROPERTY LINE ADJUSTMENT AS APPROVED BY JACKSON COUNTY FILE No. 2001-73-PLA AND DIRECTED BY THE CLIENT.

PROCEDURE:

UTILIZING CONTROL ESTABLISHED DURING PREVIOUS SURVEYS AND THIS SURVEY, I LOCATED THE AFFECTED PROPERTY AND MONUMENTED IT AS SHOWN HEREON.
THIS MAP WAS FOUND IN A PENDING FILE DRAWER AND IS NOW BEING FILED TO COMPLY WITH STATUTORY REQUIREMENTS.

Surveyed by: FARBER & SONS, INC. dba FARBER SURVEYING (541) 664-5599

431 OAK STREET P.O. BOX 5286 CENTRAL POINT, OREGON 97502

SCALE: DATE: JOB NO.: 1" = 200' JANUARY 18, 2002, REVISED JANUARY 5, 2003 0960-01

DRAWING FILE: JOBS\STERLING\MICROSURVEY\FINAL PLATS-SURVEYS\SHERWOOD\_MOS.FLX