
ASSESSORS MAP FILE NO. 37 2W 32BC TL 2500 & 2600

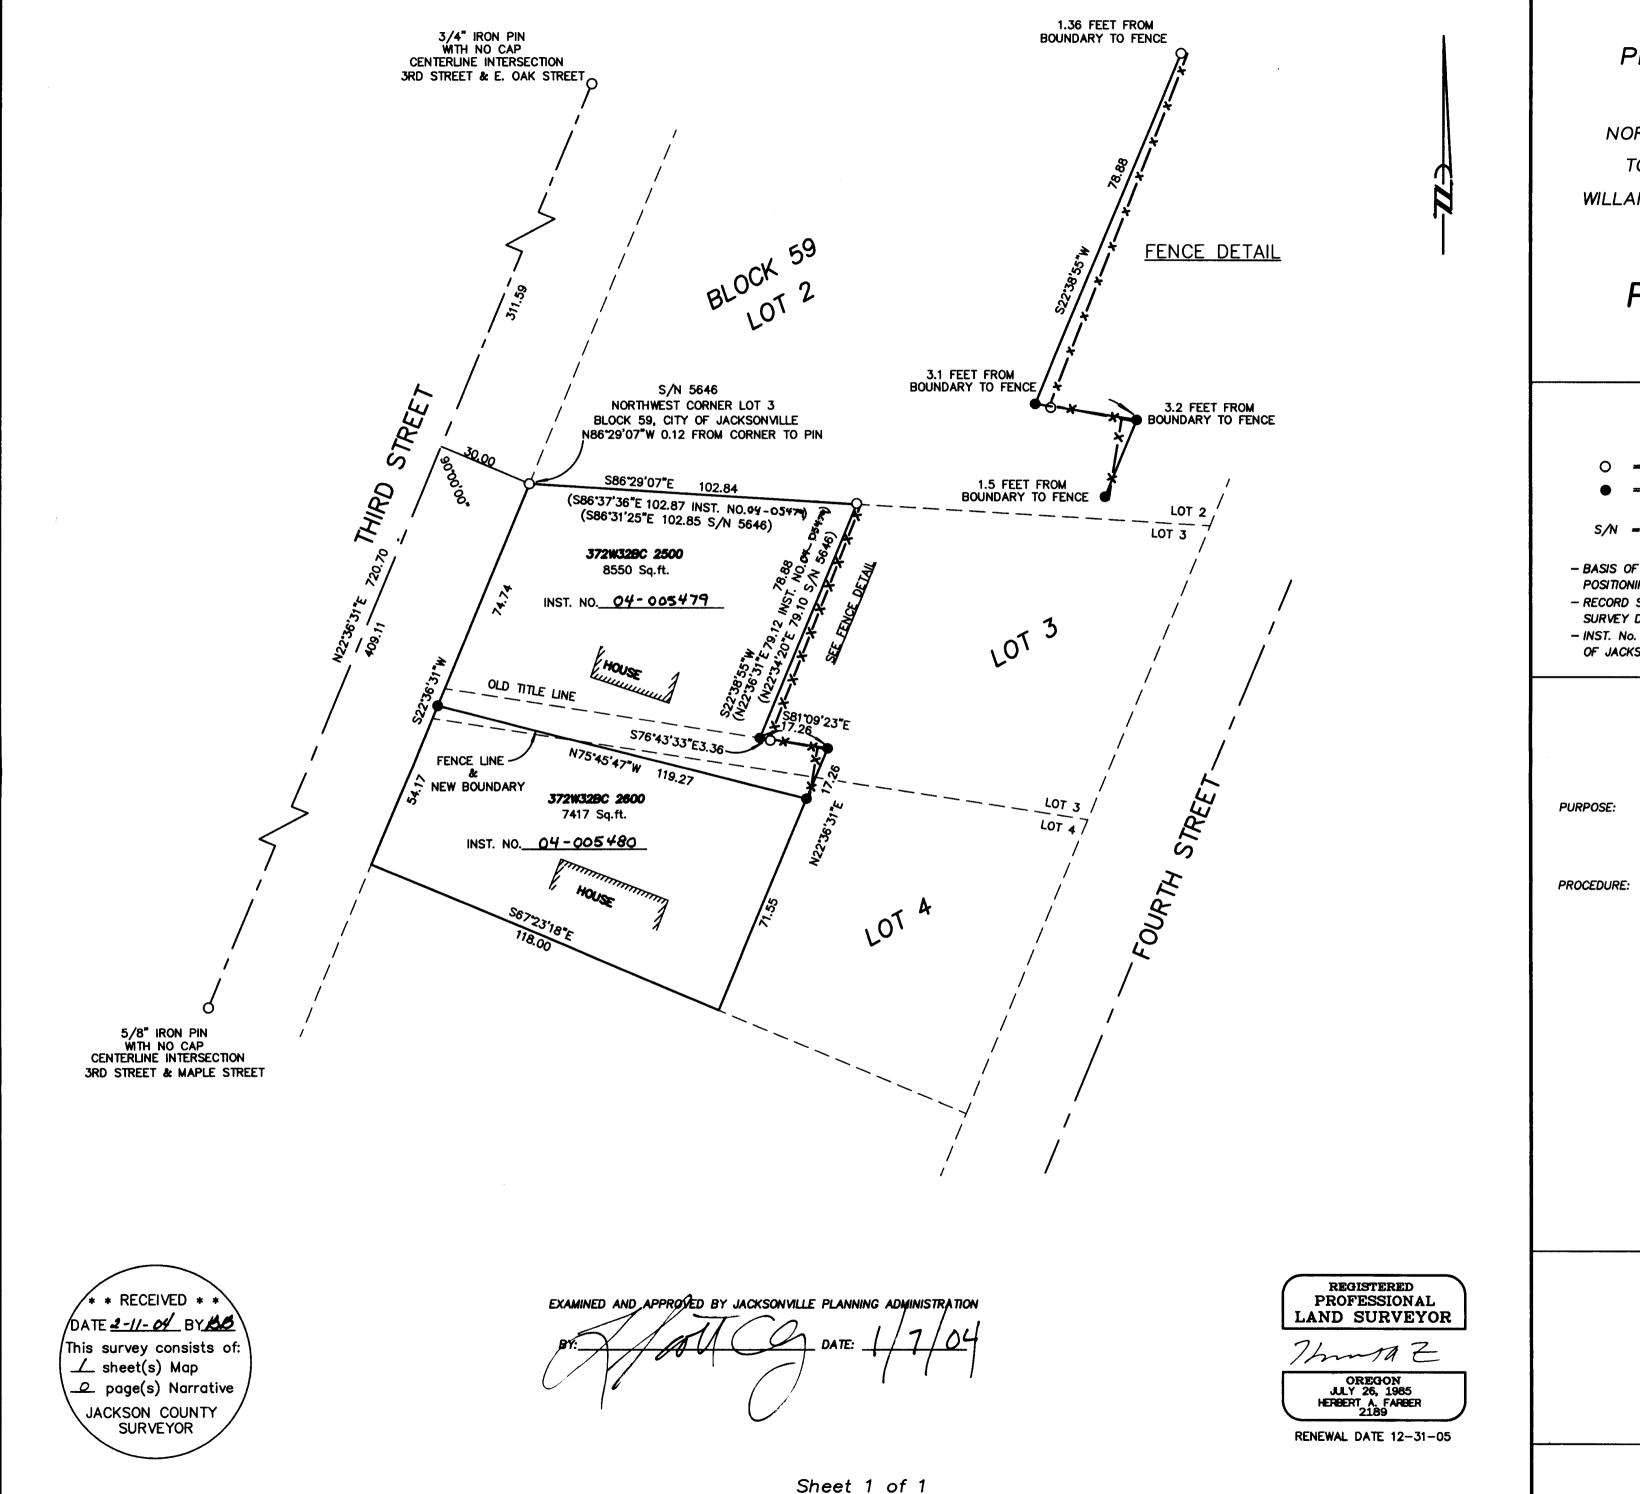

MAP OF SURVEY PROPERTY LINE ADJUSTMENT

located in the

NORTHWEST ONE QUARTER OF SECTION 32, TOWNSHIP 37 SOUTH, RANGE 2 WEST,

WILLAMETTE MERIDIAN, CITY OF JACKSONVILLE,

JACKSON COUNTY, OREGON

PAT & BILL HARDY

585 THIRD STREET JACKSONVILLE, OREGON 97530

LEGEND

= FOUND 5/8" IRON PIN, PER S/N 5646, OR AS DESCRIBED

= SET 5/8" x 24" IRON PIN w/ YELLOW PLASTIC CAP MARKED "FARBER PLS 2189"

S/N - RECORD FILED SURVEY NUMBER

- BASIS OF BEARING IS TRUE NORTH, NAD 83/91 DATUM, AS DERIVED BY GLOBAL POSITIONING SYSTEM OBSERVATIONS.

- RECORD SURVEY DATA IS SHOWN IN PARENTHESIS ADJACENT TO MEASURED SURVEY DATA WHERE APPLICABLE.

- INST. No. = INSTRUMENT NUMBER AS RECORDED IN THE OFFICIAL RECORDS OF JACKSON COUNTY, OREGON.

SURVEY NARRATIVE TO COMPLY WITH O.R.S. 209.250

TO SURVEY AND MONUMENT THE PROPERTY LINE ADJUSTMENT APPROVED BY THE CITY OF JACKSONVILLE ON NOVEMBER 17, 2003

USING CONTROL ESTABLISHED IN THIS AND PREVIOUS SURVEYS, I TIED EXISTING MONUMENTS AND FENCE LINES. THE BOUNDARY LINE WAS ESTABLISHED BY A QUIT CLAIM DEED FILED AS INST. NO. 03-44937. AN APPICATION WAS THEN FILED FOR A PROPERTY LINE ADJUSTMENT TO THE CITY OF JACKSONVILLE. NEW DEEDS WERE WRITTEN DESCRIBING THE ADJUSTED PARCEL WHICH ARE MAPPED HEREON.

Surveyed by:

FARBER & SONS, INC. dba FARBER SURVEYING (541) 664-5599

431 OAK STREET P.O.BOC 5286 CENTRAL POINT, OREGON 97502

SCALE: DATE: JOB NO.: 1'' = 30'JANUARY 5, 2004

1175-03 DRAWING FILE: JOBS\Jacksonville\Hardy\MOS.FLX