Jackson County Official Records 2004-015572 R-AF
Cnt=1 Sin=1 AVGERICN 03/25/2004 12:18:51 PM

Cnt=1 Stn=1 AVGERICN 03/25/2004 12:18:51 PM \$10.00 \$5.00 \$11.00 Total:\$26.00



Kathleen S. Beckett, County Clerk for Jackson County, Oregon, certify that the instrument identified herein was recorded in the Clerk records.

Kathleen S. Beckett - County Clerk

18187

AFFIDAVIT OF MONUMENTATION FOR DEFERRED MONUMENTS

KNOW ALL MEN BY THESE PRESENTS, that I, BARY D. KAISER, a duly Registered Professional Land Surveyor of the State of the State of Oregon, do hereby affirm that I have established with proper monuments as required by law those monuments shown as deferred on the Official Plat of <u>GREENMOOR ESTATES SUBDIVISION</u>, as recorded in Volume 30, page 11 of Plats in Jackson County, Oregon. The deferred lot corner monuments are a 5/8 inch by 24 inch rebar with a plastic orange cap marked "B. KAISER RLS 52923". Witness corner monuments were set along the Alta Vista Road right-of-way line due to a new fence, which was constructed on the line. See Map Exhibit "A" to this affidavit, which shows witness corner locations. Deferred street centerline monuments are 5/8" x 30" rebars with aluminum caps stamped, "B. KAISER RLS 52923".

This Affidavit is to comply with Chapter 92.070 of the Revised Statutes of the State of Oregon.

IN WITNESS HEREOF, signed this 23rd day of March, 2004.

This survey Consists of:

Skeet(s) Map

page(s) Namative

JACKSON COUNTY

SUFFVEYOR

PROFESSIONAL LAND SURVEYOR

Boy D King

O R E G O N JULY 15, 2003 BARY D. KAISER No. 52923

6-30-05

STATE OF OREGON)
)ss
COUNTY OF JACKSON)

This instrument was acknowledged before me on this 2374 day of March, 2004, by BARY D. KAISER, a Registered Professional Land Surveyor, and acknowledged the foregoing

instrument to be his voluntary act and deed.

That les molt

NOTARY

OFFICIAL SEAL
GRETCHEN MELOTH
NOTARY PUBLIC - OREGON
COMMISSION NO. 353650
NY COMMISCH ETPRES JANUARY 18, 2008

Examined and approved this 25th day of March, 2004.

JACKSON COUNTY SURVEYOR

EXHIBIT "A"

PREPARED FOR:

Southern Oregon Development, LLC 2009 Aero Way, Suite 105 Medford, OR. 97504

LOCATION:


GREENMOOR ESTATES SUBDIVISION City of Eagle Point, Jackson County, Oregon PREPARED BY:

Kaiser Surveying 19440 Hwy. 62 Eagle Point, OR. 97524

DATE:

March 19, 2004

SCALE 1" = 100'

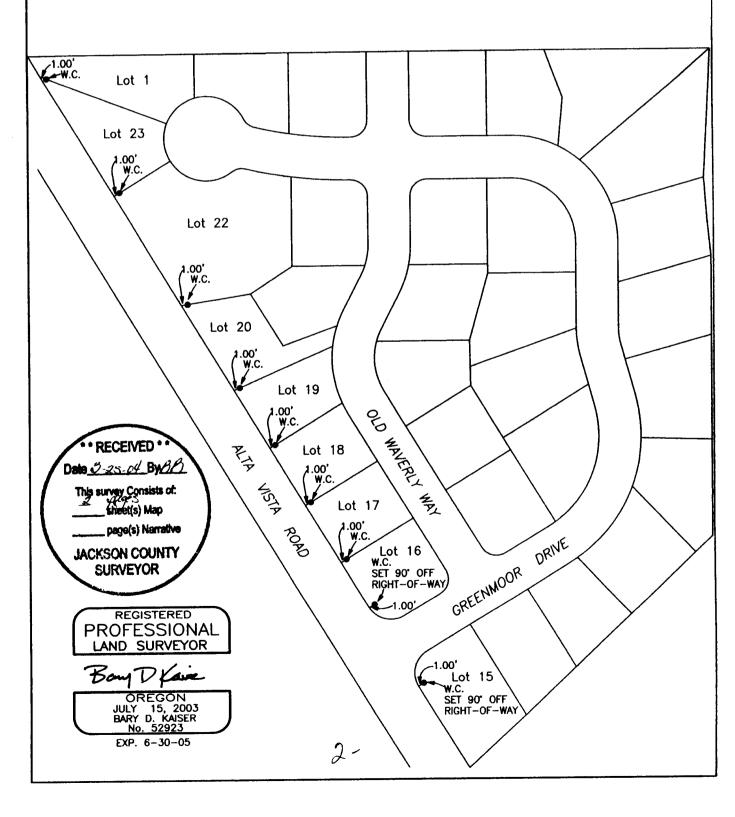

Jackson County Official Records 2004-015572 Cnt=1 Stn=1 AVGERICN 03/25/2004 12:18:51 PM \$10.00 \$5.00 \$11.00 Total:\$26.00



Kathleen S. Beckett - County Clerk

18187

AFFIDAVIT OF MONUMENTATION FOR **DEFERRED MONUMENTS**

KNOW ALL MEN BY THESE PRESENTS, that I, BARY D. KAISER, a duly Registered Professional Land Surveyor of the State of the State of Oregon, do hereby affirm that I have established with proper monuments as required by law those monuments shown as deferred on the Official Plat of GREENMOOR ESTATES SUBDIVISION, as recorded in Volume 30, page 11 of Plats in Jackson County, Oregon. The deferred lot corner monuments are a 5/8 inch by 24 inch rebar with a plastic orange cap marked "B. KAISER RLS 52923". Witness corner monuments were set along the Alta Vista Road right-of-way line due to a new fence, which was constructed on the line. See Map Exhibit "A" to this affidavit, which shows witness corner locations. Deferred street centerline monuments are 5/8" x 30" rebars with aluminum caps stamped, "B. KAISER RLS 52923".

This Affidavit is to comply with Chapter 92.070 of the Revised Statutes of the State of Oregon. IN WITNESS HEREOF, signed this 23rd day of March, 2004.

> * RECEIVED * * Date 3-25-c4 By This survey Consists of: STIES (S) Map page(s) Narrative JACKSON COUNTY SURVEYOR

PROFESSIONAL **LAND SURVEYOR**

D Kin OREGON JULY 15, 2003 BARY D. KAISER No. 52923

6-30-05

STATE OF OREGON) COUNTY OF JACKSON)

This instrument was acknowledged before me on this 23rd day of March 2004, b BARY D. KAISER, a Registered Professional Land Surveyor, and acknowledged the foregoing , 2004, by

instrument to be his voluntary act and deed.

Examined and approved this 25th day of March, 2004.

EXHIBIT "A"

SCALE 1" = 100'

PREPARED FOR:

Southern Oregon Development, LLC 2009 Aero Way, Suite 105 Medford, OR. 97504

LOCATION:

GREENMOOR ESTATES SUBDIVISION City of Eagle Point, Jackson County, Oregon

PREPARED BY:

Kaiser Surveying 19440 Hwy. 62 Eagle Point, OR. 97524

DATE:

March 19, 2004

