
REGISTERED PROFESSIONAL LAND SURVEYOR

Thurtat OREGON JULY 26, 1985 HERBERT A. FARBER 2189

RENEWAL DATE 12-31-05

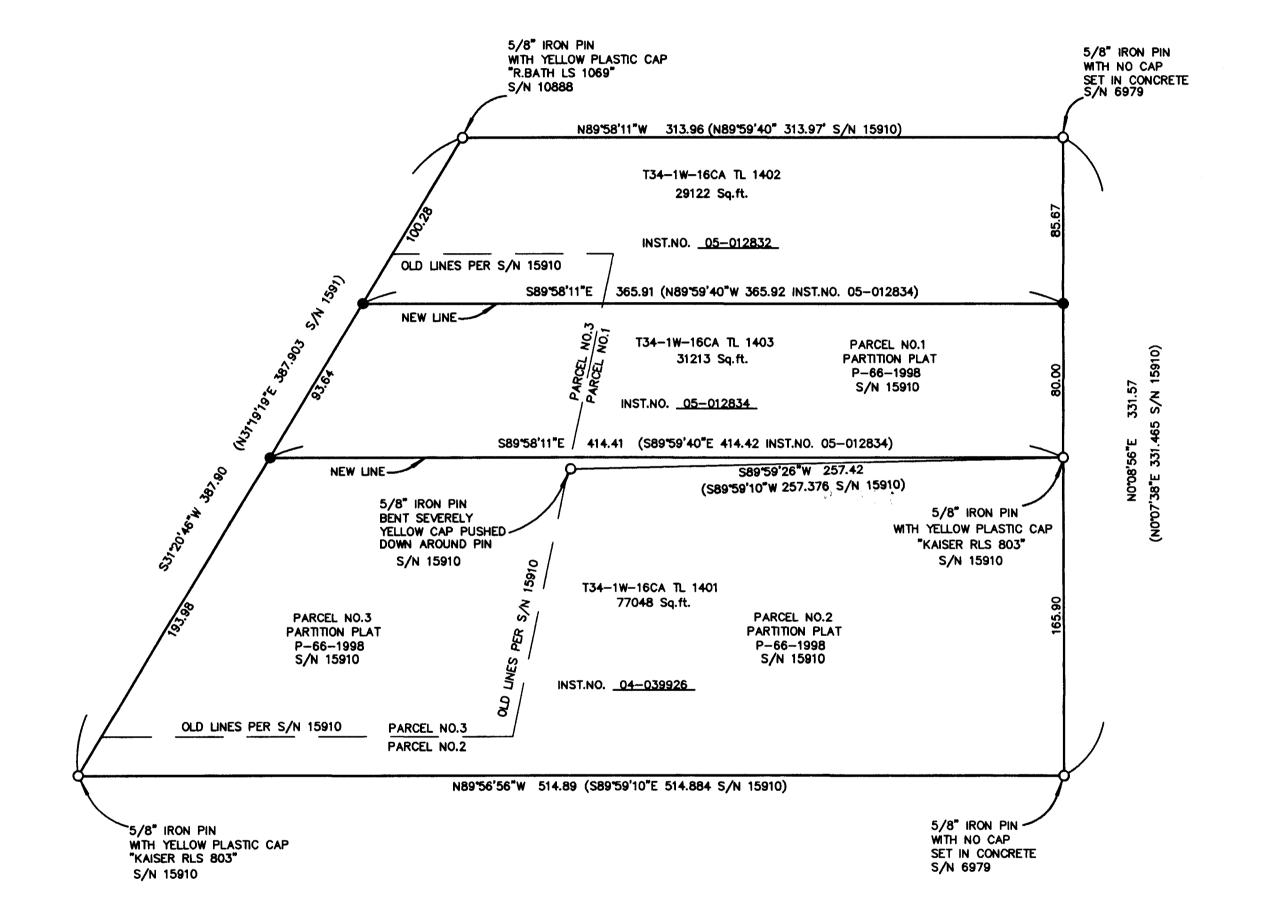

* RECEIVED * DATE 4-5-05 BY This survey consists of: _/ sheet(s) Map _____ page(s) Narrative JACKSON COUNTY SURVEYOR

ASSESSORS MAP FILE NO. 34 1W 16CA TL 1401,1402,1403

EXAMINED AND APPROVED BY THE CITY OF SHADY COVE

Sheet 1 of 1

MAP OF SURVEY PROPERTY LINE ADJUSTMENT

PARCELS 1,2, AND 3

PARTITION PLAT P-66-1998

located in the

SOUTHWEST ONE QUARTER OF SECTION 16, TOWNSHIP 34 SOUTH, RANGE 1 WEST, WILLAMETTE MERIDIAN, CITY OF SHADY COVE JACKSON COUNTY, OREGON

DEBRA CAM

P.O. BOX 3400 CENTRAL POINT, OREGON 97502

LEGEND

- = FOUND 5/8" IRON PIN AS DESCRIBED
- = SET 5/8" x 24" IRON PIN w/ YELLOW PLASTIC CAP MARKED "FARBER PLS 2189"
- S/N RECORD FILED SURVEY NUMBER
- BASIS OF BEARING IS TRUE NORTH, NAD 83/91 DATUM, AS DERIVED BY GLOBAL POSITIONING SYSTEM OBSERVATIONS.
- RECORD SURVEY DATA IS SHOWN IN PARENTHESIS ADJACENT TO MEASURED SURVEY DATA WHERE APPLICABLE.
- INST. NO. = INSTRUMENT NUMBER AS RECORDED IN THE OFFICIAL RECORDS OF JACKSON COUNTY, OREGON.

SURVEY NARRATIVE TO COMPLY WITH O.R.S. 209.250

PURPOSE:

TO SURVEY AND MONUMENT THE PROPERTY LINE ADJUSTMENT AS DIRECTED BY THE CLIENT.

PROCEDURE:

USING CONTROL ESTABLISHED IN PREVIOUS SURVEYS I TIED THE FOUND MONUMENTS AS SHOWN HEREON. ALL MONUMENTS, EXCEPT AS NOTED, WERE FOUND IN GOOD CONDITION AND THEIR POSITIONS WERE HELD; I THEN PROCEEDED TO MONUMENT THE ADJUSTED PROPERTY LINES AS INSTRUCTED BY THE CLIENT.

Surveyed by:

FARBER & SONS, INC. dba FARBER SURVEYING (541) 664-5599

PO BOX 5286 431 OAK STREET CENTRAL POINT, OREGON 97502

SCALE: 1" = 50' 100'

DATE: JOB NO.: APRIL 1, 2005

1252-04

DRAWING FILE: JOBS\SHADY COVE NE CO\CAM\MICROSURVEY\FINAL PLATS SURVEYS\MOS.FLX