### **DECLARATION**

KNOW ALL PERSONS BY THESE PRESENTS, THAT BARCLAY SQUARE CONDOMINIUM, LLC, AN OREGON LIMITED LIABILITY COMPANY, IS THE OWNER OF THE LANDS HEREON DESCRIBED IN THE ACCOMPANYING SURVEYOR'S CERTIFICATE AND DO HEREBY DECLARE THAT THE PROPERTY AND IMPROVEMENTS CALLED HEREIN, McCALL DRIVE CONDOMINIUM, ARE TRUE AND CORRECT, AND DO HEREBY COMMIT SAID PROPERTY TO THE OPERATION AND PROVISIONS OF THE OREGON CONDOMINIUM ACT. THE PROPERTY AND IMPROVEMENTS DESCRIBED AND DEPICTED ON THE PLAT ARE SUBJECT TO THE PROVISIONS OF OREGON REVISED STATUTES 100.005 TO 100.625. WE HEREBY CREATE A VARIABLE WIDTH EASEMENT TO THE CITY OF ASHLAND FOR THE PURPOSE OF TURN-AROUND ACCESS FOR FIRE APPARATUS AND EMERGENCY VEHICLES AS SHOWN HEREON.

EVAN ARCHERD, MANAGER

BARCLAY SQUARE CONDOMINIUM, LLC, AN OREGON LIMITED LIABILITY COMPANY

4	CITES	TOTT	-			-
A	CKI	veju	T.EI	<b>OGE</b>	мик	V I

STATE OF OREGON

JACKSON COUNTY

PERSONALLY APPEARED THE ABOVE NAMED EVAN ARCHERD, AS MANAGING MEMBER ON AUTHORITY OF BARCLAY SQUARE CONDOMINIUM, LLC, ON THIS 6 DAY OF 14 ALEGO , 2007 AND ACKNOWLEDGED THE FORGOING TO BE HIS VOLUNTARY (ACT AND DEED.

NOTARY SIGNATURE Janie G. Miller NOTARY PUBLIC - OREGON LOURIE A. Miller

COMMISSION NO. \_363080

MY COMMISSION EXPIRES Jan. 20, 2007

### SURVEYORS CERTIFICATE OF COMPLETION

IN ACCORDANCE WITH O.R.S. 100.115(2D), I, SHAWN KAMPMANN, A REGISTERED PROFESSIONAL LAND SURVEYOR, HEREBY CERTIFY THAT THE PLAT OF McCALL DRIVE CONDOMINIUM, FULLY AND ACCURATELY DEPICTS THE BOUNDARIES OF THE UNITS AND THE BUILDINGS AND THAT CONSTRUCTION OF THE UNITS AND BUILDINGS, AS DEPICTED ON SUCH PLAT, HAS BEEN COMPLETED.

I HEREBY CERTIFY THAT THIS PLAT IS AN EXACT COPY OF THE ORIGINAL.

REGISTERED **PROFESSIONAL** LAND SURVEYOR

Show Krongman OREGON

SHAWN KAMPMANN

RENEWAL DATE: 6/30/2007

Assessor's Map No. 391E11CC, Tax Lot 100

## McCALL DRIVE CONDOMINIUM

LOCATED IN

### PARCEL 1 OF PARTITION PLAT NO. P-05-2005

LYING SITUATE WITHIN

SOUTHWEST QUARTER OF SECTION 11, TOWNSHIP 39 SOUTH, RANGE 1 EAST, WILLAMETTE MERIDIAN, CITY OF ASHLAND, JACKSON COUNTY, OREGON

### ARCHERD & DRESNER, L.L.C.

550 EAST MAIN STREET ASHLAND, OREGON 97520

### SHEET INDEX

SHEET 1 SIGNATURE SHEET

SHEET 2 PLAT BOUNDARY

SHEET 3 PLAN VIEW - ELEVATIONS SHEET 4 PLAN VIEW - ELEVATIONS

### SURVEYOR'S CERTIFICATE

I, SHAWN KAMPMANN, DULY REGISTERED PROFESSIONAL LAND SURVEYOR IN THE STATE OF OREGON, DO HEREBY CERTIFY THAT I HAVE CORRECTLY SURVEYED AND MARKED WITH THE PROPER MONUMENTS AS PROVIDED BY LAW. THE TRACT OF LAND HEREON SHOWN, THIS SAID PLAT BEING A CORRECT REPRESENTATION OF THE SAME, AND THE FOLLOWING IS AN ACCURATE DESCRIPTION OF THE BOUNDARY LINES:

PARCEL NO. ONE (1) OF PARTITION PLAT NO. P-05-2005, RECORDED JANUARY 14, 2005 IN RECORD OF PARTITION PLATS IN JACKSON COUNTY, OREGON, AND FILED AS SURVEY NO. 18590 IN THE OFFICE OF THE JACKSON COUNTY SURVEYOR. EXCEPTING THEREFROM THAT PORTION DEEDED TO THE CITY OF ASHLAND BY WARRANTY DEED RECORDED AS INSTRUMENT NO. 2005-073293 IN THE OFFICIAL RECORDS OF JACKSON COUNTY.

### **SURVEY NOTE:**

THE FOLLOWING ENCURBRANCES DESCRIBED WITHIN FIRST AMERICAN TITLE INSURANCE COMPANY OF OREGON, ORDER NO. 7169-924262, DATED JANUARY 16, 2007, ARE EITHER BLANKET IN NATURE AND THEREFORE NOT SHOWN GRAPHICALLY ON THIS PLAT, OR ARE NOT APPLICABLE TO THE SUBJECT PROPERTY.

EASEMENT FOR THE TRANSMISSION AND DISTRIBUTION OF ELECTRICITY TO PACIFICORP, AN OREGON CORPORATION, RECORDED JANUARY 30, 1964 IN VOLUME 560, PAGE 360 OF THE DEED RECORDS OF JACKSON COUNTY, OREGON.

EASEMENTS, RIGHTS OR ACCESS BETWEEN THE RIGHT OF WAY OF THE RELOCATED GREENSPRINGS HIGHWAY AS DESCRIBED WITHIN INSTRUMENT NO. 72-07873 AND AMENDED BY INSTRUMENT NO. 75-12648 OF THE OFFICIAL RECORDS OF JACKSON COUNTY, OREGON.

EASEMENTS, RIGHTS OR ACCESS BETWEEN THE RIGHT OF WAY OF THE RELOCATED GREENSPRINGS HIGHWAY AS DESCRIBED WITHIN INSTRUMENT NO. 72-07874 OF THE OFFICIAL RECORDS OF JACKSON COUNTY, OREGON.

SANITARY SEWER EASEMENT TO THE CITY OF ASHLAND RECORDED APRIL 6, 1973 AS INSTRUMENT NO. 73-05083, OF THE OFFICIAL RECORDS OF JACKSON COUNTY, OREGON, AND EXTINGUISHED BY QUIT CLAIM DEED IN INSTRUMENT NO. 2007-001492 RECORDED ON JANUARY 10, 2007 IN SAID COUNTY.

OVERHEAD UTILITY LINES AS SHOWN ON THE RECORDED PLAT AND DECLARATION FOR BIRCHWOOD AT ASHLAND, A PLANNED COMMUNITY, IN VOLUME 25, PAGE 19 OF THE PLAT RECORDS RECORDS OF JACKSON COUNTY, OREGON AND FILED AS SURVEY NO. 16178 IN THE OFFICE OF THE JACKSON COUNTY SURVEYOR.

> \* RECEIVED \* Date 1-19-07 By 88 This survey consists of 4 sheet(s) Map **\_\_\_** page(s) Narrative/ JACKSON COUNTY SURVEYOR

### **APPROVALS**

EXAMINED AND APPROVED THIS 19 DAY OF January, 2007.

EXAMINED AND APPROVED THIS AS REQUIRED BY O.R.S. 100.110 AS OF

ALL TAXES, FEES, ASSESSMENTS, OR OTHER CHARGES AS REQUIRED BY O.R.S. 100.110 HAVE BEEN PAID AS OF \_\_\_\_\_\_\_, 2007.

### **RECORDING:**

FILED FOR RECORD THIS Q DAY OF DAY OF 2007 AT 3:05 O'CLOCK PM AND RECORDED IN VOLUME 33, PAGE 04, OF THE PLAT RECORDS OF JACKSON COUNTY, OREGON.

KATHLEEN S. BECKETT CHERYL AVGERIS
COUNTY CLERK DEPITY

THE DECLARATION OF CONDOMINIUM OWNERSHIP, COVENANTS. CONDITIONS AND RESTRICTIONS HAVE BEEN RECORDED IN INSTRUMENT NO. 2007- 003422 OF THE OFFICIAL RECORDS OF JACKSON COUNTY, OREGON

THE BYLAWS OF McCALL DRIVE CONDOMINIUM HAVE BEEN RECORDED IN INSTRUMENT NO. 2007- 003422 OF THE OFFICIAL RECORDS OF JACKSON COUNTY, OREGON.

### SURVEY NARRATIVE TO COMPLY WITH O.R.S. 209.250

PURPOSE: TO CREATE A CONDOMINIUM PLAT "McCALL DRIVE CONDOMINIUM" ON PARCEL 1 OF PARTITION PLAT NO. P-05-2005 OF THE PLAT RECORDS OF JACKSON COUNTY, OREGON, LYING SITUATE WITHIN THE SOUTHWEST QUARTER OF SECTION 11, TOWNSHIP 39 SOUTH, RANGE 1 EAST OF THE WILLAMETTE MERIDIAN.


PROCEDURE: UTILIZING AN ELECTRONIC LEICA TCRA 1103 ROBOTIC TOTAL STATION WITH RANGING PRISMS, I SURVEY THE LAND AS SHOWN HEREON. THE SUBJECT PROPERTY BOUNDARIES WERE DETERMINED FROM SURVEY CONTROL PREVIOUSLY ESTABLISHED BY THIS OFFICE IN THE PERFORMANCE OF SURVEY NO. 18590, FILED IN THE OFFICE OF THE JACKSON COUNTY SURVEYOR. THE RIGHT OF WAY FOR McCALL DRIVE, AS SHOWN HEREON, WAS DEDICATED BY DEED TO THE CITY OF ASHLAND AND RECORDED AS INSTRUMENT NO. 2005-073293 OF THE OFFICIAL RECORDS OF JACKSON COUNTY, OREGON.

SURVEYED BY:

POLARIS LAND SURVEYING LLC P.O. BOX 459 ASHLAND, OREGON 97520 (541) 482-5009

> DATE: NOVEMBER 16, 2006 PROJECT NO. 168-04

FILE: SURVEYS\168-04\McCALL DRIVE CONDOMINIUM,DWG SHEET 1 OF 4

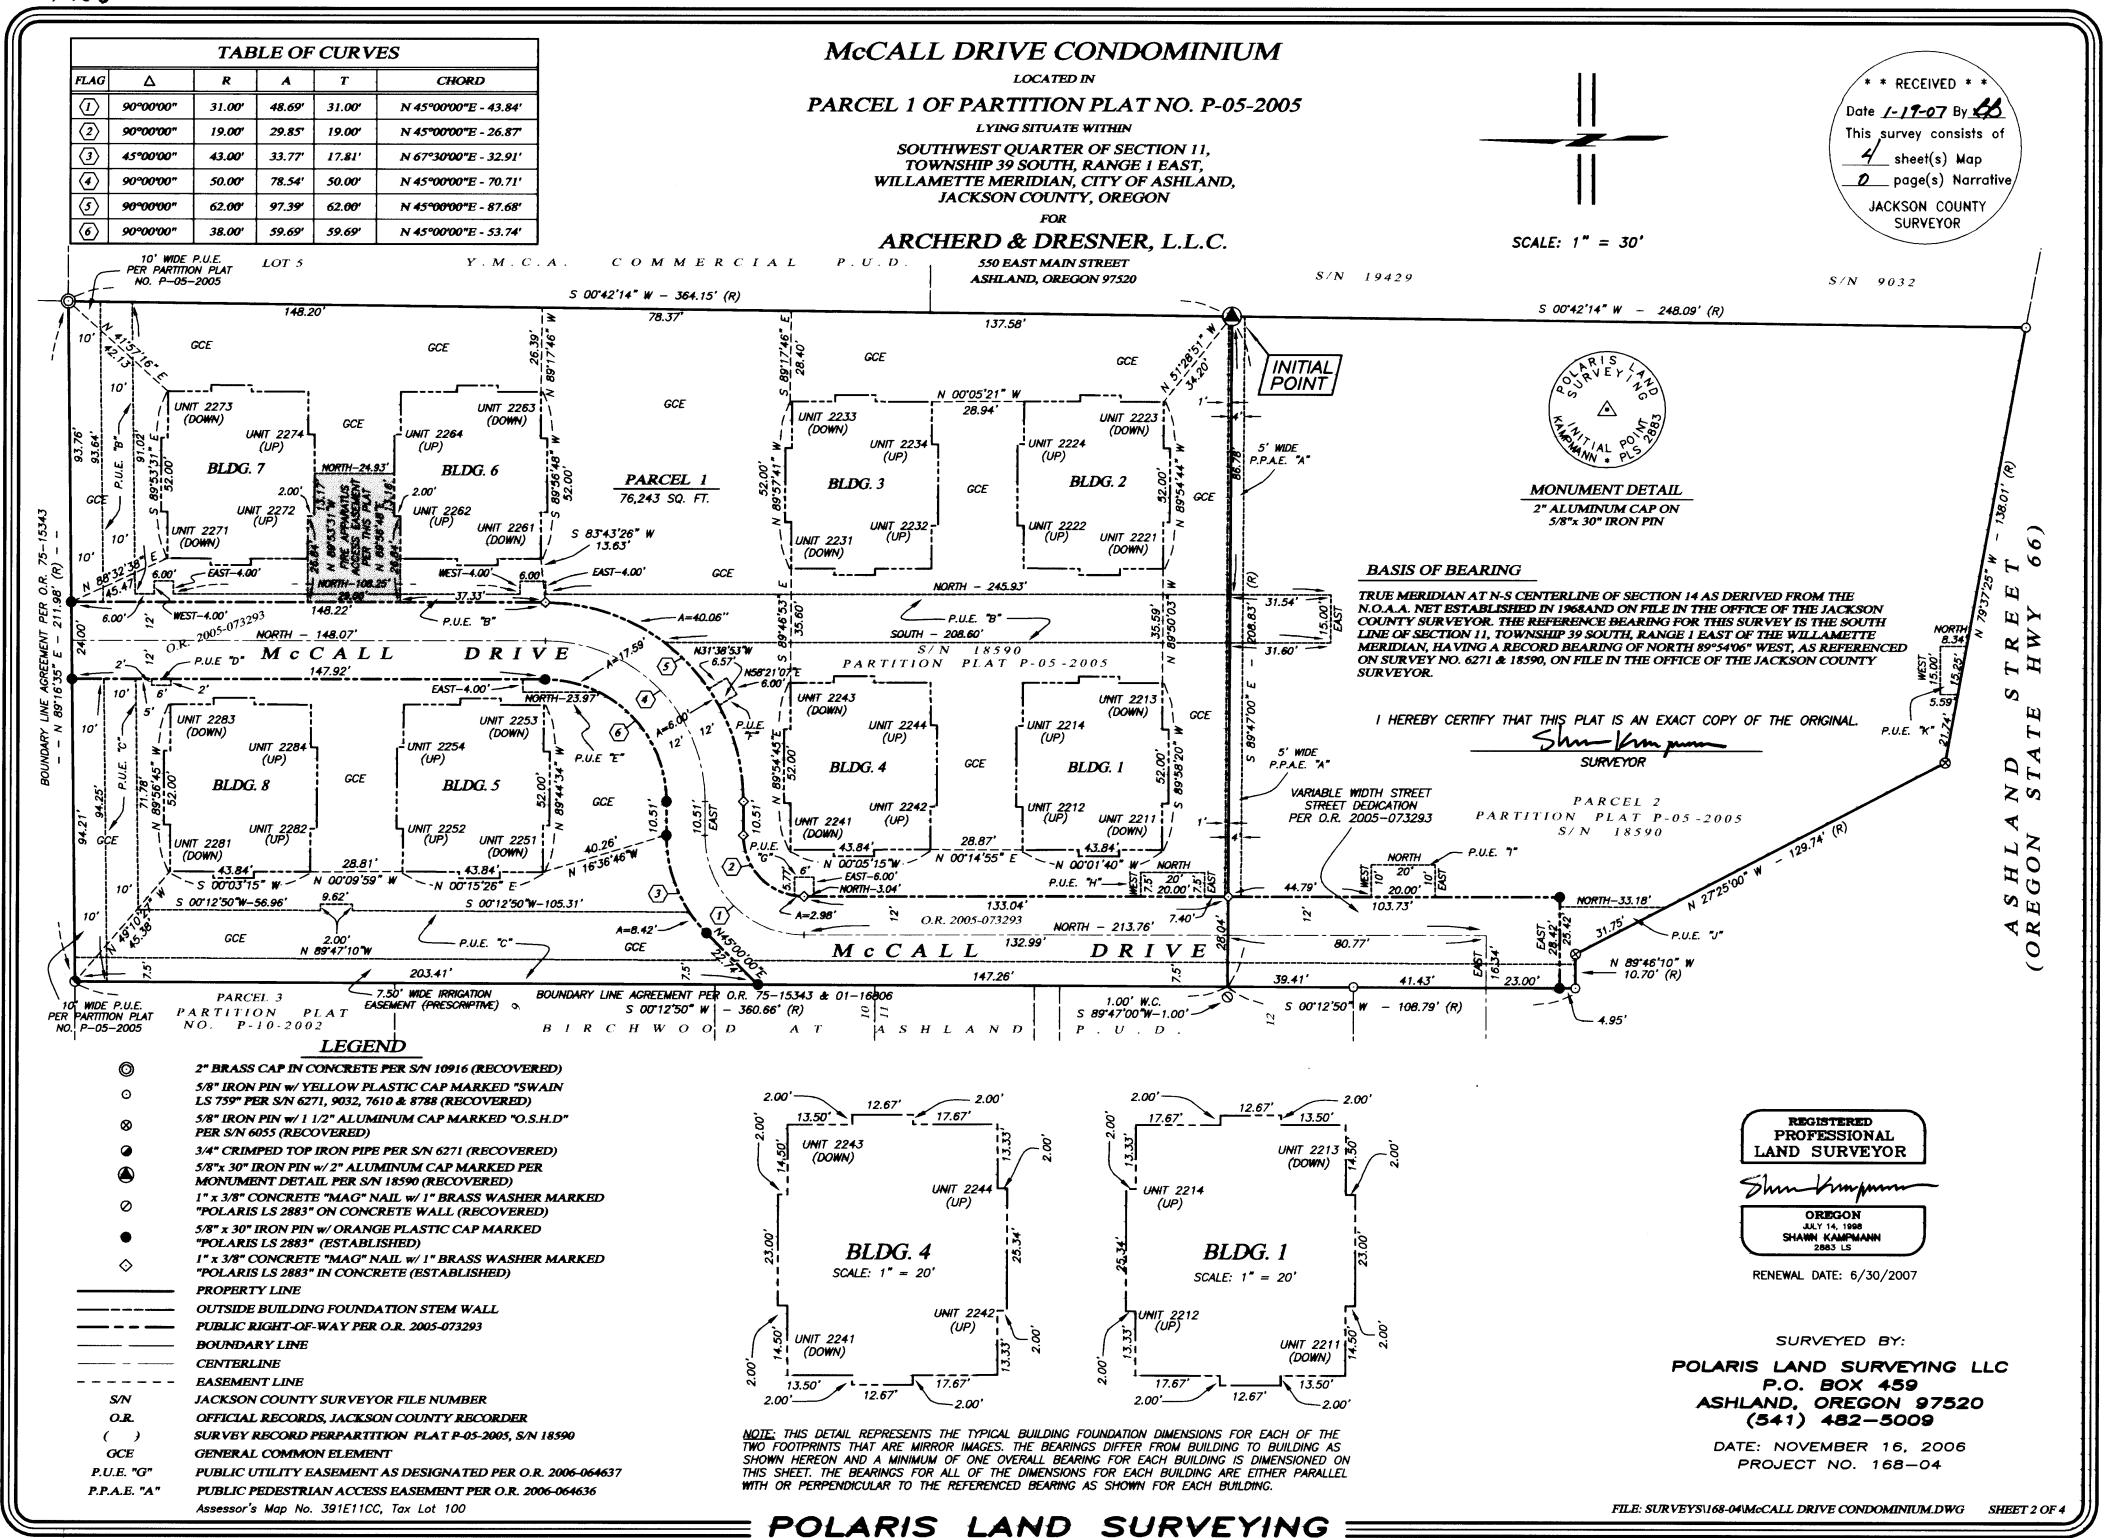

Assessor's Map No. 391E11CC, Tax Lot 100

### McCALL DRIVE CONDOMINIUM LOCATED IN \* \* RECEIVED \* **LEGEND** PARCEL 1 OF PARTITION PLAT NO. P-05-2005 Date 1-19-07 By 55 UNIT BOUNDARY LYING SITUATE WITHIN LCE BOUNDARY This survey consists of EXTERIOR FOUNDATION STEM WALL OF NEW BUILDING SOUTHWEST QUARTER OF SECTION 11, 4 sheet(s) Map GENERAL COMMON ELEMENT TOWNSHIP 39 SOUTH, RANGE 1 EAST, LIMITED COMMON ELEMENT LCE WILLAMETTE MERIDIAN, CITY OF ASHLAND, **\_\_** page(s) Narrative/ **SOUARE FEET** SQ. FT. JACKSON COUNTY, OREGON G-2231 GARAGE AREA LIMITED COMMON ELEMENT (LCE) JACKSON COUNTY PORCH AREA LCE ASSOCIATED WITH UNIT P-2231 SURVEYOR ARCHERD & DRESNER, L.L.C. PS-2244 PORCH AND STAIRS LCE ASSOCIATED WITH UNIT D-208 DECK AREA LCE ASSOCIATED WITH UNIT 550 EAST MAIN STREET (1906.20') **UNIT BOUNDARY ELEVATION** ASHLAND, OREGON 97520 **ELEVATIONS** 9.39 9.39 LCE'S: PS-2212, PS-2214, PS-2222, PS-2224 PS-2252, PS-2254, 0.44 PS-2262, PS-2264 LCE'S: D-2212, D-2214, D-2222, D-2224 D-2252, D-2254, D-2262, D-2264 UNITS: 2212, 2214, 2222, 2224 2252, 2254, 2262, 2264 4.20 4.20' 2.00 2.00' UNITS: 2212, UNITS: 2214, 1005 SQ.FT. 2222. 1005 SQ.FT. 2224. 2252, 2254, 2262 2264 2.00 4.20 6.20 (SEE TABLE FOR SPECIFIC LUNIT) 6.20 - 0.80° 6.20' LCE'S: PS-2212, PS-2222 PS-2252, PS-2262 LCE'S: PS-2214, PS-2224, SEE TABLE FOR SPECIFIC JUNIT) PS-2254, PS-2264 (SEE TABLE FOR SPECIFIC UNIT) 89 SQ. FT. 89 SQ. FT. 14.50 14.50' LCE'S: G-2211, G-2212, G-2213, G-2214, G-2221, G-2222 LCE'S: D-2211, D-2213, D-2221, D-2223 ---- D-2251, D-2253, 15.60 15.60 10.66 10.66 G-2223, G-2224 G-2251, G-2252, G-2253, G-2254, G-2261, G-2262 G-2263, G-2264 COMMON POINT "A" UNITS: 2231, 2233, 2241, 2243 2271, 2273, 2281, 2283 SECOND FLOOR D-2261, D-2263 LCE'S: P-2211, P-2213, BLDG. 1, 2, 5, 6 14.80 P-2221, P-2223 P-2251, P-2253, SCALE: 1" = 10' 0.80' LCE'S: D-2212, D-2222, D-2252, D-2262 P-2261, P-2263 LCE'S: D-2214, D-2224, D-2254, D-2264 97 SQ. FT. 97 SQ. FT. TABLE OF ELEVATIONS 11.83 11.83 UNIT NO. GARAGE FLOOR FIRST FLOOR SECOND FLOOR 12.90' 12.90' 1992.45 1992.45 I HEREBY CERTIFY THAT THIS PLAT IS AN EXACT COPY OF THE ORIGINAL. | LCE'S: G-2212, | LCE'S: G-2214, | LCE'S: G-2213, | G-2223, | G-2224, | G-2223, | G-2252, | G-2254, | G-2263, | G-2262, | G-2263, | G-2 LCE'S: G-2211, G-2221, 1983.33 Show Kom mon 1981.87<sup>1</sup> 1992.45 G=2251, SURVEYOR G-2261 261 SQ. FT. 242 SQ. FT. 261 SQ. FT. 1992.45 242 SQ. FT. 2251 1975.45' 2252 1975.45' 2253 1975.45' 1976.91 1986.03 6.08 1976.91 1*986.03*° REGISTERED 11.83' 6.82' NH 8 8 N 6.82' **PROFESSIONAL** 1977.73' LAND SURVEYOR 19.54 1986.85 1977.73 LCE'S: PS-2213, PS-2223, PS-2253, PS-2263 Show Kompon 0.44 36 SQ. FT. OREGON 2.00 JULY 14, 1996 SHAWN KAMPMANN 2883 LS UNITS: 2211, UNITS: 2213, 6.20 **NOTES** 625 SQ.FT. 2223, 625 SQ.FT. 2221. 2253, 2251, 1) ALL ANGLES ARE 90° UNLESS NOTED OTHERWISE. RENEWAL DATE: 6/30/2007 <u>6.20'</u> 2261 2263 <u> 5.20'</u> 2) UNIT HORIZONTAL DIMENSIONS ARE TO FACE OF INTERIOR STUD WALL. 3) ELEVATIONS ARE AS FOLLOWS: (A) TOP OF PLYWOOD SUBFLOOR FOR ALL UNIT LOWER LIMITS (B) BOTTOM OF FLOOR JOISTS FOR FIRST FLOOR UPPER LIMITS (C) BOTTOM OF ENGINEERED TRUSSES FOR SECOND FLOOR UPPER LIMITS LCE'S: PS-2211, PS-2221 (D) TOP OF CONCRETE SLAB FOR GARAGE LCE LOWER LIMITS 14.50 14.50 PS-2251, PS-2261 4) ALL OF THE LAND AND THE BUILDINGS ARE GCE EXCEPT FOR UNITS AND LCE'S 10.66 10.66 SURVEYED BY: 36 SQ. FT. 14.80' SHOWN HEREON. COMMON POINT "A" 5) THE EXTERIOR OF BUILDING SHOWN HEREON IS MEASURED TO THE OUTSIDE 2.00' 2.00' POLARIS LAND SURVEYING LLC OF THE CONCRETE FOUNDATION STEM WALL. 6) THE DISTANCE BETWEEN THE EXTERIOR OF THE BUILDING AND THE INTERIOR 15.60' 15.**6**0' P.O. BOX 459 FIRST FLOOR UNIT BOUNDARY VARIES AS SHOWN. ASHLAND, OREGON 97520 7) THE VERTICAL CONTROL FOR THIS SURVEY IS CITY OF ASHLAND GPS NETWORK BLDG. 1, 2, 5, 6 STATION "TOLMAN #506", A 3" DIAMETER BRASS CAP IN CONCRETE, LOCATED (541) 482-5009 LCE'S: D-2211, D-2221, D-2251, D-2261 97 SQ. FT. D-2213, D-2223, EAST OF THE ANGLE POINT ON THE NORTH END OF TOLMAN CREEK ROAD. D-2253, D-2263 BENCHMARK ELEVATION = 1917.03 FEET, BASED ON THE NATIONAL GEODETIC DATE: NOVEMBER 16, 2006 97 SQ. FT. VERTICAL DATUM OF 1929, ADJUSTED IN 1956 (NGVD 29(56). PROJECT NO. 168-04

POLARIS LAND SURVEYING

SHEET 3 OF 4

FILE: SURVEYS\168-04\McCALL DRIVE CONDOMINIUM.DWG

### \* \* RECEIVED \* Date 1-19-07 By 65 This survey consists of sheet(s) Map page(s) Narrative, JACKSON COUNTY SURVEYOR LCE'S: D-2232, D-2242, LCE'S: D-2234, D-2244, D-2272, D-2282 D-2274, D-2284 97 SQ. FT. 97 SQ. FT. 15.60 15.60' COMMON POINT "B"-2.00 2.00 14.80 14.80' 6.20' 6.20 6.20' 4.20' **UNITS: 2234** 4.20 **UNITS: 2232** 2.00 1005 SQ.FT. 2244. 1005 SQ.FT. 2242, 2274, 2272, 2284 2282 2.00' 2.00 4.20' --- 0.80° LCE'S: PS-2234, PS-2244, PS-2274, PS-2284 LCE'S: PS-2232, PS-2242 PS-2272, PS-2282 89 SQ. FT. 89 SQ. FT. 15.77' 15.77' SECOND FLOOR BLDG. 3, 4, 7, 8 LCE'S: D-2231, LCE'S: D-2233. D-2241, D-2271, D-2243 D-2273, D-2281 D-2283 15.60 0.80 97 SQ. FT. COMMON POINT "B"-2.00' 14.<del>5</del>0' 6.20' 6.20 UNITS: 2233, UNITS: 2231, 625 SQ.FT. 2241 625 SQ.FT. 2243, 2271, 2273, 2.00 2283 2281 / LCE'S: P-2231, P-2241, P-2271, P-2281 36 SQ. FT. LCE'S: P-2233, P-2243 P-2273, 19.54 P-2283 36 SQ. FT. 11.83 11.83' 0.44 LCE'S: G-2234, G-2244, LCE'S: G-2232, G-2242 LCE'S: G-2233, G-2243, LCE'S: G-2231, G-2241, G-2271, G-2281 G-242 SQ. FT. G-2284 8118 G-2273, G-2282 261 SQ. FT. XII N 261 SQ. FT. XII N 242 SQ. FT. 12.90' 12.90' FIRST FLOOR BLDG. 3, 4, 7, 8 Assessor's Map No. 391E11CC, Tax Lot 100

# McCALL DRIVE CONDOMINIUM

LOCATED IN

### PARCEL 1 OF PARTITION PLAT NO. P-05-2005

LYING SITUATE WITHIN

SOUTHWEST QUARTER OF SECTION 11, TOWNSHIP 39 SOUTH, RANGE 1 EAST, WILLAMETTE MERIDIAN, CITY OF ASHLAND, JACKSON COUNTY, OREGON

## ARCHERD & DRESNER, L.L.C.

550 EAST MAIN STREET ASHLAND, OREGON 97520

### **LEGEND**

UNIT BOUNDARY LCE BOUNDARY

EXTERIOR FOUNDATION STEM WALL OF NEW BUILDING GENERAL COMMON ELEMENT

LIMITED COMMON ELEMENT

**SQUARE FEET** SQ. FT.

**GCE** 

LCE


GARAGE AREA LIMITED COMMON ELEMENT (LCE) G-2231

PORCH AREA LCE ASSOCIATED WITH UNIT P-2231

PORCH AND STAIRS LCE ASSOCIATED WITH UNIT PS-2244 DECK AREA LCE ASSOCIATED WITH UNIT D-208

UNIT BOUNDARY ELEVATION (1906.20')

### **ELEVATIONS**

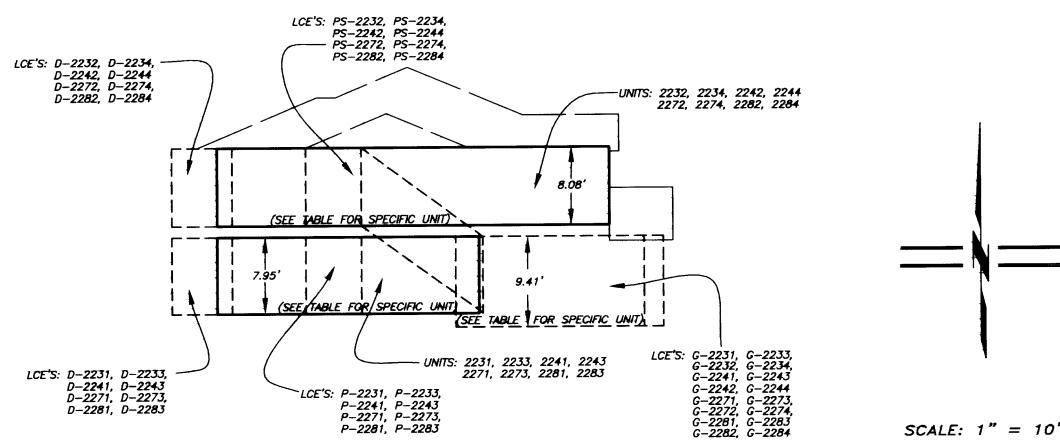

### TABLE OF ELEVATIONS

•		1010105 5 000	COCT CLOOD	SECOND FLOOR
	UNIT NO.	GARAGE FLOOR	FIRST FLOOR	SECOND FLOOR
(m)	<i>2231</i>	1980.56	1982.02°	
ا تو ا	2232	1980.56°		1991.14'
BLDG	2233	1980.56	1982.02'	
100	2234	1980.56'		1991.14'
T	2241	1980.55'	1982.01	
10	2242	1980.55		1991.13'
BLDG	2243	1 <del>98</del> 0.55	1982.01	
18	2244	1 <i>980.</i> 55		1991.13'
	2271	1975.07'	1976.53'	<del> </del>
ان	2272	1975.07		1985.65
BLDG	2273	1975.07'	1976.53	
18	2274	1975.07'		1985.65
8	2281	1974.36'	1975.82'	
اوا	2282	1974.36'		1984.94
BLDG	2283	1974.36'	1975.82'	
1	2284	1974.36'		1984.94

## **NOTES**

- 1) ALL ANGLES ARE 90° UNLESS NOTED OTHERWISE.
- 2) UNIT HORIZONTAL DIMENSIONS ARE TO FACE OF INTERIOR STUD WALL.
- 3) ELEVATIONS ARE AS FOLLOWS: (A) TOP OF PLYWOOD SUBFLOOR FOR ALL UNIT LOWER LIMITS
  - (B) BOTTOM OF FLOOR JOISTS FOR FIRST FLOOR UPPER LIMITS (C) BOTTOM OF ENGINEERED TRUSSES FOR SECOND FLOOR UPPER LIMITS (D) TOP OF CONCRETE SLAB FOR GARAGE LCE LOWER LIMITS
- 4) ALL OF THE LAND AND THE BUILDINGS ARE GCE EXCEPT FOR UNITS AND LCE'S
- SHOWN HEREON. 5) THE EXTERIOR OF BUILDING SHOWN HEREON IS MEASURED TO THE OUTSIDE

VERTICAL DATUM OF 1929, ADJUSTED IN 1956 (NGVD 29(56).

- OF THE CONCRETE FOUNDATION STEM WALL. 6) THE DISTANCE BETWEEN THE EXTERIOR OF THE BUILDING AND THE INTERIOR
- UNIT BOUNDARY VARIES AS SHOWN. 7) THE VERTICAL CONTROL FOR THIS SURVEY IS CITY OF ASHLAND GPS NETWORK STATION "TOLMAN #506", A 3" DIAMETER BRASS CAP IN CONCRETE, LOCATED EAST OF THE ANGLE POINT ON THE NORTH END OF TOLMAN CREEK ROAD. BENCHMARK ELEVATION = 1917.03 FEET, BASED ON THE NATIONAL GEODETIC

I HEREBY CERTIFY THAT THIS PLAT IS AN EXACT COPY OF THE ORIGINAL.



PROFESSIONAL LAND SURVEYOR

Show Krongman

OREGON SHAWN KAMPMANN

RENEWAL DATE: 6/30/2007

SURVEYED BY:

POLARIS LAND SURVEYING LLC P.O. BOX 459 ASHLAND, OREGON 97520 (541) 482-5009

> DATE: NOVEMBER 16, 2006 PROJECT NO. 168-04

FILE: SURVEYS\168-04\McCALL DRIVE CONDOMINIUM.DWG

POLARIS LAND SURVEYING

SHEET 4 OF 4