

MAP OF SURVEY

Partition Plat UNRECORDED

located in the
 SOUTHWEST ONE QUARTER OF SECTION 8,
 TOWNSHIP 37 SOUTH, RANGE 1 WEST,
 WILLAMETTE MERIDIAN, CITY OF MEDFORD
 JACKSON COUNTY, OREGON

for

LOTT AUTOLAND II, LLC

3246 CRATER LAKE AVE
 MEDFORD, OREGON 97504

LEGEND

- = FOUND BOLT IN MONUMENT CASE, TIED IN S/N 13739
- = BRASS DISK IN CONCRETE TIED IN S/N 13739
- = FOUND 5/8" IRON PIN PER S/N 10944 OR AS DESCRIBED NOT TIED THIS SURVEY (SEE SURVEY NUMBER 18621)
- = SET 5/8" X 30" IRON PIN WITH YELLOW PLASTIC CAP "FARBER PLS 2189"
- = SET 5/8" X 30" IRON PIN w/ YELLOW PLASTIC CAP MARKED "FARBER PLS 2189"

BASIS OF BEARING: TRUE NORTH, NAD 89/91 DATUM, AS DERIVED BY GLOBAL POSITIONING SYSTEM OBSERVATIONS.
 S/N = SURVEY NUMBER PER THE OFFICE OF THE JACKSON COUNTY SURVEYOR.
 RECORD SURVEY OR DEED DATA IS SHOWN IN PARENTHESIS ADJACENT TO MEASURED SURVEY DATA WHERE APPLICABLE.
 INST. NO. = INSTRUMENT NUMBER AS RECORDED IN THE OFFICIAL RECORDS OF JACKSON COUNTY, OREGON.


**** RECEIVED ****
 DATE 9-17-07 BY [Signature]
 This survey consists of:
1 sheet(s) Map
2 page(s) Narrative
 JACKSON COUNTY SURVEYOR

REGISTERED
 PROFESSIONAL
 LAND SURVEYOR
[Signature]
 OREGON
 JULY 28, 1985
 HERBERT A. FARBER
 2189
 RENEWAL DATE 12-31-07

PURPOSE
 TO SURVEY AND MONUMENT THE BOUNDARY THE PARTITION AS APPROVED BY THE CITY OF MEDFORD IN FILE NUMBER LDP-05-221

PROCEDURE
 USING CONTROL ESTABLISHED FOR SURVEY NUMBER 18621, I LOCATED THE BOUNDARY AS SHOWN HERE ON. SINCE THE TIME SURVEY NUMBER 18621 WAS FILED ADDITIONAL RIGHT-OF-WAY ON BOTH FORD DRIVE AND CRATER LAKE AVENUE WAS DEDICATED TO THE CITY OF MEDFORD BY INST. NO. 2005-066488. THE NEW RIGHT-OF-WAY IS NOW THE SOUTHERLY AND WESTERLY BOUNDARY OF THE PROJECT. THE OLD RIGHT-OF-WAY IS SHOWN AS A DASHED LINE FOR REFERENCE. AT THE REQUEST OF MY CLIENT, WHO WISHES NOT TO PARTITION THIS TRACT AT THIS TIME, THIS MAP IS BEING FILED AS A MAP OF SURVEY FOR RECORDING AT THE COUNTY SURVEYOR'S OFFICE.

Surveyed by:
FARBER & SONS, INC.
 dba FARBER SURVEYING
 (541) 664-5599
 PO BOX 5286
 431 OAK STREET
 CENTRAL POINT, OREGON 97502

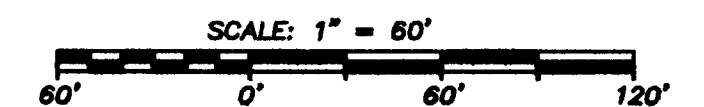

DATE: December 30, 2004, REVISED February 1, 2006, September 13, 2007
 Drawn By: RMK Drawn By: RMK Drawn By: DJW

JOB NO.: 1301-04
 DRAWING FILE: JOBS\Medford_NE\Ford Property\MicroSurvey\MOS.FLX

