


REVIEWED AND APPROVED BY JACKSON COUNTY PLANNING

JACO FILE NO. SUB2007-00009_PLA

BY: *James W. Clancy*

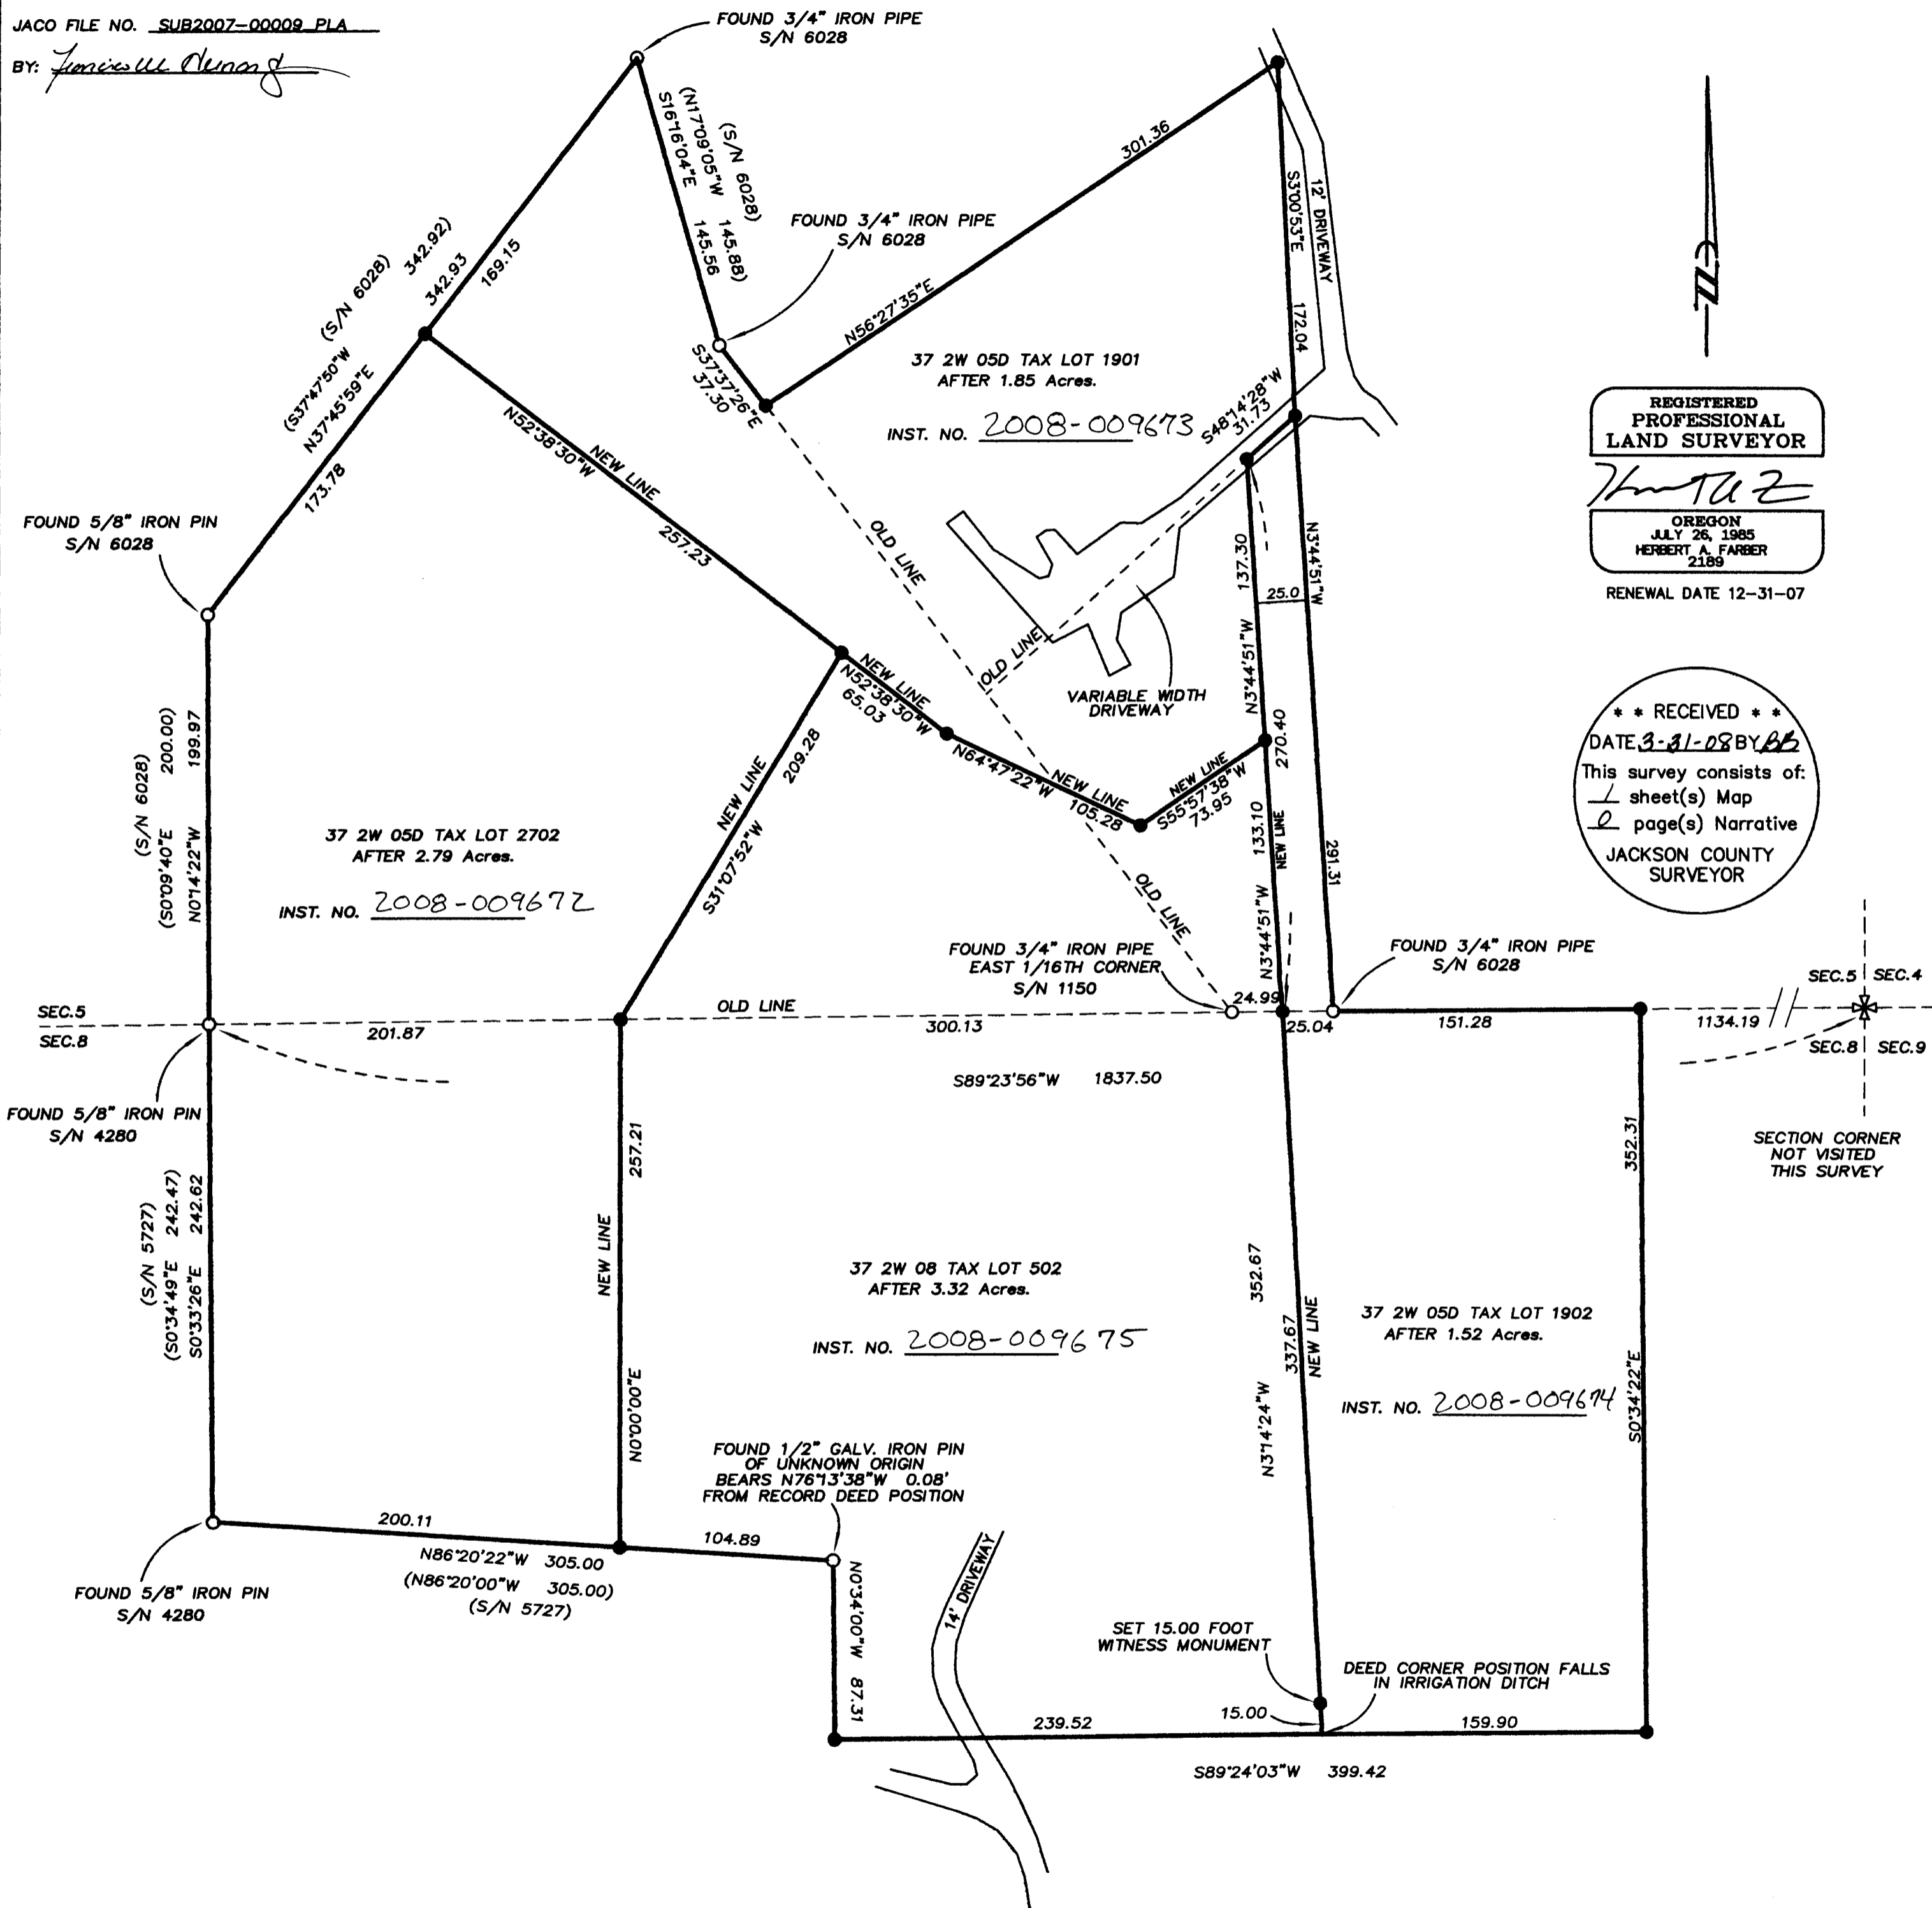

MAP OF SURVEY
 FOR A
PROPERTY LINE ADJUSTMENT
 located in the
 SOUTHEAST ONE QUARTER OF SECTION 5 AND
 NORTHEAST ONE QUARTER OF SECTION 8
 TOWNSHIP 37 SOUTH, RANGE 2 WEST,
 WILLAMETTE MERIDIAN, JACKSON COUNTY, OREGON
 for
KENT AND LAURA DEYARMAN
 3775 OLD MILITARY ROAD
 CENTRAL POINT, OREGON 97502

**REGISTERED
 PROFESSIONAL
 LAND SURVEYOR**
Herbert A. Farber
 OREGON
 JULY 26, 1985
 HERBERT A. FARBER
 2189
 RENEWAL DATE 12-31-07

** RECEIVED **
 DATE 3-31-08 BY BB
 This survey consists of:
1 sheet(s) Map
2 page(s) Narrative
 JACKSON COUNTY
 SURVEYOR

LEGEND

- ⊕ = FOUND 2 1/2" BRASS CAP - SECTION CORNER
- = FOUND MONUMENT - AS NOTED
- = SET 5/8" x 24" IRON PIN w/ YELLOW PLASTIC CAP MARKED "FARBER PLS 2189"
- S/N = RECORD FILED SURVEY NUMBER
- W.C. = WITNESS CORNER

- BASIS OF BEARING IS TRUE NORTH, NAD 83/91 DATUM, AS DERIVED BY GLOBAL POSITIONING SYSTEM OBSERVATIONS.
 - RECORD SURVEY DATA IS SHOWN IN PARENTHESIS ADJACENT TO MEASURED SURVEY DATA WHERE APPLICABLE.
 - INST. No. = INSTRUMENT NUMBER AS RECORDED IN THE OFFICIAL RECORDS OF JACKSON COUNTY, OREGON.

**SURVEY NARRATIVE
 TO COMPLY WITH O.R.S. 209.250**

PURPOSE: TO SURVEY AND MONUMENT THE PROPERTY LINE ADJUSTMENT AS APPROVED BY JACKSON COUNTY PLANNING FILE NO. SUB2007-00009_PLA.

PROCEDURE: UTILIZING GLOBAL POSITIONING SYSTEMS CONTROL, I TIED THE FOUND MONUMENTS AS SHOWN. THE RECOVERED MONUMENTS MATCH SURVEYS AND DEED RECORD 2004-066007, WITH SURVEY AND DEED BEING THE SAME RECORD DIMENSIONS. MONUMENTS SET PER JACKSON COUNTY PLANNING APPROVED PLAN, AS SHOWN HEREON.

Surveyed by:
FARBER & SONS, INC.
 dba FARBER SURVEYING
 (541) 664-5599
 PO BOX 5286
 431 OAK STREET
 CENTRAL POINT, OREGON 97502

SCALE: 1" = 60'

DATE: SEPTEMBER 13, 2007
 JOB NO.: 1445-06
 DRAWN BY: DJW