


ASHLEY PLACE

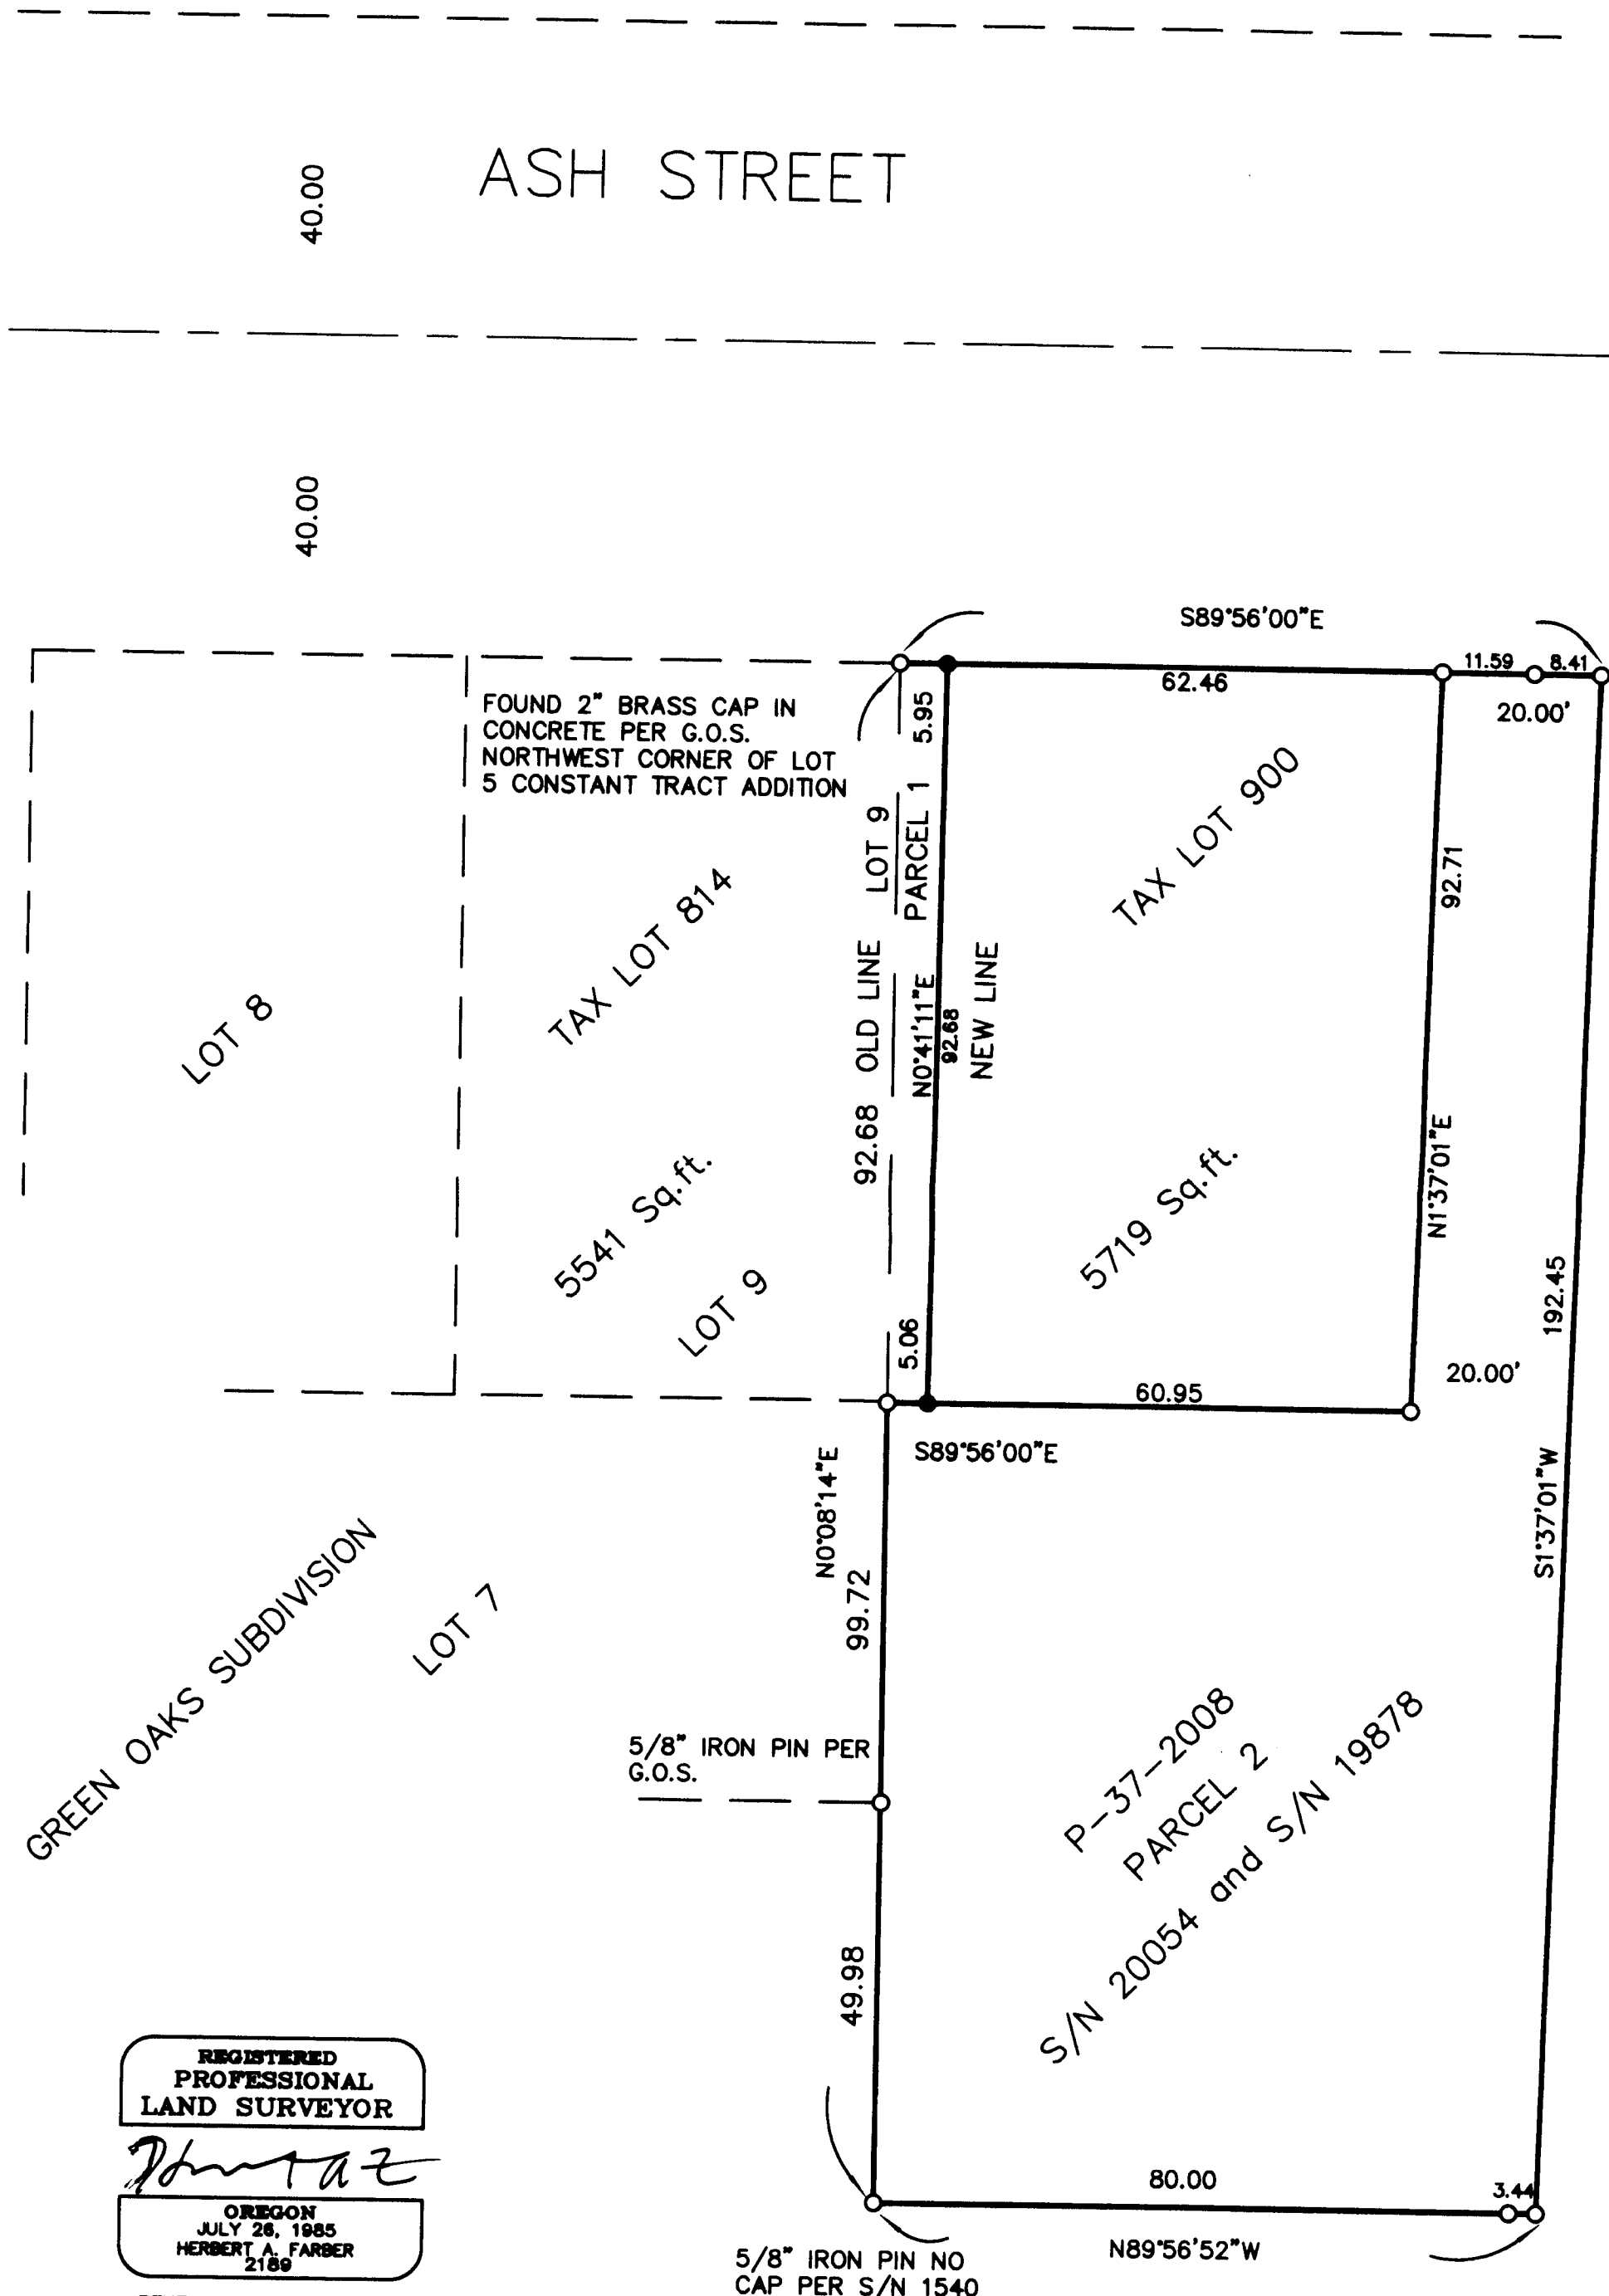

MAP OF SURVEY  
PROPERTY LINE ADJUSTMENT

located in the  
NORTHWEST ONE QUARTER OF SECTION 11,  
TOWNSHIP 37 SOUTH, RANGE 2 WEST,  
WILLAMETTE MERIDIAN, JACKSON COUNTY, OREGON

for  
**VIRGINIA BROWN**

P.O. BOX 5327  
CENTRAL POINT, OREGON 97502

LEGEND

- = FOUND IRON PIN w/ YELLOW PLASTIC CAP MARKED "FARBER PLS 2189", PER S/N 19878, 20054, OR AS DESCRIBED
- = SET 5/8" x 24" IRON PIN w/ YELLOW PLASTIC CAP MARKED "FARBER PLS 2189"

G.O.S.=GREEN OAKS SUBDIVISION VOLUME 9, PAGE 53 PLAT RECORDS OF JACKSON COUNTY, OREGON  
S/N = RECORD FILED SURVEY NUMBER

- BASIS OF BEARING IS TRUE NORTH, NAD 83/91 DATUM, AS DERIVED BY GLOBAL POSITIONING SYSTEM OBSERVATIONS.
- RECORD SURVEY DATA IS SHOWN IN PARENTHESIS ADJACENT TO MEASURED SURVEY DATA WHERE APPLICABLE.
- INST. No. = INSTRUMENT NUMBER AS RECORDED IN THE OFFICIAL RECORDS OF JACKSON COUNTY, OREGON.

SURVEY NARRATIVE  
TO COMPLY WITH O.R.S. 209.250

Purpose: This survey has been conducted to per THE CIRCUIT COURT OF THE STATE OF OREGON FOR JACKSON COUNTY with GENE E. and BETTY J. SKELTON, Plaintiffs, v. VIRGINIA L. BROWN, TRUSTEE FOR THE VIRGINIA L. BROWN LIVING TRUST, Defendant. CASE NO.: 10-3974-E3, dated April 4, 2011.

Procedure: Using control established on previous surveys for the Brown property I tied the found monuments of Parcel 1 as shown hereon. All of the remaining monuments for Parcel 2 were not visited on this survey and are shown for reference only. The agreed to boundary was monumented per the defendant and plaintiffs agreement.

Surveyed by:

FARBER & SONS, INC.  
dba FARBER SURVEYING  
(541) 664-5599

PO BOX 5286  
431 OAK STREET  
CENTRAL POINT, OREGON 97502

SCALE: 1" = 20'



DATE: MARCH 16, 2011  
JOB NO.: 1522-07

JOBS\CENTRAL POINT\ASH STREET\MICROSURVEY\FINAL PLATS SURVEYS\  
PLA-031611.DWG

DRAWN BY: HAF ORIG. DATE: 3-16-11 REVISED BY: DATE:

\*\* RECEIVED \*\*  
DATE 7-19-11 BY *bb*  
This survey consists of:  
1 sheet(s) Map  
2 page(s) Narrative  
JACKSON COUNTY  
SURVEYOR

REGISTERED  
PROFESSIONAL  
LAND SURVEYOR

*Herbert A. Farber*

OREGON  
JULY 26, 1985  
HERBERT A. FARBER  
2189

RENEWAL DATE 12-31-11