

MAP OF SURVEY  
of  
TAXLOTS: 300, 400, & 500  
located in the  
NORTHWEST QUARTER, SOUTHWEST QUARTER,  
AND SOUTHEAST QUARTER OF SECTION 22,  
TOWNSHIP 37 SOUTH, RANGE 1 EAST,  
WILLAMETTE MERIDIAN, JACKSON COUNTY, OREGON

for  
**BUSTER ALLEN INC.**  
5200 N PALM AVE SUITE 310  
FRESNO, CALIFORNIA, 93704

LEGEND

- ✦ = FOUND 3" BRASS CAP - STANDARD BLM CORNER
  - = FOUND 2 1/2" BRASS CAP - JACKSON COUNTY SURVEYOR
  - ⊙ = SET 5/8" x 24" IRON PIN w/ 2 1/2" ALUMINUM CAP MARKED "PLS 2189"
  - ⊗ = FOUND 1" IRON PIPE WITH BRASS GLO CAP
- RECORD SURVEY DATA IS SHOWN IN PARENTHESIS ADJACENT TO MEASURED SURVEY DATA WHERE APPLICABLE.  
- INST. NO. = INSTRUMENT NUMBER AS RECORDED IN THE OFFICIAL RECORDS OF JACKSON COUNTY, OREGON.  
- BLM = BUREAU OF LAND MANAGEMENT  
- GLO = GENERAL LAND OFFICE

SURVEY NARRATIVE TO COMPLY WITH O.R.S. 209.250

Purpose: This survey was conducted to establish the boundary of the property described in Jackson County Instrument Number 2013-5537 and monument the missing corner.


Procedure: This survey was conducted using Trimble GPS 5800 and R-8 receivers and Trimble 5600 robotic total station. The survey was ran as a closed survey shown hereon. The Center One-Quarter corner of Section 22, Township 37 South, Range 1 East of the Willamette Meridian, Jackson County, Oregon. This corner was set at the intersections of the lines inverted between the found exterior One-Quarter Section corners.

Surveyed by:  
FARBER & SONS, INC. dba



PO BOX 5286  
431 OAK STREET  
CENTRAL POINT, OREGON 97502  
(541) 664-5599

DATE: MARCH 20, 2014  
JOB NO.: 2035-13  
DRAWING FILE: JOBS\Antelope Creek\371e22 Buster Allen\MicroSurvey\Final Plats Surveys\BUSTER ALLEN MOS 03202014.dwg  
DRAWN BY: LSH ORIG. DATE: 03/28/2014 REVISED BY: DATE:

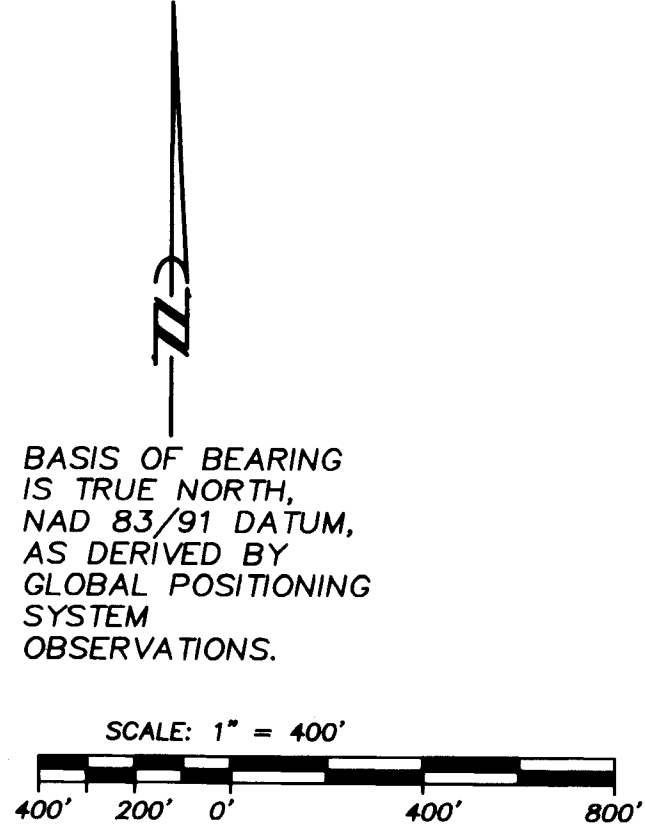

BASIS OF BEARING IS TRUE NORTH, NAD 83/91 DATUM, AS DERIVED BY GLOBAL POSITIONING SYSTEM OBSERVATIONS.

\*\* RECEIVED \*\*  
DATE 4-18-14 BY [Signature]  
This survey consists of:  
1 sheet(s) Map  
0 page(s) Narrative  
JACKSON COUNTY SURVEYOR

REGISTERED PROFESSIONAL LAND SURVEYOR  
[Signature]  
OREGON JULY 26, 1985  
HERBERT A. FARBER 2189  
RENEWAL DATE 12-31-15

SECTION 22

CENTER 1/4 ACCESSORIES SET:  
BEARING TREE MARKED: 8" WHITE OAK BEARS S16°26'44"W, 84.87'  
BEARING TREE MARKED: 16" PINE BEARS N71°25'17"E, 48.97'  
WITNESS MONUMENT SET: 5/8" x 30" IRON PIN WITH YELLOW PLASTIC CAP MARKED "FARBER PLS 2189" BEARS SOUTH 32°14'48" EAST, 44.77'  
WITNESS MONUMENT SET: 5/8" x 30" IRON PIN WITH YELLOW PLASTIC CAP MARKED "FARBER PLS 2189" BEARS NORTH 75°52'40" WEST, 93.19'

INST. NO. 2013-5537

