21563
FILE No. LDS14-022
Approvals:
I certify that pursuant to authority granted in Ordinance No. 5785 this plat is hereby approved. This 9th day of Seftence, 2014.
Planning Director Examined and approved this 15 day of AUGUST, 2014. City Surveyor
All taxes, fees, assessments, or other charges as required by O.R.S. 92.095 have been paid as of $9/15/14$
Tax Collector Date Mr. Whigh Deputy Assessor Date
Recorder:
Filed for record this 15 th day of September, 2014 at 3:050'clock P. M. and recorded as Partition Plat No. P-25-2014 of the Records of Jackson County, Oregon, Index Volume 25, Page 25.
Christine D. Walker Jean Shingk County Clerk Deputy
County Surveyor's File No. 21563
Declaration:
KNOWN ALL MEN BY THESE PRESENTS, that Larry D. Shirley and Dorothy E. Shirley successors in Trust under the Shirley Loving Trust dated November 1, 1991 and are amendments thereto are the owners of the lands hereon described, and that they partitioned the same into parcels as shown hereon and the number and size of the and the courses and lengths of the lines are plainly set forth and that this plat is representation of the Partition and do hereby grant to the City of Medford, a Munice Corporation the Storm Water Easement for a detention and and access for maintain

ey or their d any ey have the parcels t is a correct lunicipal aintenance as shown hereon

State of Oregon) County of Jackson)

Larry D. Shirley, personally appeared before me on this day of lot August 2014, does acknowledge the forgoing instrument to be his voluntary act the Shirley Loving Trust dated November 1, 1991.

ANITA JOYGE CALLANAN

NOTARY PUBLIC - OREGON OCHMISSION NO. 453393

MY COMMISSION EXPIRES NOVEMBER 04, 2014

Notary Public - Oregon Commission NO. November 4,2014

State of Oregon

My commission expires

County of Jackson) Dorothy E. Shirley, personally appeared before me on this day of Lat Hugust and does acknowledge the forgoing instrument to be his voluntary act and deed as Trustee of the Shirley Loving Trust dated November 1, 1991.

Month, Day, Year

Notary Public - Oregon Commission NO.


November 4,2014 My commission expires Month, Day, Year

ASSESSORS MAP FILE NO. 37 2W 25CC TL 5913

Surveyor's Certificate:

I, Herbert A. Farber, a duly registered Professional Land Surveyor of the State of Oregon, do hereby certify that I have correctly surveyed and marked with proper monuments, as provided by law, the tract of land hereon shown, this plat being a correct representation of the same, and the following is an accurate description of the boundary lines.

Beginning at a 5/8 inch iron pin marking the Southwest corner of Parcel 2 of Partition Plat No. P-58-2001, recorded in the records of Jackson County, Oregon, Index Volume 12, Page 58, Jackson County Surveyor File Number 17109 and the INITIAL POINT; thence North 00°02'07" West, along the West boundary of said parcel, 174.94 feet: thence South 89°59'35"West, along the boundary of the tract described in Instrument No. 2002-30013 of the Official Records of said County and State, 60.00 feet; thence North 00°02'07" West along said boundary, 200.08 feet to the south boundary of Cherry Park a subdivision recorded in the Volume 28, Page 26 of Plat Records of said County and State; thence North 89°55'18" East, along said south boundary, 60.00 feet, to a point on the West line of Parcel 1 of said Partition; thence continuing along said West line, South 00°02'07" East, 61.14 feet; thence South 70°19'52" East, along the Southwesterly boundary of said parcel, 25.82 feet; thence South 4218'55" East, along said Southwesterly boundary, 20.29 feet to the Westerly right-of-way line of Colinwood Court; thence along said right-of-way line, along the arc of a curve to the left, having a radius of 51.00 feet, an internal angle of 95°09'08" and an arc length of 84.70 feet (the long chord of which bears South 00°32'59" East, 75.29 feet); thence continuing along said right—of—way line, along the arc of a curve to the right, having a radius of 20.00 feet, an internal angle of 48°00'29" and an arc length of 16.76 feet (the long chord of which bears South 24°07'19" East, 16.27 feet); thence continuing along said right-of-way line, South 00°07'04" East, 180.05 feet; thence along the arc of a curve to the right, having a radius of 20.00 feet, an internal angle of 90°04'02" and an arc length of 31.44 feet (the long chord of which bears South 44°54'57" West, 28.30 feet) to a point on the North right-of-way line of Dakota Avenue; thence along said North right-of-way line, South 89°56'58" West, 25.54 feet to THE POINT OF BEGINNING.

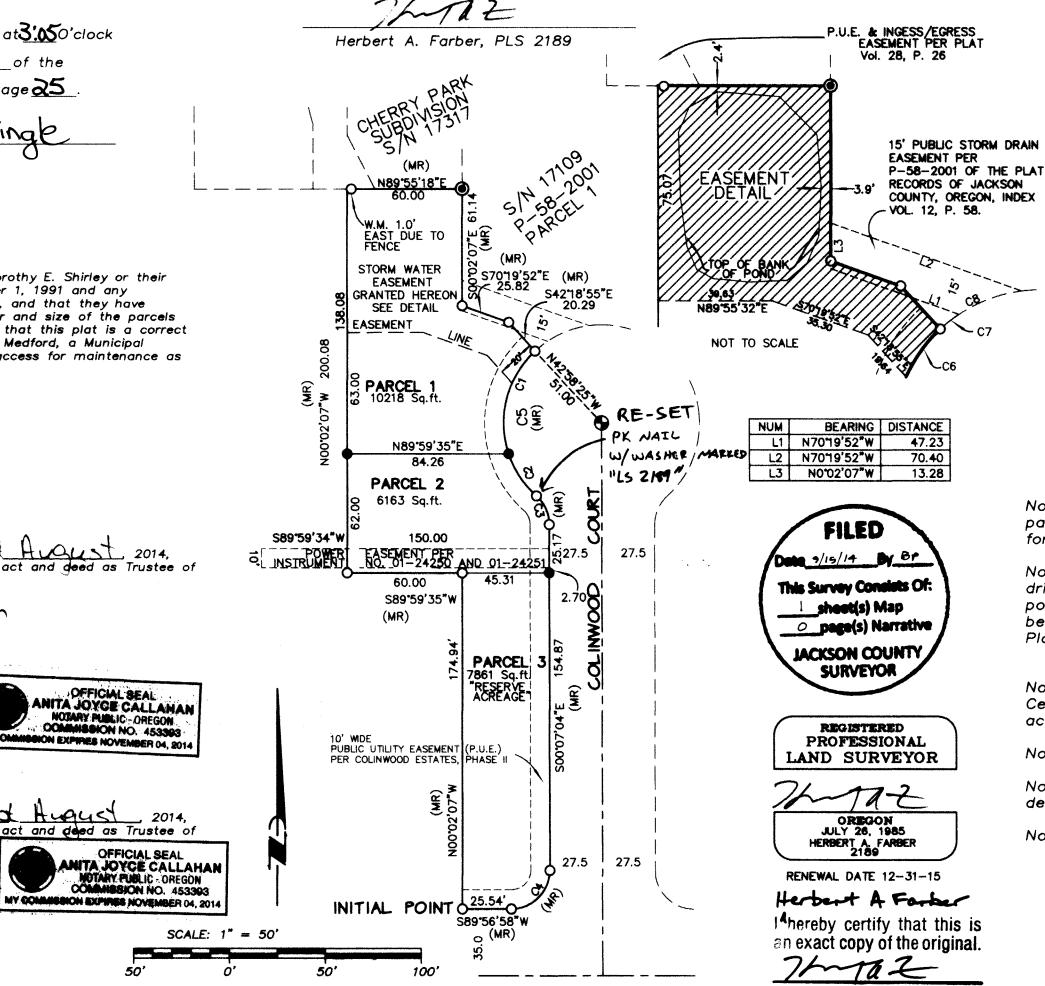

DAKOTA AVENUE

SHEET 1 OF 1

PARTITION PLAT No. P-25-2014

located in

SOUTHWEST ONE-QUARTER OF SECTION 25, TOWNSHIP 37 SOUTH, RANGE 2 WEST, WILLAMETTE MERIDIAN, IN THE CITY OF MEDFORD, JACKSON COUNTY, OREGON for

AMERICAN BUILDING COMPANY, INC.

1588 UPLAND PLACE MEDFORD, OREGON 97504

LEGEND

- = FOUND 5/8" IRON PIN W/ YELLOW CAP MARKED "FARBER PLS 2189" PER S/N 16538 - STREET CENTERLINE
- FOUND 5/8" IRON PIN, L.S. 2189, PER S/N 16538, 17109 and 21388. OR AS DESCRIDED
- SET 5/8" x 24" IRON PIN w/ YELLOW PLASTIC CAP MARKED "FARBER PLS 2189"
- = FOUND 5/8" IRON PIN, MARKED "D MCMAHAN LS 1913" PER S/N 15366
- RECORD FILED SURVEY NUMBER
- = WITNESS MONUMENT = MEASURED AND RECORD
- BASIS OF BEARING IS TRUE NORTH, NAD 83/91 DATUM, AS DERIVED BY GLOBAL POSITIONING SYSTEM OBSERVATIONS.
- RECORD SURVEY DATA IS SHOWN IN PARENTHESIS ADJACENT TO MEASURED SURVEY DATA WHERE APPLICABLE MR = Measured and Record S/N 21388.
- INST. No. ≠ INSTRUMENT NUMBER AS RECORDED IN THE OFFICIAL RECORDS OF JACKSON COUNTY, OREGON.

CURVE TABLE

NUM	DELTA	ARC	RADIUS	BEARING	DISTANCE
C1	6518'24"	58.13	51.00	S14'22'23"W	55.04
C2	29"50'44"	26.57	51.00	S3312'11"E	26.27
C3	48'00'29"	16.76	20.00	N24'07'19"W	16.27
C4	90'04'02"	31.44	20.00	N44'54'57"E	28.30
C5	95"09"06"	84.70	51.00	S0'32'59"E	75.29
C6	23'08'53"	20.61	51.00	S35"27"08"W	20.47
C7	919'37"	12.45	76.50	S51*41*27*W	12.44
C8	26"22"58"	35.23	76.50	S69'32'44"W	34.92

SURVEY NARRATIVE TO COMPLY WITH O.R.S. 209.250

Purpose: This survey has been conducted to monument the partition as approved by City of Medford File No LDS14-022.

Procedure: The boundary of this partition plat was completed and filed as S/N 21388 or as amended by Affidavits of Corrections. The deviation of that survey was the discovery that the northwest corner of this tract is a witness corner and not at the title as shown hereon. The new lot lines were established per approval by the City.

NOTES PER THE CITY OF MEDFORD:

Note 1: Parcels 1 and 2 shall have only one driveway per parcel. (Final Order of City of Medford Planning Commission for LDS-14-022 dated May 22, 2014.)

Note 2; Developer shall construct a standard shared driveway approach to serve the access road to the detention pond and the home on Parcel 1. Shared driveway width shall be no greater than 24 feet. (Final Order of City of Medford Planning Commission for LDS-14-022 dated May 22, 2014.)

Note 3; Deed Declaration pertaining to the withholding of Certificate of Occupancy for Parcel One until completion and acceptance of the sidewalk and driveway. Recorded as Inst.

No. 2014-024348.

Note 4; Restrictive Covenant pertaining to prohibiting development of Parcel 3, Reserve Acreage, Recorded as Inst.

No. <u>2014</u> - 024349

Surveyed by: FARBER & SONS, INC. dba FARBER SURVEYING (541) 664-5599

PO BOX 5286 431 OAK STREET CENTRAL POINT, OREGON 97502

SCALE: 1" = 50' DATE: JUNE 04, 2014 JOB NO.: 0169-90B DRAWING FILE: X: \JOBS\Medford_SW\Cherry Steet\Colinwood\FINAL PLATS\FINAL040813.dwg