


MAP OF SURVEY
 located in the
 NORTHWEST QUARTER OF SECTION 32,
 TOWNSHIP 37 SOUTH, RANGE 2 WEST,
 WILLAMETTE MERIDIAN, IN THE CITY OF JACKSONVILLE
 JACKSON COUNTY, OREGON

for
MICHAEL McCASKILL

340 S. FIFTH STREET
 JACKSONVILLE, OREGON 97530

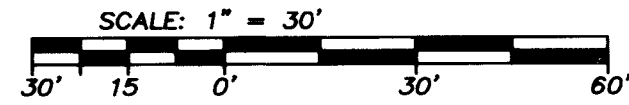

BASIS OF BEARING
 IS TRUE NORTH,
 NAD 83/91 DATUM,
 AS DERIVED BY
 GLOBAL POSITIONING
 SYSTEM
 OBSERVATIONS.



LEGEND

- X = COMPUTED POSITION
 - = SET 5/8" x 24" IRON PIN w/ YELLOW PLASTIC CAP MARKED "FARBER PLS 2189"
 - ⊙ = FOUND 5/8" IRON PIN w/ YELLOW PLASTIC CAP MARKED "FARBER PLS 2189"
 - = FOUND IRON PIN, AS DESCRIBED
 - S/N = RECORDED SURVEY NUMBER
 - = STREET CENTERLINE
 - JCPR = JACKSON COUNTY PLAT RECORDS
- RECORD SURVEY DATA IS SHOWN IN PARENTHESIS ADJACENT TO MEASURED SURVEY DATA WHERE APPLICABLE PER McCULLEY ADDITION VOL. 4 PAGE 10 OF THE JCPR, OR AS NOTED.
- INST. NO. = INSTRUMENT NUMBER AS RECORDED IN THE OFFICIAL RECORDS OF JACKSON COUNTY, OREGON.

**SURVEY NARRATIVE
 TO COMPLY WITH O.R.S. 209.250**

PURPOSE:

The purpose of this survey was to establish and monument the boundary described in Inst. No.: 2014-030778 recorded in the Official Records in the office of the Clerk in Jackson County Oregon.

PROCEDURE:

Utilizing Monuments found from S/N 6701, S/N 7281, S/N 14994, S/N 16398, and S/N 21506 we established the center line locations for Fourth Street, Pine Street, Fir Street and Fifth Street. Once the centerline locations were established we held the 30 foot right of way width along each centerline to determine the dimensions for Block 32. To get the dimensions of the lots we proportioned the width and depth based on the McCULLEY ADDITION Subdivision plat filed in Volume 4 Page 10 of the Jackson County Plat Records. We found the Southwest Lot corner of Lot 6 and set a monument on each of the remaining corners of Lot 6 as shown hereon.

Surveyed by:
 FARBER & SONS, INC. dba



PO BOX 5286
 431 OAK STREET
 CENTRAL POINT, OREGON 97502
 (541) 664-5599

REGISTERED
 PROFESSIONAL
 LAND SURVEYOR

Herbert A. Farber
 OREGON
 JULY 26, 1985
 HERBERT A. FARBER
 2189

RENEWAL DATE 12-31-15

RECEIVED
 DATE 2/5/15 BY PB
 FILED
 DATE 2/5/15 BY PB
 This survey consists of:
 1 sheet(s) Map
 2 page(s) Narrative
 JACKSON COUNTY
 SURVEYOR

DATE: DECEMBER 30, 2014
 JOB NO.: 2309-14
 DRAWING FILE: JOBS\Jacksonville\South 5th st\340 S. 5th st\McCaskill\
 MicroSurvey\Final Plats Surveys\MOS 123014.dwg
 DRAWN BY: LSH ORIG. DATE: 12/30/2014 REVISED BY: DATE: