

MAP OF SURVEY
 located in the
 SECTION 19, 20, 29 AND 30
 TOWNSHIP 37 SOUTH, RANGE 3 WEST,
 WILLAMETTE MERIDIAN, JACKSON COUNTY, OREGON

for
**HANCOCK FOREST
 MANAGEMENT INC.**

572 PARSONS DRIVE, STE 124
 MEDFORD, OREGON 97501

LEGEND

- ⊠ = FOUND 3" B.L.M. BRASS CAP - SECTION CORNER
 - ⊕ = FOUND 2 1/2" BRASS CAP JACKSON COUNTY SURVEYOR MONUMENT
RE-ESTABLISHMENT DATE NOTED HEREON.
 - ⊙ = FOUND 2 1/2" POT METAL FILLED REDUCER PER S/N 4741
 - = FOUND 5/8" IRON PIN, w/ YELLOW PLASTIC CAP MARKED
"NYGREN LS 1035"
 - ⊙ = FOUND 5/8" IRON PIN PER S/N 9513, MISSING YELLOW PLASTIC CAP
 - = FOUND 5/8" IRON PIN, (BENT) CAP MISSING PER S/N 9495
 - S/N = RECORD FILED SURVEY NUMBER
- RECORD SURVEY DATA IS SHOWN IN PARENTHESIS ADJACENT TO MEASURED
SURVEY DATA WHERE APPLICABLE.

**SURVEY NARRATIVE
 TO COMPLY WITH O.R.S. 209.250**

Purpose: This survey was conducted to mark the lines shown hereon per Hancock Forest Management Inc. standards. This map is a consolidation of three jobs; Bob's Bunion, G Troop, and Toe pond/Toe Mech.


Procedure: This survey was conducted using Trimble GPS 5800 and R-8 receivers and Trimble 5600 robotic total station. The survey was ran as a closed survey shown hereon. After we tied the found monuments we marked the line between said monuments. No Monuments were set on this survey.

Surveyed by:
 FARBER & SONS, INC. dba


**FARBER
 SURVEYING**
 PO BOX 5286
 431 OAK STREET
 CENTRAL POINT, OREGON 97502
 (541) 664-5599

DATE: MAY 15, 2015
 JOB NO.: 2260-14, 2264-14, 2266-14
 DRAWING FILE: JOBS\HANCOCK FOREST\BOB'S BUNION 2260-14\
 MOS FOOTS CREEK 063015.DWG

DRAWN BY: LSH ORIG. DATE: 05/15/2015 REVISED BY: LSH DATE: 06/30/2015

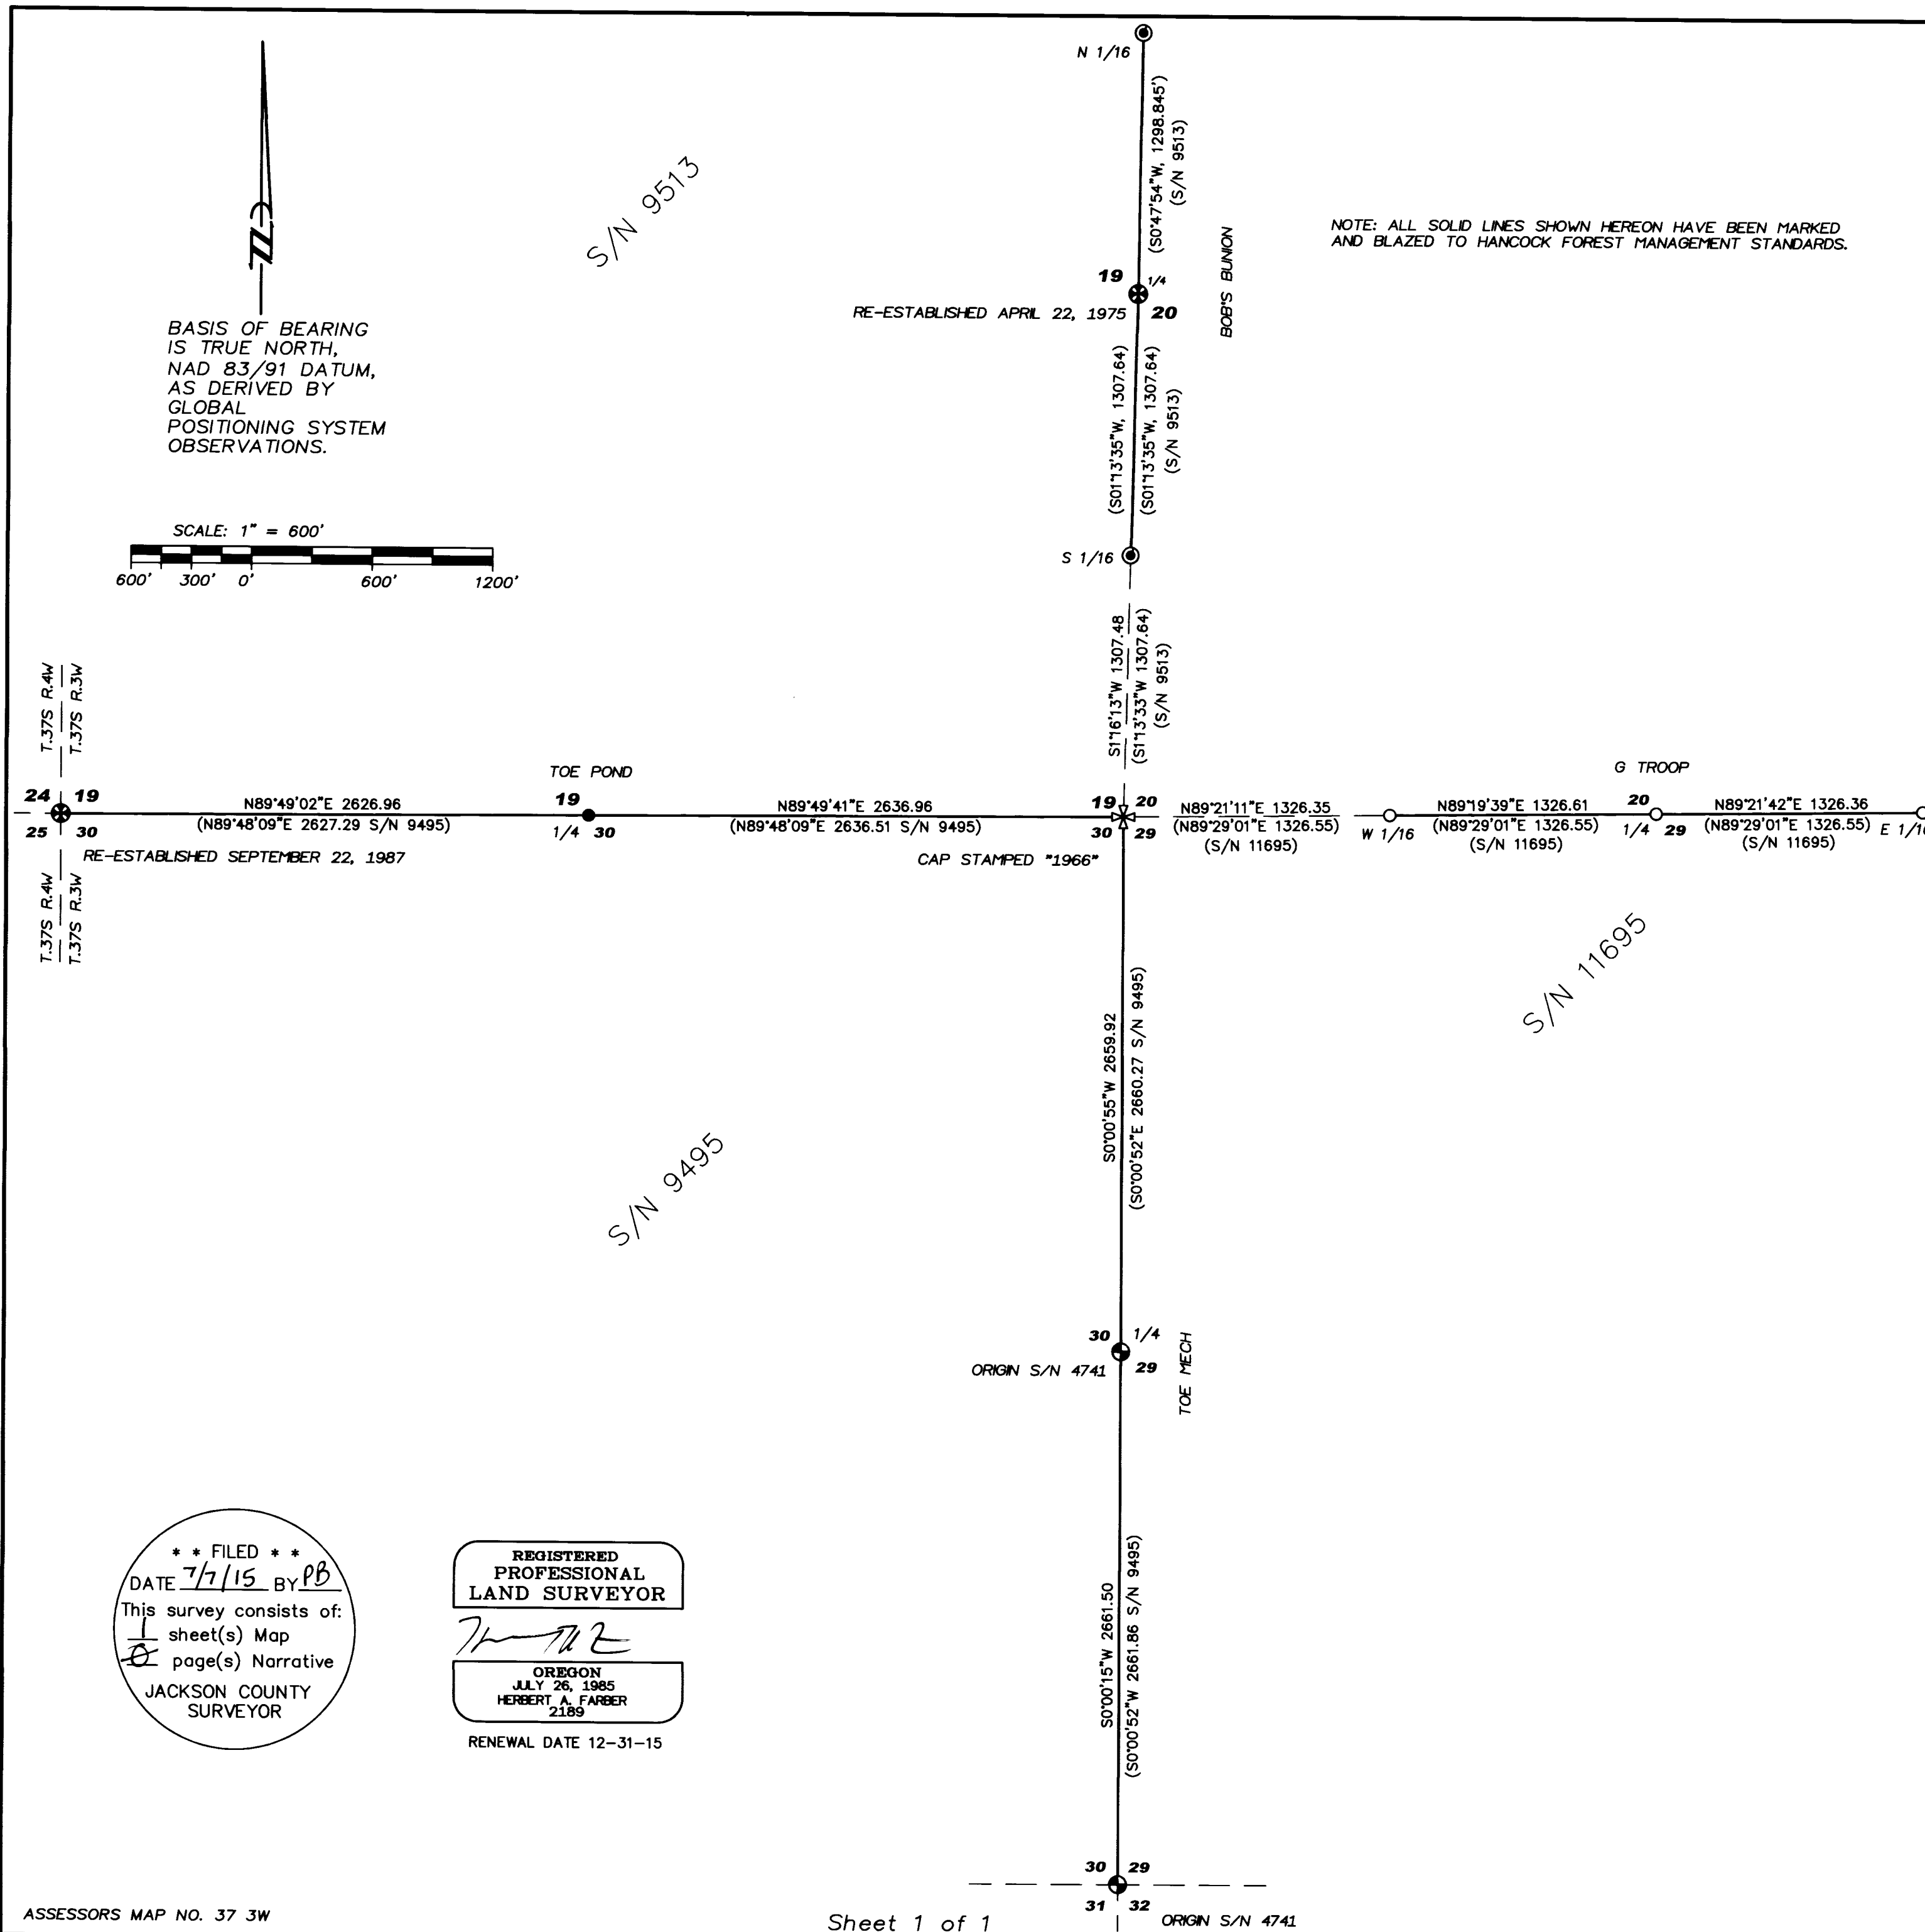

BASIS OF BEARING
 IS TRUE NORTH,
 NAD 83/91 DATUM,
 AS DERIVED BY
 GLOBAL
 POSITIONING SYSTEM
 OBSERVATIONS.

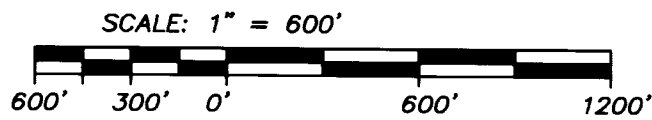

NOTE: ALL SOLID LINES SHOWN HEREON HAVE BEEN MARKED
 AND BLAZED TO HANCOCK FOREST MANAGEMENT STANDARDS.

**** FILED ****
 DATE 7/7/15 BY PB
 This survey consists of:
1 sheet(s) Map
1 page(s) Narrative
 JACKSON COUNTY
 SURVEYOR

**REGISTERED
 PROFESSIONAL
 LAND SURVEYOR**

OREGON
 JULY 26, 1985
 HERBERT A. FARBER
 2189
 RENEWAL DATE 12-31-15