
ASSESSORS MAP NO. 37 1W 22AC - TL 5206

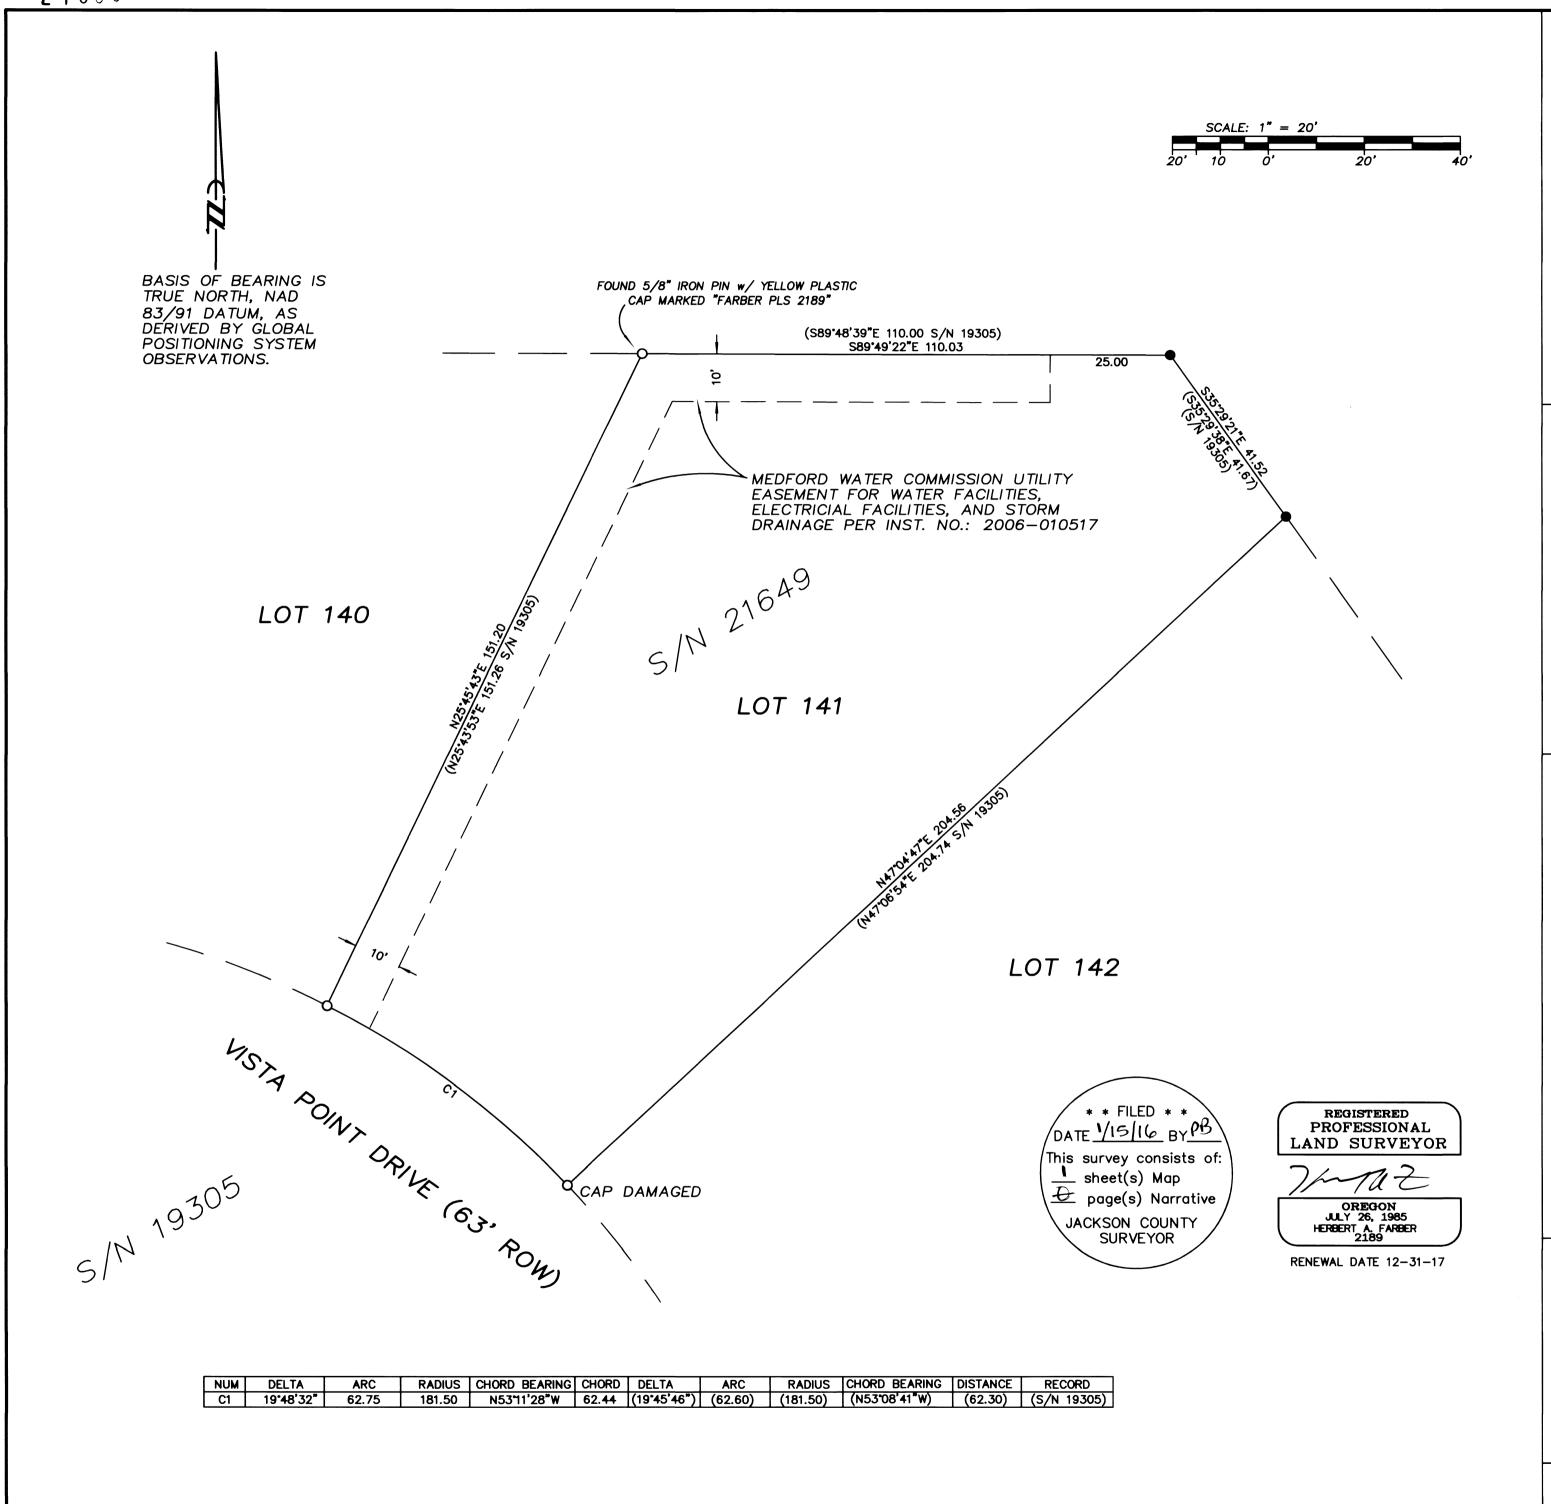

Sheet 1 of 1

MAP OF SURVEY

located in the

NORTHEAST QUARTER OF SECTION 22, TOWNSHIP 37 SOUTH, RANGE 1 WEST, WILLAMETTE MERIDIAN, CITY OF MEDFORD JACKSON COUNTY, OREGON

for

WHITTLE CONSTRUCTION, INC.

2597 WHITTLE AVE. MEDFORD, OREGON 97504

LEGEND

- = FOUND 5/8" IRON PIN w/ YELLOW PLASTIC CAP MARKED "HOFFBUHR AND ASSOC.". OR AS DESCRIBED
- = SET 5/8" x 24" IRON PIN w/ YELLOW PLASTIC CAP MARKED "FARBER PLS 2189"
- S/N = RECORD FILED SURVEY NUMBER
- LOT NUMBERS ARE LOTS PER FOREST RIDGE AT VISTA POINTE, PHASE 7 PER VOL. 32 PG. 68 JACKSON COUNTY PLAT RECORDS ALSO RECORDED AS S/N 19305
- RECORD SURVEY DATA IS SHOWN IN PARENTHESIS ADJACENT TO MEASURED SURVEY DATA WHERE APPLICABLE.
- INST. NO. = INSTRUMENT NUMBER AS RECORDED IN THE OFFICIAL RECORDS OF JACKSON COUNTY, OREGON.

SURVEY NARRATIVE TO COMPLY WITH O.R.S. 209.250

Purpose: This survey has been conducted to re-set the Northeasterly Lot corners as shown heron of Lot 141 of FOREST RIDGE AT VISTA POINTE, PHASE 7, recorded in Volume 32, Page 68 of the Plat Records of Jackson County, Oregon, also filed as S/N 19305 in the Jackson County Surveyors Office.

Procedure: These corners were destroyed by landscape construction. They were tied by this office while performing S/N 21649 and have been re-set at the same position as tied, utilizing Trimble GPS Static and RTK survey.

> Surveyed by: FARBER & SONS, INC. dba



431 OAK STREET CENTRAL POINT, OREGON 97502 (541) 664-5599

DATE:

December 9, 2015

JOB NO.: 2303 - 14

DRAWING FILE: JOBS\Medford_NE\Vista Pointe Dr\4426 Vista Pointe\Whittle Const. 2303-14\MicroSurvey\Final Plats Surveys\Whittle MOS 102015.DWG

DRAWN BY: haf ORIG. DATE: 10/20/2015 | REVISED BY: haf DATE: 12-10-15