


BASIS OF BEARING IS TRUE NORTH, NAD 83/91 DATUM, AS DERIVED BY GLOBAL POSITIONING SYSTEM OBSERVATIONS.

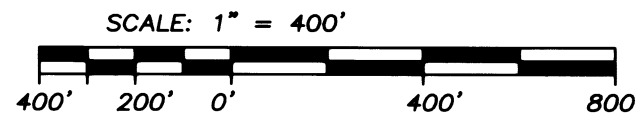

NOTE: ALL SOLID LINES SHOWN HEREON HAVE BEEN MARKED AND BLAZED TO HANCOCK FOREST MANAGEMENT STANDARDS.

**** FILED ****
 DATE 3/1/16 BY PB
 This survey consists of
1 sheet(s) Map
0 page(s) Narrative
 JACKSON COUNTY SURVEYOR

REGISTERED PROFESSIONAL LAND SURVEYOR

OREGON
 JULY 26, 1985
 HERBERT A. FARBER
 2189
 RENEWAL DATE 12-31-17

AP TIMBER LLC
 HANCOCK FOREST MANAGEMENT
 INST. NO. 2013-024796

FOUND 3" BRASS CAP SET BY JACKSON COUNTY SURVEYOR, STAMPED "T32S R3E 22, 23, 27, 26 C.S. 1981" PER JACKSON COUNTY RE-ESTABLISHMENT NOTES

22 23
 27 26

N89°44'26"E 5249.42
 (N89°50'00"E 5269.44)

±2000 FEET OF LINE MARKED AND BLAZED

23 24
 26 25

FOUND 2 1/2" BRONZE DISK, STAMPED "T32S R3E 23, 24, 25, 26 JACKSON COUNTY 1976" PER JACKSON COUNTY RE-ESTABLISHMENT NOTES

FOUND IRON PIPE WITH 2 1/2" POT METAL CAP, STAMPED "SE COR NE 1/4 NE 1/4 S23 T32S R3E 1/16 COR CS 1956" PER JACKSON COUNTY RE-ESTABLISHMENT NOTES AND S/N 828

N 1/16 TO SEC. 23/24

N107°58'W 1328.45
 (N106°00'W 1330.10)
 (N0°00'00"W 1320.00)

FOUND IRON PIPE WITH 2 1/2" POT METAL CAP, STAMPED "T32S R3E 23/24 1/4 COR CS 1956" PER JACKSON COUNTY RE-ESTABLISHMENT NOTES AND S/N 828

MONUMENT WAS FOUND BENT TO THE WEST. TIED LOCATION OF SPIN HOLE AT VERTICAL.

N025°12'E 2671.80
 (N0°00'00"E 2640.00)

MAP OF SURVEY
 located in the
 SECTION 23
 TOWNSHIP 32 SOUTH, RANGE 3 EAST,
 WILLAMETTE MERIDIAN, JACKSON COUNTY, OREGON
 for
HANCOCK FOREST MANAGEMENT INC.
 572 PARSONS DRIVE, STE 124
 MEDFORD, OREGON 97501

LEGEND

- ✱ = FOUND SECTION CORNER RE-ESTABLISHED BY JACKSON COUNTY SURVEYOR AS NOTED
- ∧ = FOUND ONE-QUARTER CORNER RE-ESTABLISHED BY JACKSON COUNTY SURVEYOR AS NOTED, AND SHOWN ON S/N 828
- ⊙ = FOUND ONE-SIXTEENTH CORNER RE-ESTABLISHED BY JACKSON COUNTY SURVEYOR AS NOTED, AND SHOWN ON S/N 828
- () = RECORD SURVEY DATA PER ORIGINAL GLO NOTES
- [] = RECORD SURVEY DATA PER S/N 828
- S/N = RECORD FILED SURVEY NUMBER
- INST. NO. = INSTRUMENT NUMBER AS RECORDED IN THE OFFICIAL RECORDS OF JACKSON COUNTY OREGON
- = LINE MARKED AND BLAZED PER CLIENTS REQUEST

SURVEY NARRATIVE TO COMPLY WITH O.R.S. 209.250

Purpose: This survey was conducted to mark the lines shown hereon per Hancock Forest Management Inc. standards. The project name for this site is Thunder Road.

Procedure: This survey was conducted using Trimble GPS 5800 and R8 receivers combined with a Trimble 5603 robotic total station. The survey was ran as a closed survey as shown hereon. We found the Southwest corner, the Southeast corner, the East One-Quarter corner of Section 23, and the North One-Sixteenth corner common to Section 23 and 24 as remonumented by Jackson County Surveyor in 1981, 1976, and 1956 respectively. After we tied the established monuments we marked the line between said monuments. No Monuments were set on this survey.

Surveyed by:
 FARBER & SONS, INC. dba



PO BOX 5286
 431 OAK STREET
 CENTRAL POINT, OREGON 97502
 (541) 664-5599

DATE: FEBRUARY 09, 2016
 JOB NO.: 2015-2432
 DRAWING FILE: JOBS\Hancock Forest\Thunder Road\base011416.DWG
 DRAWN BY: MCW ORIG. DATE: 2/09/2016 REVISED BY: DATE: