


DETAIL 'A'

SCALE 1'' = 30'

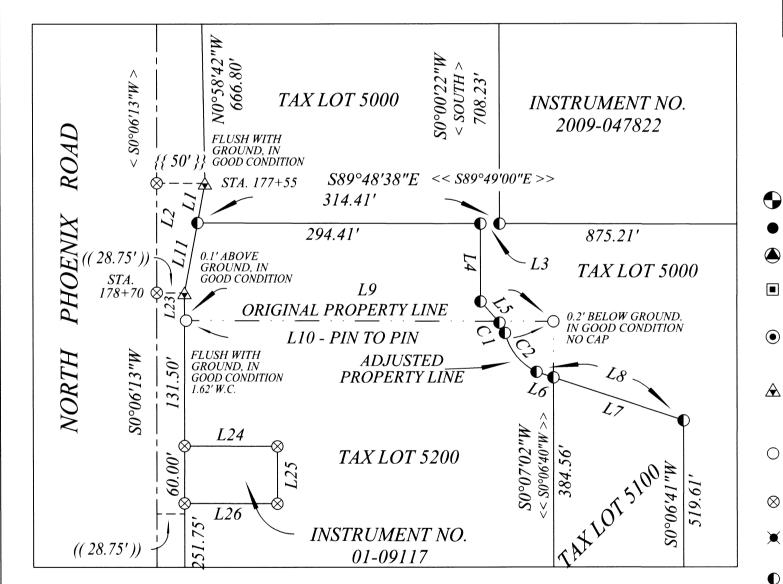

DETAIL 'B'

SCALE 1" = 100'

Assessor's Plat No. 371W34, Tax Lots 5000, 5100 & 5200

LINE	BEARING	RECORD	DISTANCE	LINE	BEARING	RECORD	DISTANCE
<i>L1</i>	S10°34'22"W		42.26'	L9	N89°48'38"W	<< N89°49′00″W>>	383.98′
L2	S10°34'22"W		116.95'	L10	N89°48'38"W	<< N89°49′00″W>>	382.45'
L3	S89°48'38"E	<< S89°49′00″E >>	20.90'	L11	S10°34'22"W		74.69′
L4	S0°00'22"W		81.72'	L23	S0°06′13″W		28.84'
L5	S41°44'03"E		29.65'	L24	N89°48'38"W	<< N89°49′00″W>>	96.61'
<i>L6</i>	S71°34'33"E		18.53'	L25	S0°06'31"W	<< S0°06'21"W>>	60.00′
<i>L7</i>	S71°34'33"E		142.76′	L26	N89°48'38"W	<< N89°49′00″W>>	96.61'
L8	S71°34'33"E		161.29'			•	•

S2°10'26"W]] ((28.75'))*TAX LOT 5100* **PHOENIX** FOUND SQUARE HEAD BOLT, FLUSH WITH GROUND. FOUND 5/8" REBAR, 1' BELOW A PILE OF RUBBLE, LEANING IN GOOD CONDITION. SOUTHERLY, USED POINT OF ENTRY. PER S.N. 917 N.W. CORNER D.L.C. NO. 53 (30') R&M BASIS OF BEARING **NORTH** (S89°53'10"E) R&M *"W* (2240.00') R&M INSTRUMENT NO. 2017-021017 ((28.75'))

STA. 180+00

DETAIL 'C' *SCALE 1''* = 30'

LEGEND

	_		
	FOUND MONUMENT AS NOTED	()	SURVEY DATA PER S.N. 917
	FOUND REBAR AS NOTED	1 1	SURVEY DATA PER S.N. 4360
	FOUND MONUMENT AS NOTED	{ }	SURVEY DATA PER S.N. 4361
	FOUND 5/8" REBAR, AS NOTED. PER S.N. 4360	< >	RECORD DATA PER JOURNAL VOUCHER NUMBER 79-02841
	FOUND 5/8" REBAR WITH YELLOW PLASTIC CAP, "L.J. FRIAR & ASSOC	(())	RECORD SURVEY DATA PER O.D.O.T. MAP 10B-4-3, DATED FEBRUARY 1993
	OR AS NOTED. PER S.N. 15306	[[]]	SURVEY DATA PER S.N. 15306
	FOUND 5/8" REBAR WITH YELLOW PLASTIC CAP, "JACKSON CO. RDS & PKS SIC", PER S. N. 15200	{{ }}}	SURVEY DATA PER S.N. 15308
	PKS SVC". PER S.N. 15308	<< >>	SURVEY DATA PER S.N. 16833
	FOUND 5/8" REBAR WITH YELLOW PLASTIC CAP, "L.J. FRIAR & ASSOC	", D.L.C.	DONATION LAND CLAIM
	FLUSH WITH GROUND IN GOOD CONDITION OR AS NOTED, PER S.N. 1	6833 R& M	RECORD AND MEASURED
		S. N.	SURVEY NUMBER
	CALCULATED POSITION CALCULATED POSITION,	O.D.O.T.	OREGON DEPARTMENT OF TRANSPORTATION
1	NOTHING FOUND OR SET	C.B.	CHORD BEARING

DEED LINE D.L.C. LINE

PROFESSIONAL SUBJECT PROPERTY LAND SURVEYOR sun an. anarts **OREGON** ROAD CENTER LINE MAY 8, 2012 JASON M. MARTIN 54729

RENEWS: 1/1/2019

REGISTERED

CURVE	Δ	RADIUS	ARC LENGTH	CHORD BEARING	LONG CHORD
C1	28°04'21"	25.00'	12.25'	S27°41'53"E	12.13'
C2	50°10′19″	61.70′	54.03'	S38°44'51"E	52.32'

NARRATIVE ON SEPARATE SHEET

TO THE POINT LAND SURVEYING

SET 5/8" X 30" REBAR WITH ORANGE PLASTIC

CAP STAMPED "J. MARTIN, PLS 54729"

PROPERTY LINE ADJUSTMENT / MAP OF SURVEY


LOCATED WITHIN

SOUTH HALF OF SECTION 34, TOWNSHIP 37 SOUTH, RANGE 1 WEST, WILLAMETTE MERIDIAN, JACKSON COUNTY, OREGON

FOR

RANIA SAWABINI

203 REBECCA DRIVE SAN DIMAS, CA 91173

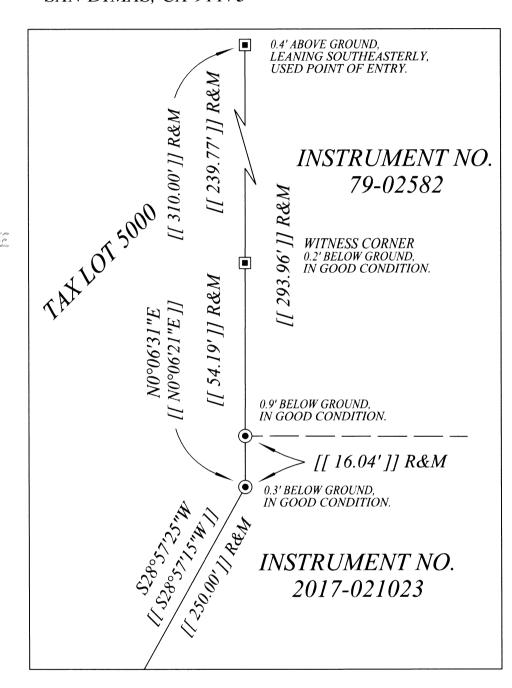

* RECEIVED * * Date 10/24/17 By PB This survey consists of $\underline{2}$ sheet(s) Map 2 page(s) Narrative

DETAIL 'D'

SCALE 1'' = 30'

JACKSON COUNTY
SURVEYOR

SURVEYED BY:

TO THE POINT LAND SURVEYING, LLC P.O. BOX 217 GOLD HILL, OR 97525 (541) 840-7587

> Date: July 21, 2017 Project No. 0037-17

2/2

SURVEY NARRATIVE

TO COMPLY WITH O.R.S. 209.250

DATE: JULY 21, 2017

SURVEY FOR: RANIA SAWABINI

203 REBECCA DRIVE SAN DIMAS, CA 91173

SURVEY BY: TO THE POINT LAND SURVEYING, LLC

P.O. BOX 217

GOLD HILL, OREGON 97525

LOCATION: THE SOUTH HALF OF SECTION 34, TOWNSHIP 37 SOUTH, RANGE 1 WEST,

 $WILLAMETTE\ MERIDIAN,\ JACKSON\ COUNTY,\ OREGON.$

PURPOSE: TO SURVEY AND MONUMENT A PROPERTY LINE ADJUSTMENT BETWEEN THREE PIECES

OF LAND RECORDED IN DOCUMENT NUMBERS 01-09117 AND 02-04603 OF THE OFFICIAL RECORDS OF JACKSON COUNTY, OREGON AND PARCEL ONE OF JOURNAL VOUCHER 79-02841 AS DETERMINED BY THE JACKSON COUNTY PLANNING DEPARTMENT, FILE NUMBER

439-16-01783-ZON, PER THE REQUEST OF THE CLIENT.

PROCEDURE: THIS SURVEY WAS CONDUCTED USING A LEICA TCRP 1203+ ROBOTIC TOTAL STATION,

DISTANCE PRISMS AND A LEICA CS15 DATA COLLECTOR. THE BASIS OF BEARING HELD IS THE NORTHERLY PROPERTY LINE OF INSTRUMENT NUMBER 2017-021017 RECORDED IN THE OFFICIAL RECORDS OF JACKSON COUNTY, OREGON DEFINED BETWEEN THE FOUND MONUMENTS OF SURVEY NUMBER 917 FILED IN THE JACKSON COUNTY, OREGON

SURVEYORS OFFICE.

THE EASTERLY RIGHT OF WAY LINE OF NORTH PHOENIX ROAD WAS HELD PER OREGON DEPARTMENT OF TRANSPORTATION ROLL MAP, 10B-4-3, DATED FEBRUARY, 1993 AND REVISED APRIL, 2001, ALSO USED WERE DOCUMENT NUMBERS 94-002879 AND 94-009038 AS RECORDED IN THE OFFICIAL RECORDS OF JACKSON COUNTY, OREGON. IT SHOULD BE NOTED THAT PREVIOUS SURVEYS UTILIZED THE DONATION LAND CLAIM (D.L.C.) LINE BETWEEN THE NORTHEAST CORNER OF D.L.C. 49 AND THE NORTHWEST CORNER OF D.L.C. 53 AS THE CENTER LINE OF NORTH PHOENIX ROAD. ACCORDING TO SURVEY 15308, THE D.L.C. LINE AND THE TRUE CENTERLINE ARE NOT THE SAME. NOR DO THEY HAVE THE SAME BEARING. THEREFORE, THE 5 FOOT WITNESS CORNERS SET ON SURVEY 16833 ARE NOT TRULY 5 FOOT AS INDICATED HEREON.

** RECEIVED **
Date 10/24/17 By PB
This survey consists of 2 sheet(s) Map
2 page(s) Narrative
JACKSON COUNTY

SURVEYOR

REGISTERED PROFESSIONAL LAND SURVEYOR

June an anatt

OREGON MAY 8, 2012 JASON M. MARTIN 54729

RENEWS: 1/1/2019

SURVEY NARRATIVE

TO COMPLY WITH O.R.S. 209.250

THE NORTHERLY PROPERTY LINE OF JOURNAL VOUCHER 79-02841 WAS HELD PER DOCUMENT NUMBER 2009-047822 ALSO BEING THE NORTHERLY PROPERTY LINE OF SAID DOCUMENT. THE EAST PROPERTY LINE OF PARCEL ONE OF SAID JOURNAL VOUCHER 79-02841 WAS HELD AT A RECORD DISTANCE FROM THE FOUND ORIGINAL NORTHWEST PROPERTY CORNER OF SAID DOCUMENT 2009-047822 AND PARALLEL WITH THE EAST PROPERTY LINE OF SAID DOCUMENT 2009-047822. THE SOUTHERLY PROPERTY LINE OF SAID JOURNAL VOUCHER, ALSO BEING THE SOUTHERLY PROPERTY LINE OF SAID DOCUMENT 2009-047822, WAS DETERMINED BY HOLDING THE FOUND NORTHEAST CORNER OF DOCUMENT NUMBER 02-04603 AND A RECORD BEARING EXTENDED TO THE EASTERLY RIGHT OF WAY LINE OF NORTH PHOENIX ROAD. RECORD DIMENSIONS ALONG THE SOUTHERLY PROPERTY LINE OF SAID DOCUMENT 02-04603 WERE HELD FOR DETERMINING SAID LINE. IT SHOULD BE NOTED THAT THESE RECORD MONUMENTS RUN ALONG THE SOUTHERLY TOE OF SLOPE OF THE MEDFORD IRRIGATION CANAL AND AN EXISTING FENCE, THESE COULD BE THE CAUSE OF MOST OF THE MONUMENTS TO BE SLIGHTLY OUT OF RECORD POSITION.

ALL OTHER MONUMENTS OF RECORD WERE UTILIZED FOR DETERMINING THE REMAINING PROPERTY BOUNDARY.

IT SHOULD ALSO BE NOTED THAT THE "X" IN THE BOTTOM OF THE CONCRETE IRRIGATION BOX AT THE NORTHEAST CORNER OF SAID DOCUMENT 09-047822 COULD NOT BE PROPERLY IDENTIFIED DUE TO THE DECAY OF AGED CONCRETE.

* * RECEIVED * * Date 10/24/17 By RB This survey consists of $\frac{2}{}$ sheet(s) Map 2 page(s) Narrative JACKSON COUNTY **SURVEYOR**

REGISTERED **PROFESSIONAL** LAND SURVEYOR

sura on anust

OREGON MAY 8, 2012 JASON M. MARTIN 54729

RENEWS: 1/1/2019