

BASIS OF BEARING IS TRUE NORTH, NAD 83/91 DATUM, AS DERIVED BY GLOBAL POSITIONING SYSTEM OBSERVATIONS.

MAP OF SURVEY

located in the

SOUTHWEST QUARTER OF SECTION 22,
TOWNSHIP 38 SOUTH, RANGE 03 EAST,
WILLAMETTE MERIDIAN, JACKSON COUNTY, OREGON

for

HANCOCK FOREST MANAGEMENT

572 PARSONS DR. STE. 124
MEDFORD, OREGON 97501

LEGEND

- = FOUND 2" ALUMINUM CAP-1/4 SECTION CORNER
- = FOUND 5/8" IRON PIN, PLASTIC CAP MARKED "ARTMAN RLS 2268"


S/N = RECORD FILED SURVEY NUMBER

- RECORD SURVEY DATA IS SHOWN IN PARENTHESIS ADJACENT TO MEASURED SURVEY DATA WHERE APPLICABLE.

CW 1/16 SEC 22

APPLIED BASIS OF BEARING

C 1/4 SEC 22

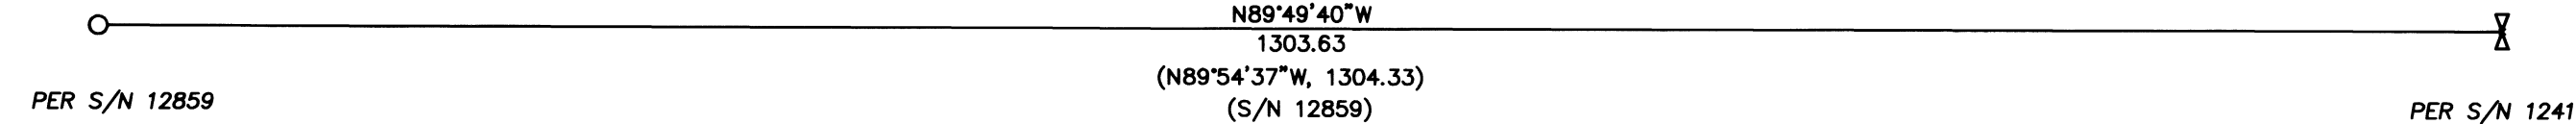

NOTE: LINES SHOWN HEREON HAVE BEEN MARKED AND BLAZED TO HANCOCK FOREST MANAGEMENT STANDARDS.

SURVEY NARRATIVE TO COMPLY WITH O.R.S. 209.250

PURPOSE: TO SURVEY AND MARK A PORTION OF THE BOUNDARY SHOWN, OF THAT PARCEL OF LAND DESCRIBED AS PARCEL 4, IN INSTRUMENT NUMBER 2012-026137, OF THE OFFICIAL RECORDS OF JACKSON COUNTY, OREGON. THE PROJECT NAME IS EAST INDIAN FINAL.

PROCEDURE: A FIELD SURVEY WAS CONDUCTED AND MONUMENTS OF RECORD WERE RECOVERED AND TIED AS SHOWN. A CLOSED TRAVERSE WAS RUN BETWEEN FOUND MONUMENTS, AND THE BOUNDARY LINE WAS BLAZED AND MARKED TO HANCOCK FOREST MANAGEMENT STANDARDS

Surveyed by:
FARBER & SONS, INC. dba



PO BOX 5286
431 OAK STREET
CENTRAL POINT, OREGON 97502
(541) 664-5599

DATE: NOVEMBER 3, 2017
JOB NO.: 2017-2647
DRAWING FILE: JOBS\HANCOCK\EAST INDIAN FINAL\MICRO\MOS_110317.DWG

DRAWN BY: DHM ORIG. DATE: 11/03/2017 REVISED BY: hgf DATE: 12/13/17

** FILED **
DATE 12/10/17 BY PB

This survey consists of:
1 sheet(s) Map
1 page(s) Narrative
JACKSON COUNTY SURVEYOR

REGISTERED PROFESSIONAL LAND SURVEYOR

OREGON
JULY 26, 1985
HERBERT A. FARBER
2189

RENEWAL DATE 12-31-17

