



BASIS OF BEARING IS TRUE NORTH, NAD 83/91 DATUM, AS DERIVED BY GLOBAL POSITIONING SYSTEM OBSERVATIONS.

NOTE: ALL SOLID LINES SHOWN HEREON HAVE BEEN MARKED AND BLAZED TO HANCOCK FOREST MANAGEMENT STANDARDS.

MAP OF SURVEY
 located in the
 NORTHEAST QUARTER OF SECTION 34
 TOWNSHIP 37 SOUTH, RANGE 4 WEST,
 WILLAMETTE MERIDIAN, JACKSON COUNTY, OREGON
 for
HANCOCK FOREST MANAGEMENT
 572 PARSONS DRIVE, STE 124
 MEDFORD, OREGON 97501

LEGEND

-  = FOUND 1/4 SECTION CORNER AS DESCRIBED
-  = FOUND 1/16 SECTION CORNER AS DESCRIBED
- RECORD SURVEY DATA IS SHOWN IN PARENTHESIS TO MEASURED SURVEY DATA AND IS IN REFERENCE TO ROLLIN D. AANRUD CADASTRAL SURVEY DATED 1977.

SURVEY NARRATIVE TO COMPLY WITH O.R.S. 209.250

PURPOSE: TO SURVEY AND MARK A PORTION OF THE BOUNDARY OF THAT TRACT OF LAND DESCRIBED AS TRACT 41.2, TAX LOT 11100, IN INSTRUMENT NUMBER 2017-10772, OF THE OFFICIAL RECORDS OF JACKSON COUNTY, OREGON. THE PROJECT NAME IS FOOTS 34.

PROCEDURE: A FIELD SURVEY WAS CONDUCTED AND MONUMENTS OF RECORD WERE RECOVERED AND TIED. A CLOSED TRAVERSE WAS RUN BETWEEN MONUMENTS AND THE BOUNDARY LINE WAS MARKED PER CLIENT INSTRUCTIONS AS SHOWN. INSTRUMENTS USED WERE TRIMBLE R10 GPS AND S6 TOTAL STATION. NO MONUMENTS WERE SET IN THIS SURVEY.


THIS PLAT WAS PREPARED WITH A CANON IPF-785 USING CANON NUMBER PFI-107BK AND PFI-107MBK INKJET ON 4 MIL DOUBLE MATTE INKJET FILM.

Surveyed by:
FARBER & SONS, INC. dba

 PO BOX 5286
 431 OAK STREET
 CENTRAL POINT, OREGON 97502
 (541) 664-5599

DATE: MAY 25, 2018
 JOB NO.: 2018-2757
 JOBS\Hancock Forest\FOOTS 34\MOS052518



DRAWN BY: AJP ORIG. DATE: 05/25/2018 EDITED BY: DATE:

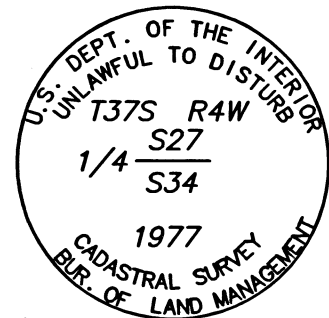

FOUND 3" BLM BRASS CAP

SECTION 27

APPLIED BASIS OF BEARING

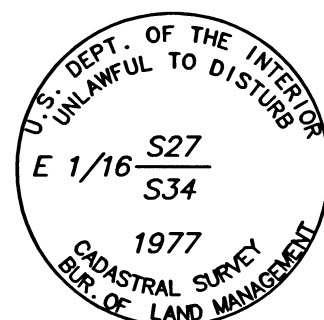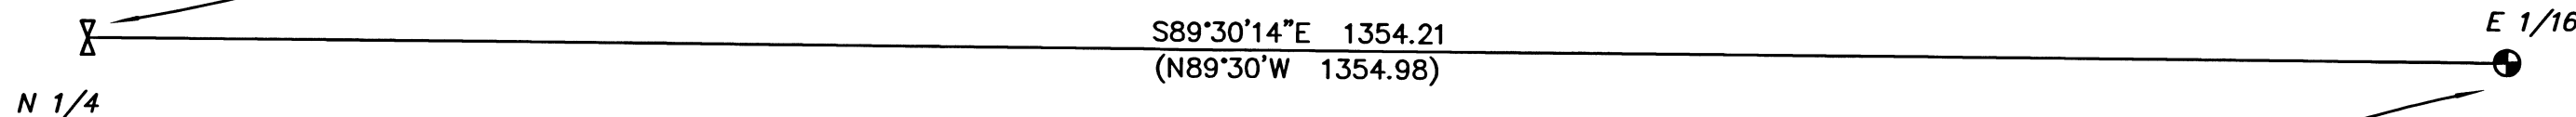


FOUND 3" BLM BRASS CAP

SECTION 34

REGISTERED PROFESSIONAL LAND SURVEYOR

Jason M. Martin
 OREGON
 MAY 8, 2012
 JASON M. MARTIN
 54729

RENEWS: 1/1/2019

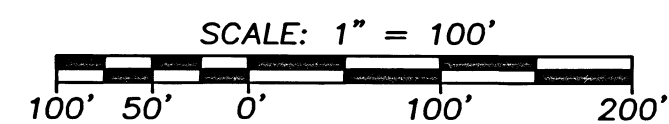

•• FILED ••
 DATE _____ BY _____
 •• FILED ••
 DATE 8/15/18 BY JMB
 This survey consists of:
 1 sheet(s) Map
 1 page(s) Narrative
 JACKSON COUNTY SURVEYOR