
ASSESSORS MAP NO. 32 1E 27 TL 1000

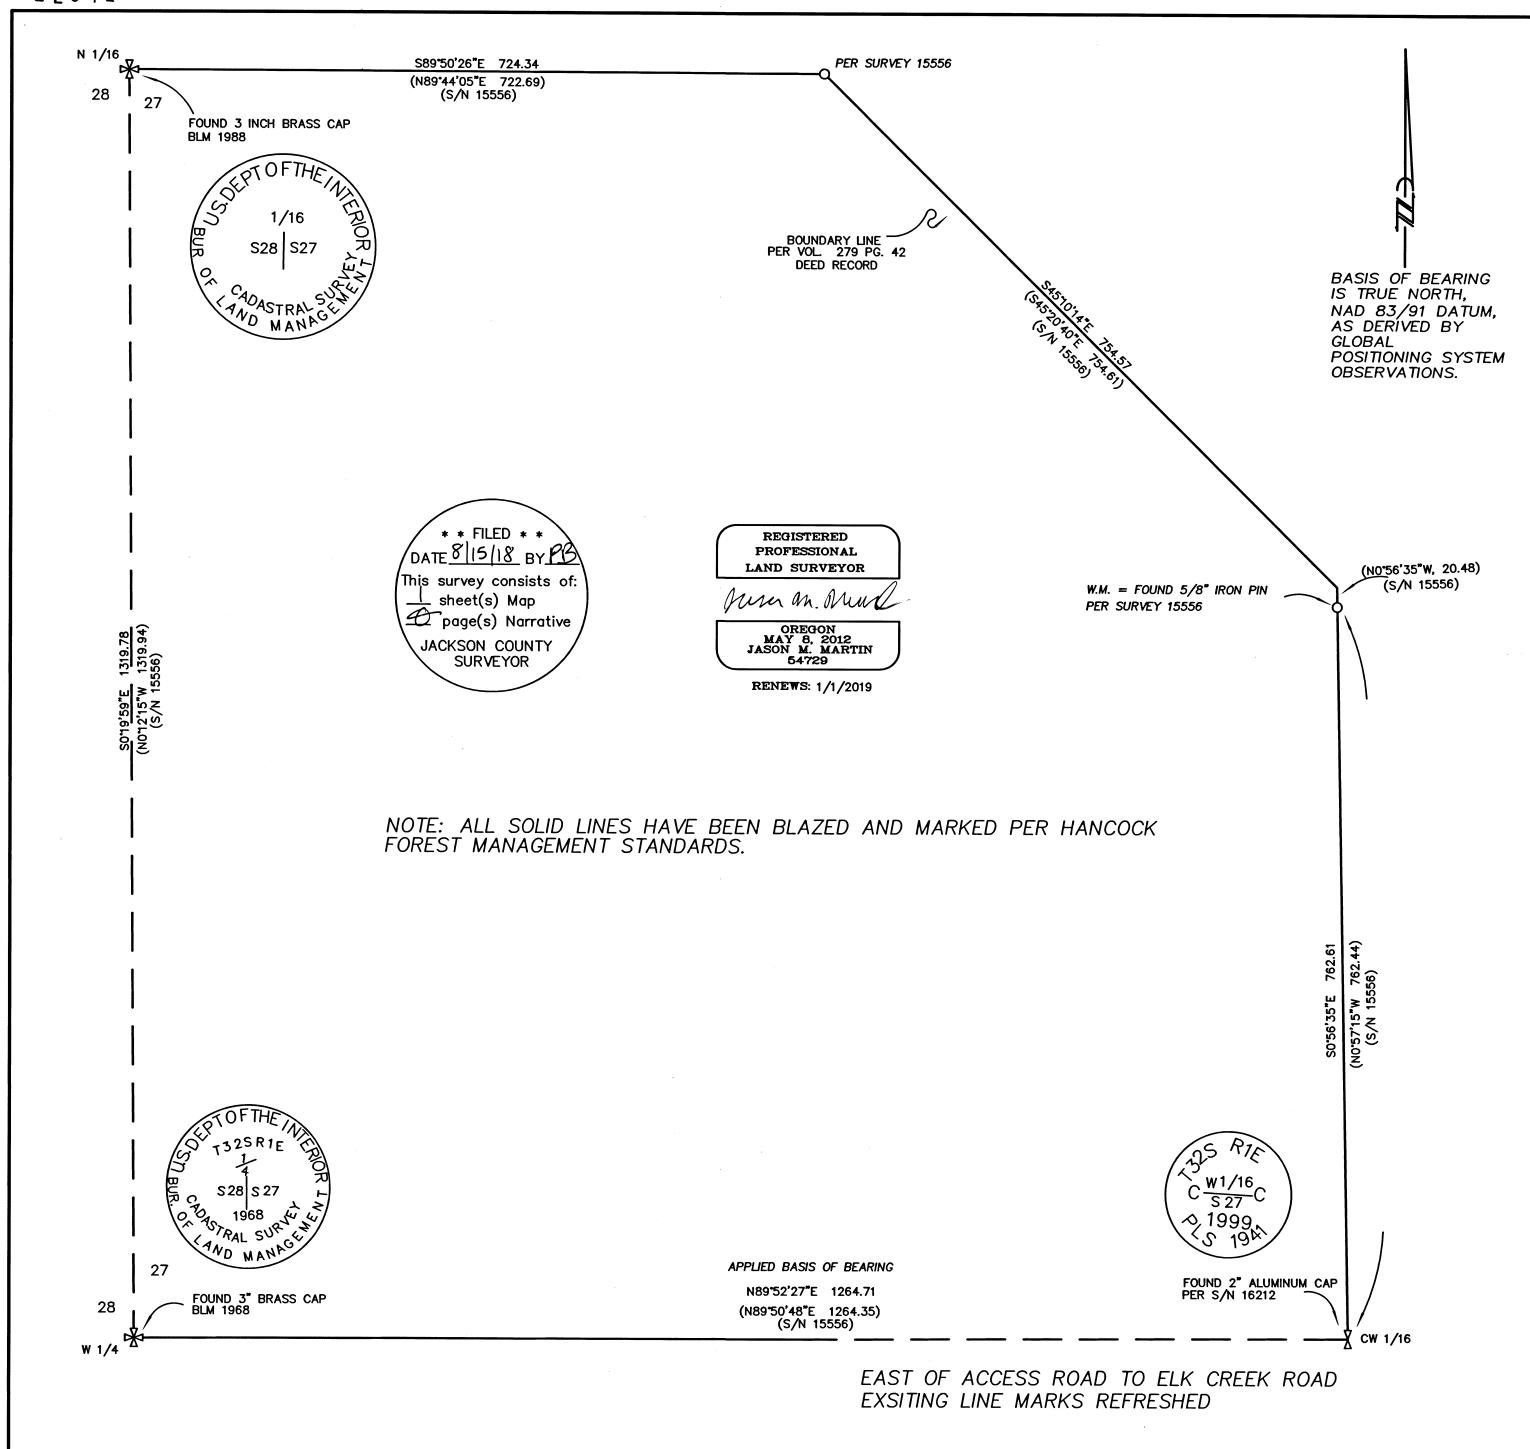

Sheet 1 of 1

SCALE: 1" = 100'
100' 50' 0' 100' 200'

## MAP OF SURVEY

located in the

NORTHWEST QUARTER OF SECTION 27, TOWNSHIP 32 SOUTH, RANGE 1 EAST, WILLAMETTE MERIDIAN, JACKSON COUNTY, OREGON

for

## HANCOCK FOREST MANAGEMENT

572 PARSONS DRIVE STE. 124 MEDFORD, OREGON 97501

## <u>LEGEND</u>

■ FOUND 3" BRASS CAP - AS DESCRIBED

X = FOUND 2" ALUMINUM CAP − AS DESCRIBED

O = FOUND 5/8" IRON PIN, PER S/N 15556

S/N = RECORD FILED SURVEY NUMBER

W.M. = WITNESS MONUMENT

- RECORD SURVEY DATA IS SHOWN IN PARENTHESIS ADJACENT TO MEASURED SURVEY DATA WHERE APPLICABLE.
- INST. NO. = INSTRUMENT NUMBER AS RECORDED IN THE OFFICIAL RECORDS OF JACKSON COUNTY, OREGON.

## SURVEY NARRATIVE TO COMPLY WITH O.R.S. 209.250

PURPOSE: TO RE—TRACE AND RE—MARK A PORTION OF THE BOUNDARY OF THAT TRACT OF LAND DESCRIBED AS PARCEL 3, OF INSTRUMENT NUMBER 2005—006324, RECORDE IN THE OFFICIAL RECORDS OF JACKSON COUNTY, OREGON, AND SURVEYED ON S/N 15556 FILED IN THE OFFICE OF JACKSON COUNTY SURVEYOR PER OUR CLIENT INSTRUCTIONS. THIS PROJECT NAME IS HAMMOND.

PROCEDURE: A FIELD SURVEY WAS CONDUCTED, AND MONUMENTS OF RECORD WERE RECOVERED AND TIED IN CLOSE SURVEY WITH TRIMBLE R-10 RECEIVERS AND TRIMBLE R-6 ROBOTIC TOTAL STATION. A CLOSED TRAVERSE WAS RUN BETWEEN MONMENTS AND THE BOUNDARY LINES WERE MARKED PER CLIENT INSTRUCTIONS AS SHOWN AND DESCRIBED. NO MONUMENTS WERE SET ON THIS SURVEY.

Surveyed by: FARBER & SONS, INC. dba



PO BOX 5286 431 OAK STREET CENTRAL POINT, OREGON 97502 (541) 664-5599

DATE: JUNE 12, 2018 JOB NO.: 2756–18

DRAWING FILE: JOBS\HANCOCKFOREST\Hammond\mircrosurvey\MOS.DWG

DRAWN BY: RGG ORIG. DATE: 06/12/2018 REVISED BY: HAF DATE: 06/27/2018