


BASIS OF BEARING IS TRUE NORTH, NAD 83/91 DATUM, AS DERIVED BY GLOBAL POSITIONING SYSTEM OBSERVATIONS.

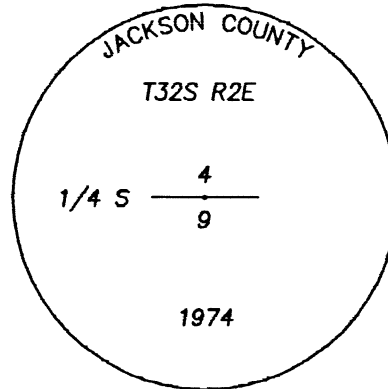



FOUND 2 1/2" BRASS CAP PER JACKSON COUNTY FIRST RE-ESTABLISHMENT NOTES DATED OCTOBER 2, 1974



FOUND 2 1/2" BRASS CAP PER JACKSON COUNTY RE-ESTABLISHMENT NOTES DATED DECEMBER 10, 1981

NOTES: SOLID LINES HAVE BEEN BLAZED AND MARKED PER HANCOCK FOREST MANAGEMENT STANDARDS.

FOUND 2 1/2" BRASS CAP PER S/N 5797

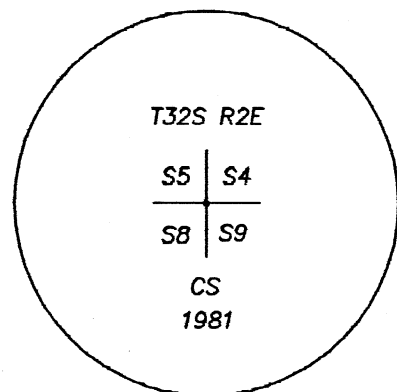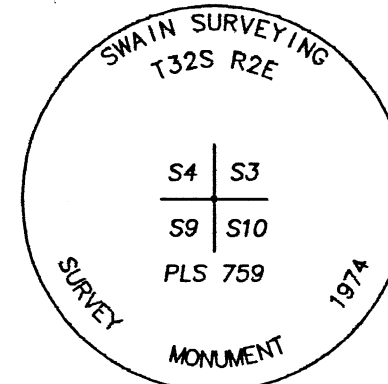


** RECEIVED **
DATE 9/9/19 BY PB
This survey consists of:
1 sheet(s) Map
0 page(s) Narrative
JACKSON COUNTY SURVEYOR

REGISTERED PROFESSIONAL LAND SURVEYOR

Fred A. Frantz
OREGON JULY 12, 2005
FRED A. FRANTZ No. 50077

Renewal 12-31-19

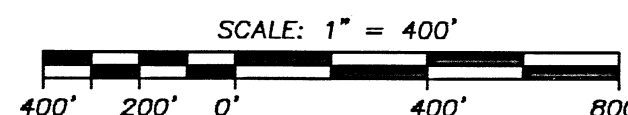

SCALE: 1" = 400'

MAP OF SURVEY

located in

SECTION 9, TOWNSHIP 32 SOUTH, RANGE 2 EAST, WILLAMETTE MERIDIAN, JACKSON COUNTY, OREGON

for

HANCOCK FOREST MANAGEMENT INC.

572 PARSONS DRIVE STE. 124
MEDFORD, OREGON 97501

LEGEND

- ✦ = FOUND 2 1/2" BRASS CAP - SECTION CORNER
- ⚡ = FOUND 2 1/2" BRASS CAP - 1/4 SECTION CORNER


S/N = RECORD FILED SURVEY NUMBER
- RECORD SURVEY DATA IS SHOWN IN PARENTHESIS ADJACENT TO MEASURED SURVEY DATA WHERE APPLICABLE.

SURVEY NARRATIVE TO COMPLY WITH O.R.S. 209.250

PURPOSE: THIS SURVEY WAS CONDUCTED TO MARK THE NORTH LINE OF TAX LOT 3101 AND NORTH LINE OF TAX LOT 3300 AS DESCRIBED AS A PORTION OF PARCEL 4, DOCUMENT 2013-24797 PAGE 2, RECORDED IN THE OFFICIAL RECORDS OF THE JACKSON COUNTY, PER HANCOCK FOREST MANAGEMENT INC. STANDARDS. THE NAME OF THIS PROJECT IS HIBBARD 9.

PROCEDURE: THIS SURVEY WAS CONDUCTED USING TRIMBLE R-10 GPS RECEIVERS, AND A TRIMBLE S6 ROBOTIC TOTAL STATION. THE LINES WERE RUN IN A CLOSED SURVEY BETWEEN THE FOUND MONUMENTS AS SHOWN HEREON. THE LINES WERE MARKED BETWEEN MONUMENTS. NO MONUMENTS WERE SET ON THIS SURVEY.

Surveyed by:
FARBER & SONS, INC. dba

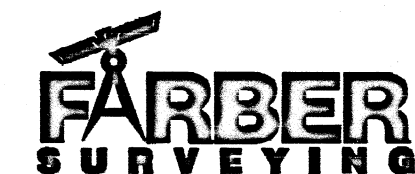

PO BOX 5286
431 OAK STREET
CENTRAL POINT, OREGON 97502
(541) 664-5599

DATE: JULY 10, 2019
JOB NO.: 2019-2836
DRAWING FILE: JOBS\HANCOCK FOREST\HIBBARD 9\MOS071019

DRAWN BY: AJP ORIG. DATE: 07/10/19 REVISED BY: DATE: