


# RECORD OF MONUMENT PRESERVATION

LOCATED IN THE NORTHEAST 1/4 OF SECTION 25, TOWNSHIP  
37 SOUTH, RANGE 2 WEST, WILLAMETTE MERIDIAN, IN THE  
CITY OF MEDFORD, JACKSON COUNTY, OREGON

**\*\* RECEIVED \*\***  
DATE 11/23/20 BY 10  
This survey consists of:  
1 sheet(s) Map  
0 page(s) Narrative  
JACKSON COUNTY  
SURVEYOR

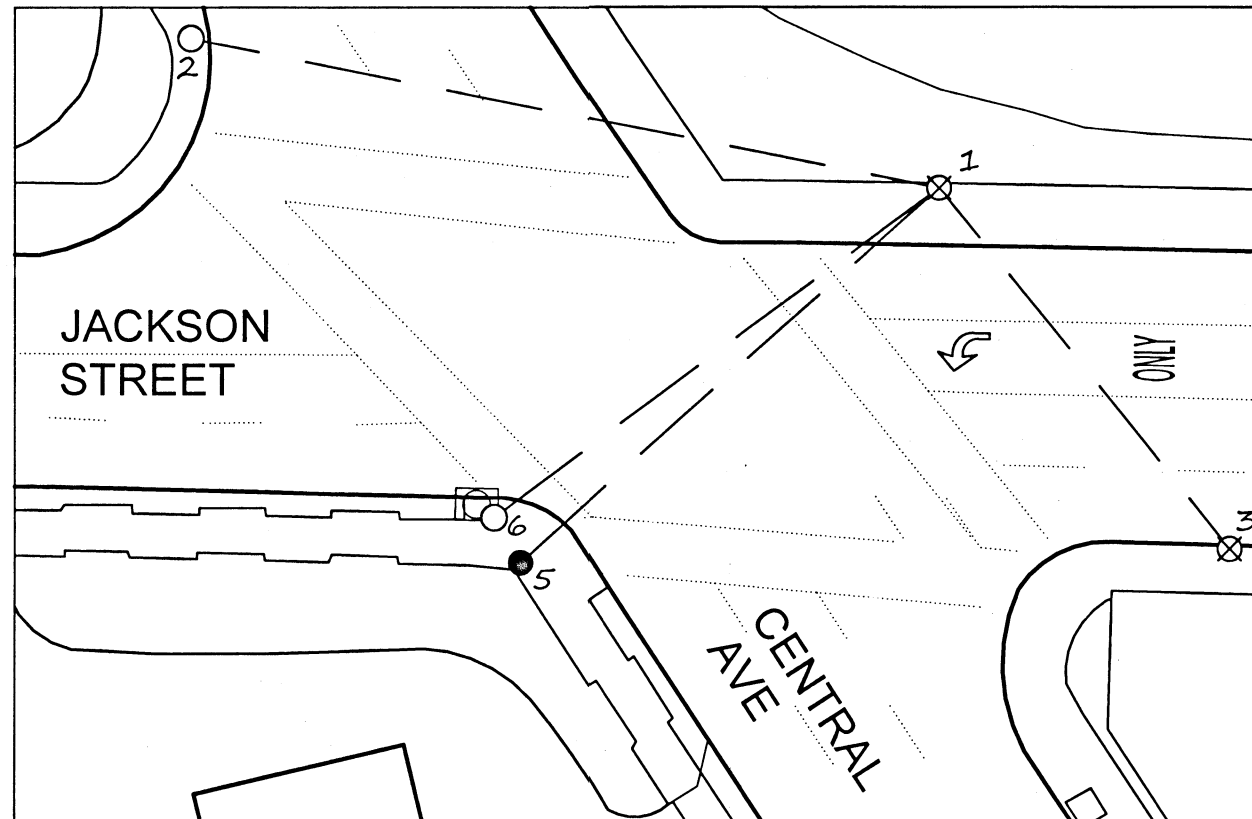

SET UP @ PNT 1  
BACK SIGHT AT PNT 2

PNT	ANGLE RIGHT	HORIZ DIST.	
2	00-00-00	119.04	
3	219-52-53	72.58	
4	<del>240-09-54</del>	<del>61.32</del>	DESTROYED
5	306-32-01	87.83	
6	311-47-32	86.57	
7	<del>338-50-01</del>	<del>39.72</del>	DESTROYED

- ⊗ FOUND CUT "X" IN CONCRETE PER RECORD OF MONUMENT PRESERVATION NUMBER 23024
- SET 1" COPPER PLUG FLUSH IN CONCRETE MARKED "CITY OF MEDFORD" TO REPLACE FOUND YELLOW PLASTIC CAP MARKED "MARQUESS & ASSOC" PER 15631
- FOUND .40 CALIBER SHELLS WITH CITY OF MEDFORD TAG & TACK PER CITY OF MEDFORD RP NOTES RP25



0 30 60  
SCALE 1"=30'

SURVEY NARRATIVE TO COMPLY WITH O.R.S. 209.250

SURVEY FOR/BY: CITY OF MEDFORD, 411 WEST 8TH STREET, MEDFORD, OREGON 97501

DATE OF SURVEY: DECEMBER 2019

PURPOSE: IN ACCORDANCE O.R.S. 209.150 THE PURPOSE OF THIS SURVEY IS TO RE-ESTABLISH THE LOCATION OF A FOUND MONUMENT (PER SN 15631) REPORTED IN RECORD OF MONUMENT PRESERVATION 23024 THAT WAS DESTROYED BY CONCRETE RAMP RECONSTRUCTION. POINT #5 WAS PREVIOUSLY TIED IN SAID SURVEY AND IS NOW REPLACED WITH A 1" COPPER PLUG MARKED "CITY OF MEDFORD"

EQUIPMENT USED TO PERFORM THIS SURVEY CONSISTED OF UTILIZING A TRIMBLE S6 ROBOTIC TOTAL STATION AND TSC3 DATA COLLECTOR. POINT NUMBERS 4 AND 7 FROM SURVEY 23024 WHERE FOUND TO BE DESTROYED DURING RAMP CONSTRUCTION AS WELL.

REGISTERED  
PROFESSIONAL  
LAND SURVEYOR  
*[Signature]*  
OREGON  
JANUARY 9, 2007  
JON M. PROUD  
77652  
EXPIRES DECEMBER 31, 2020

CITY OF MEDFORD - SURVEYING DEPARTMENT	
JACKSON STREET AND CENTRAL AVENUE	
DRAWN BY: ZPE	DATE 10/20/2020
CHECKED BY: JP	DATE 10/20/2020
DATE REFERENCED: 10/16/20	
CREW: Z. EARLE, S. METZGER	
PROJECT NO.	N/A
SHEET NO.	1 OF 1