


# RECORD OF MONUMENT PRESERVATION

LOCATED IN THE SOUTHEAST 1/4 OF SECTION 24, TOWNSHIP  
37 SOUTH, RANGE 2 WEST, WILLAMETTE MERIDIAN, IN THE  
CITY OF MEDFORD, JACKSON COUNTY, OREGON


**\*\* RECEIVED \*\***  
DATE 11/23/20 BY AB  
This survey consists of:  
1 sheet(s) Map  
0 page(s) Narrative  
JACKSON COUNTY  
SURVEYOR

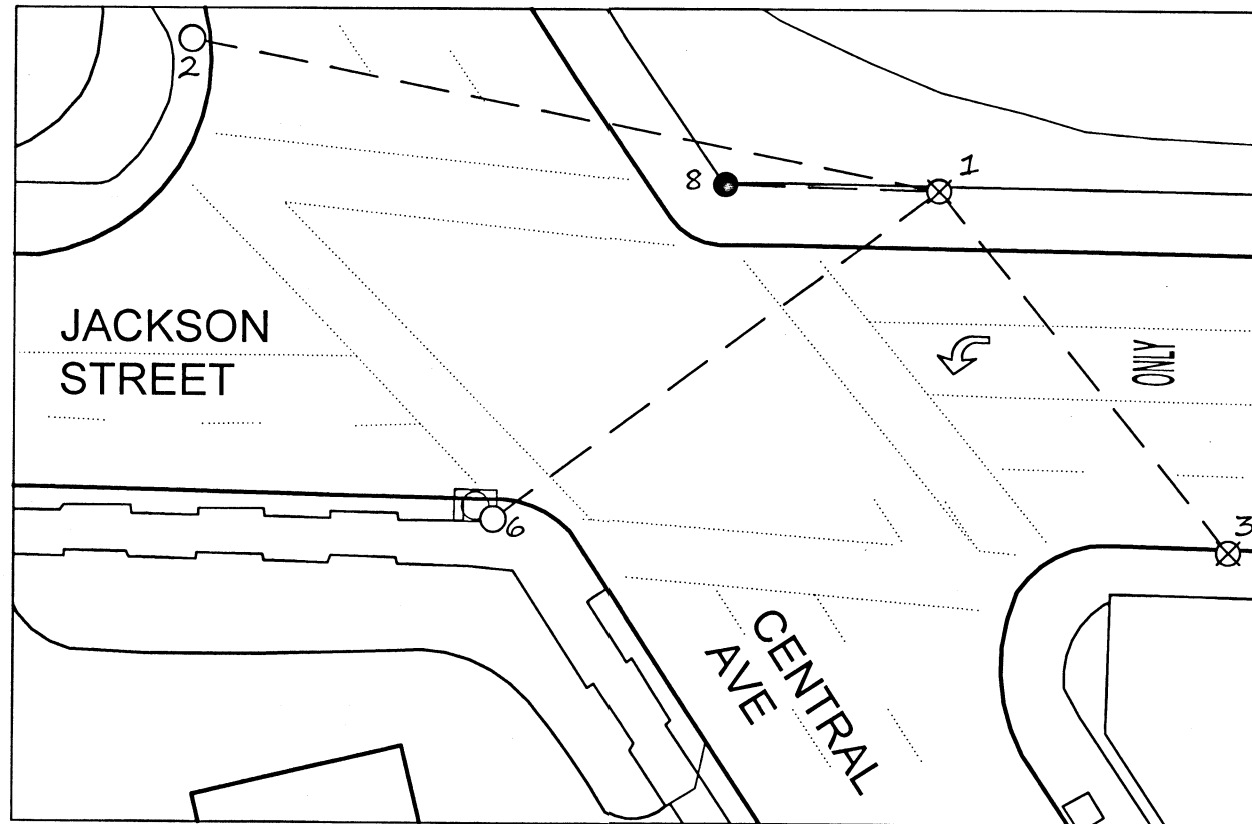

SET UP @ PNT 1  
BACKSIGHT AT PNT 2

PNT	ANGLE RIGHT	HORIZ DIST.	
2	00-00-00	119.04	
3	219-52-53	72.58	
4	<del>240-09-54</del>	<del>61.32</del>	DESTROYED
6	311-47-32	86.57	
7	<del>338-50-01</del>	<del>39.72</del>	DESTROYED
8	350-08-43	33.37	

- ⊗ FOUND CUT "X" IN CONCRETE PER RECORD OF MONUMENT PRESERVATION NUMBER 23023
- SET 1" COPPER PLUG FLUSH IN CONCRETE MARKED "CITY OF MEDFORD" TO REPLACE FOUND 5/8" REBAR WITH CAP PER SURVEY 16876
- FOUND .40 CALIBER SHELLS WITH CITY OF MEDFORD TAG & TACK PER CITY OF MEDFORD RP NOTES RP25

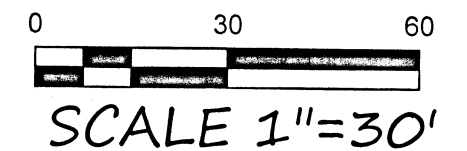

**SURVEY NARRATIVE TO COMPLY WITH O.R.S. 209.250**

SURVEY FOR/BY: CITY OF MEDFORD, 411 WEST 8TH STREET, MEDFORD, OREGON 97501

DATE OF SURVEY: OCTOBER, 2020

PURPOSE: IN ACCORDANCE O.R.S. 209.150 THE PURPOSE OF THIS SURVEY IS TO RE-ESTABLISH THE LOCATION OF A FOUND MONUMENT (PER SN 16876) REPORTED IN RECORD OF MONUMENT PRESERVATION 23023 THAT WAS DESTROYED BY CONCRETE RAMP RECONSTRUCTION. POINT #8 WAS PREVIOUSLY TIED IN SAID SURVEY AND IS NOW REPLACED WITH A 1" COPPER PLUG MARKED "CITY OF MEDFORD"

EQUIPMENT USED TO PERFORM THIS SURVEY CONSISTED OF UTILIZING A TRIMBLE S6 ROBOTIC TOTAL STATION AND TSC3 DATA COLLECTOR. POINT NUMBERS 4 AND 7 FROM SURVEY 23023 WHERE FOUND TO BE DESTROYED DURING RAMP CONSTRUCTION AS WELL.

372W24DD TL5200

REGISTERED  
PROFESSIONAL  
LAND SURVEYOR

*[Signature]* 11/20/20

OREGON  
JANUARY 9, 2007  
JON M. PROUD  
77652

EXPIRES DECEMBER 31, 2020

CITY OF MEDFORD - SURVEYING DEPARTMENT		
JACKSON STREET AND CENTRAL AVENUE		
DRAWN BY: ZPE	DATE 10/20/20	PROJECT NO.
CHECKED BY: JP	DATE 10/20/20	N/A
DATE REFERENCED: 10/16/2020	DATE	
CREW: Z. EARLE, S. METZGER		SHEET NO.
		1 OF 1