
## RECORD OF MONUMENT PRESERVATION


LOCATED IN THE NORTHEAST 1/4 OF SECTION 18, TOWNSHIP 37 SOUTH, RANGE 1 WEST, WILLAMETTE MERIDIAN, IN THE CITY OF MEDFORD, JACKSON COUNTY, OREGON

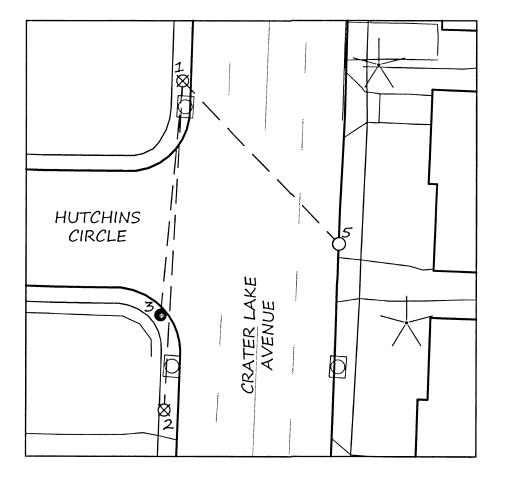

SET UP @ PNT 1 BACKSIGHT AT PNT 2

PNT	ANGLE RIGHT	HORIZ DIST.	
2	00-00-00	103.21	
3	02-09-52	73.76	
4	<del>343-14-41</del>	10.97	DESTROYED
5	313-14-37	70.71	
6	<del>357-58-11</del>	86.46	DESTROYED

- SET 1" COPPER PLUG FLUSH IN CONCRETE MARKED "CITY OF MEDFORD" TO REPLACE MAG NAIL WITH 2" WASHER MARKED "POLARIS LAND SURVEYING PLS 2883" PER SURVEY 16764
- O FOUND .38 CALIBER SHELLS IN TOP CURB PER CITY OF MEDFORD FIELD BOOK 1641 PG 13

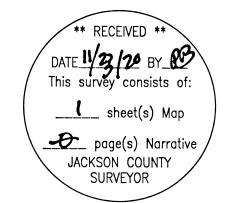





## VEY FOR/RY: CITY OF MEDEORD 411 WEST 9TH STREET MEDEORD OREGON

SURVEY FOR/BY: CITY OF MEDFORD, 411 WEST 8TH STREET, MEDFORD, OREGON 97501

SURVEY NARRATIVE TO COMPLY WITH O.R.S. 209.250

DATE OF SURVEY: DECEMBER 2019

PURPOSE: PURPOSE: IN ACCORDANCE O.R.S. 209.150 THE PURPOSE OF THIS SURVEY IS TO RE-ESTABLISH THE LOCATION OF A FOUND MONUMENT (PER SN 16764) REPORTED IN RECORD OF MONUMENT PRESERVATION NUMBER 23018 THAT WAS DESTROYED BY CONCRETE RAMP RECONSTRUCTION. POINT #3 WAS PREVIOUSLY TIED IN SAID SURVEY AND IS NOW REPLACED WITH A 1" COPPER PLUG MARKED "CITY OF MEDFORD"

EQUIPMENT USED TO PERFORM THIS SURVEY CONSISTED OF UTILIZING A TRIMBLE S6 ROBOTIC TOTAL STATION AND TSC3 DATA COLLECTOR. POINT NUMBERS 4 AND 6 FROM SURVEY NUMBER 23018 WERE FOUND TO BE DESTROYED DURING RAMP CONSTRUCTION AS WELL.

371W18AD TL4000



## CITY OF MEDFORD - SURVEYING DEPARTMENT

## CRATER LAKE AVENUE & HUTCHINS CIRCLE

DATE 10/20/2020	PROJECT NO.
	N/A
	1477
	SHEET NO.
	1 OF 1
_	DATE 10/20/2020  DATE 10/20/2020  DATE 10/16/2020