
(541) 774-2430

Assessor's Plat No. 381W04C, Tax Lot 800

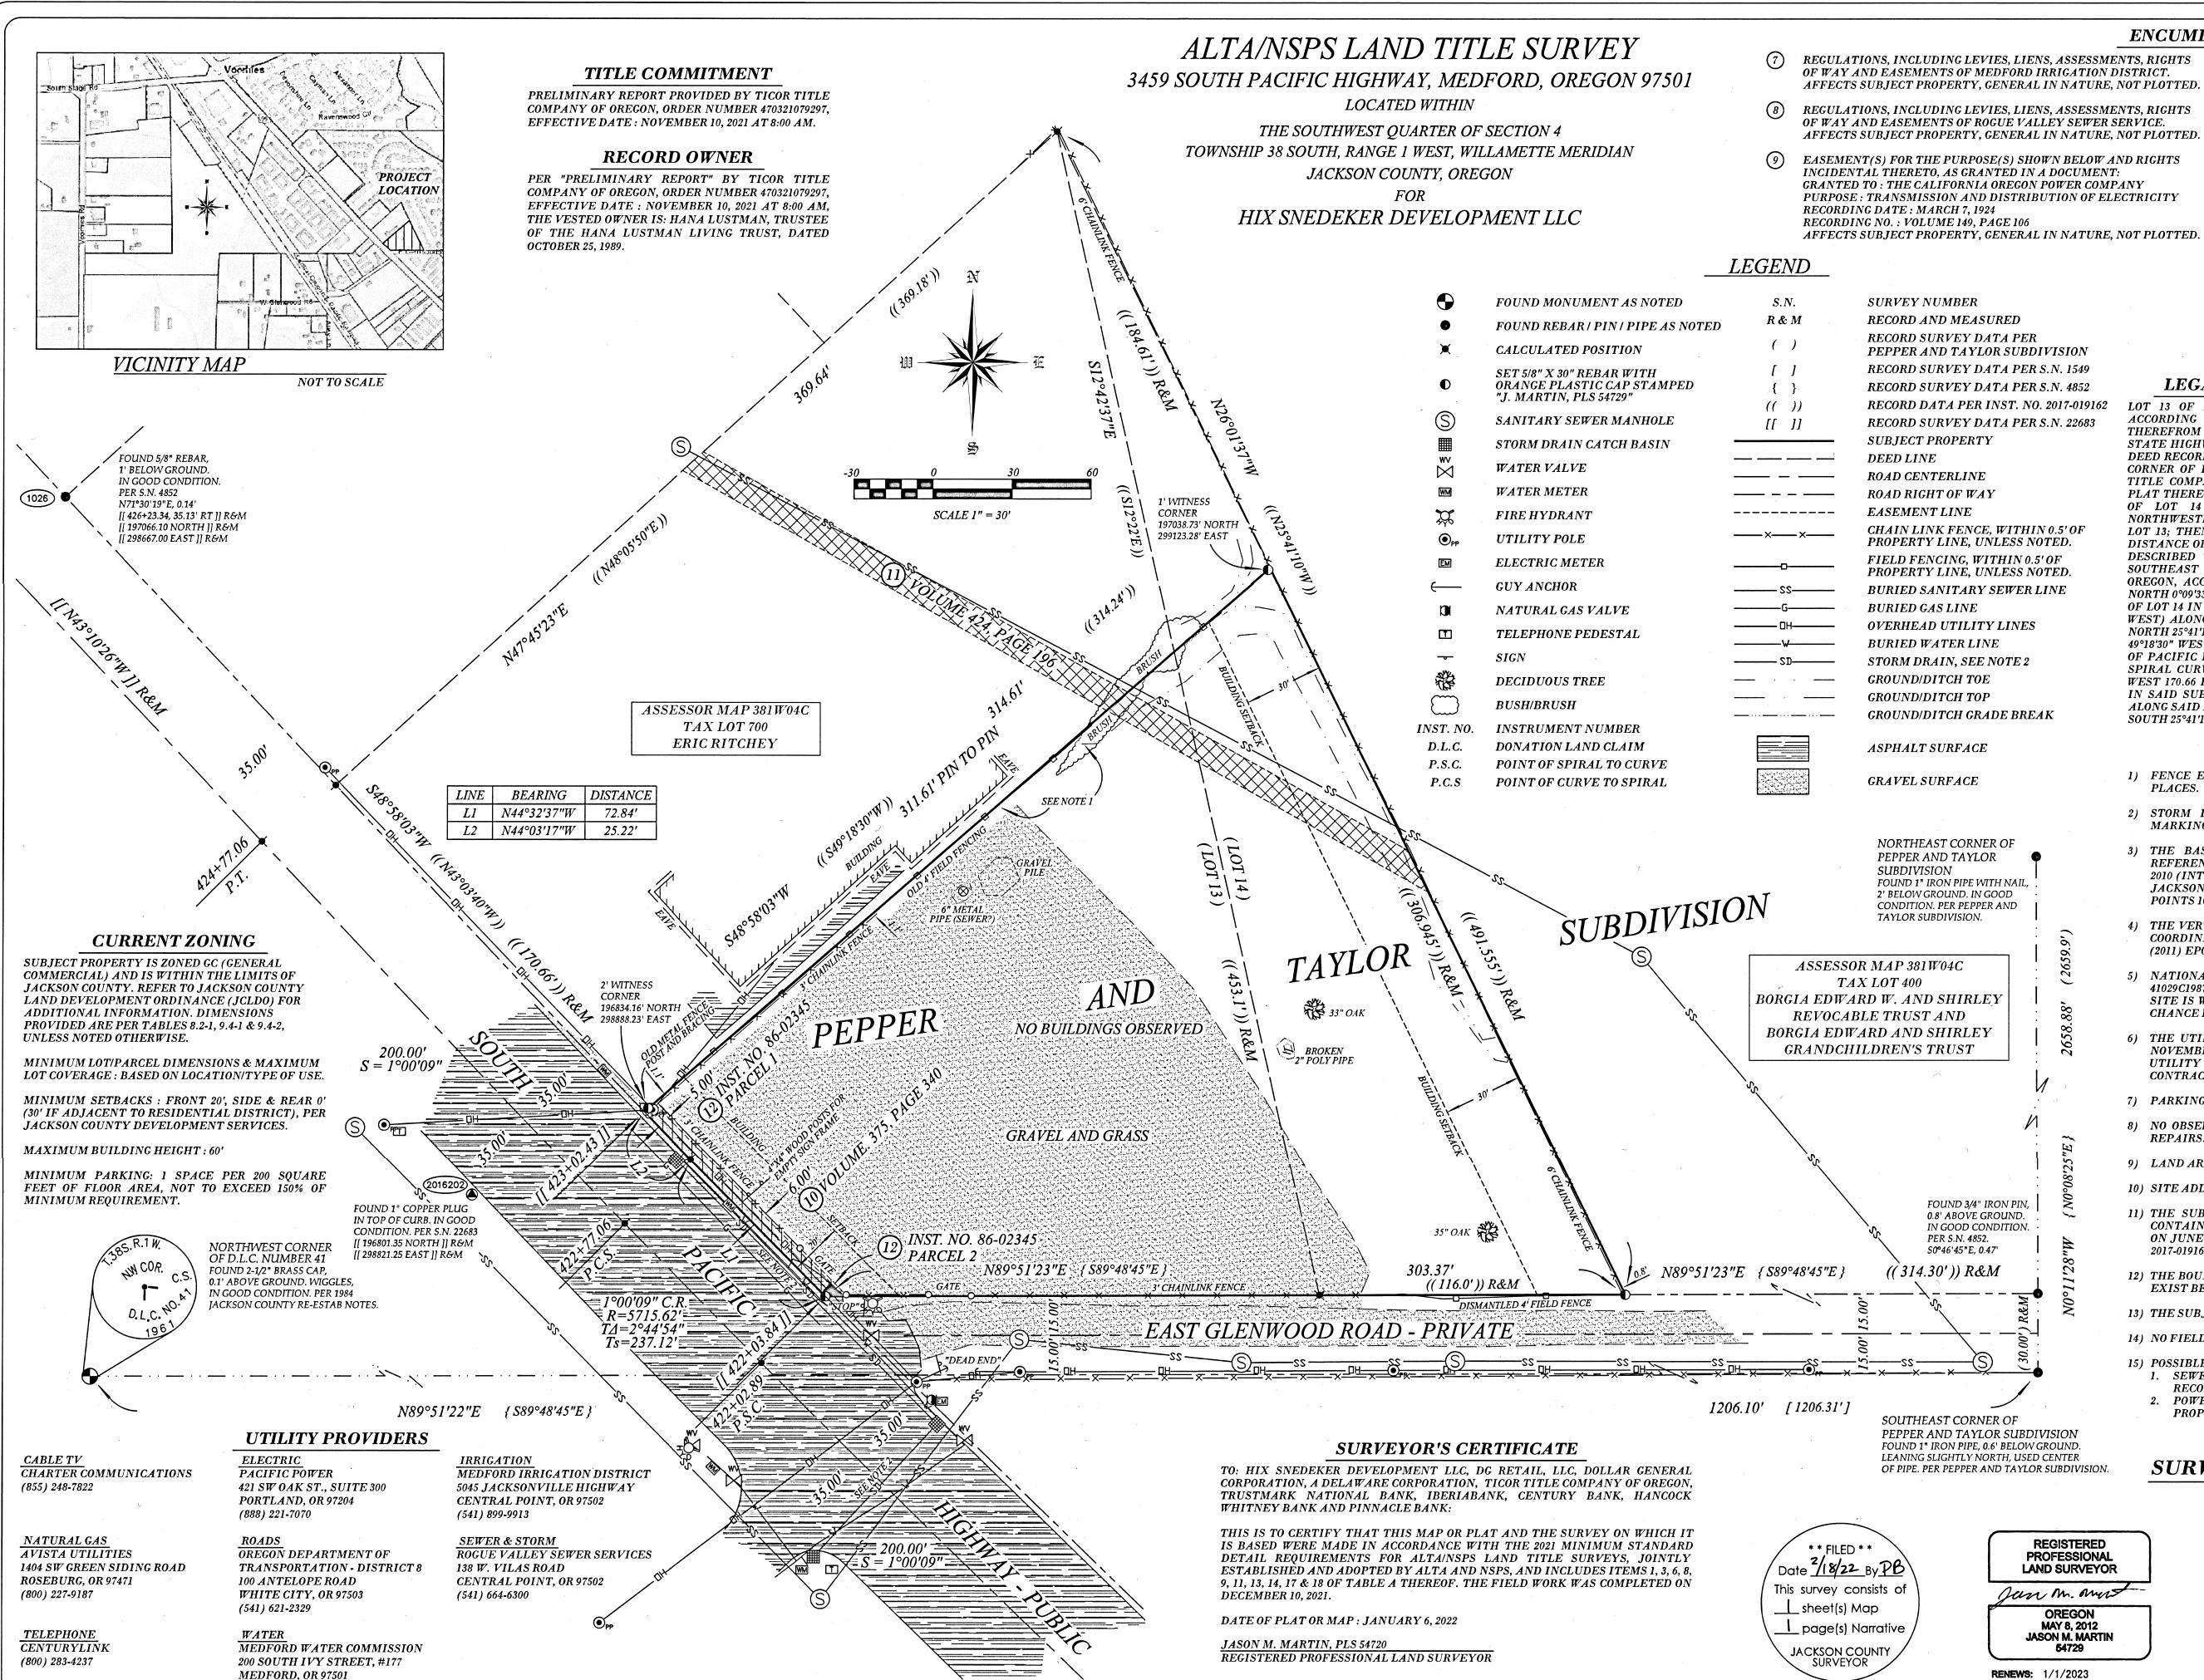

TO THE POINT LAND SURVEYING

## **ENCUMBRANCES**

- REGULATIONS, INCLUDING LEVIES, LIENS, ASSESSMENTS, RIGHTS OF WAY AND EASEMENTS OF MEDFORD IRRIGATION DISTRICT. AFFECTS SUBJECT PROPERTY, GENERAL IN NATURE, NOT PLOTTED.
- REGULATIONS, INCLUDING LEVIES, LIENS, ASSESSMENTS, RIGHTS OF WAY AND EASEMENTS OF ROGUE VALLEY SEWER SERVICE. AFFECTS SUBJECT PROPERTY, GENERAL IN NATURE, NOT PLOTTED.
- INCIDENTAL THERETO, AS GRANTED IN A DOCUMENT: GRANTED TO: THE CALIFORNIA OREGON POWER COMPANY PURPOSE: TRANSMISSION AND DISTRIBUTION OF ELECTRICITY
- (10) EASEMENT(S) FOR THE PURPOSE(S) SHOWN BELOW AND RIGHTS INCIDENTAL THERETO, AS GRANTED IN A DOCUMENT: GRANTED TO: THE CALIFORNIA OREGON POWER COMPANY PURPOSE: TRANSMISSION AND DISTRIBUTION OF ELECTRICITY RECORDING DATE: JANUARY 2, 1953 RECORDING NO.: VOLUME 375, PAGE 340 AFFECTS SUBJECT PROPERTY, PLOTTED.
- EASEMENT(S) FOR THE PURPOSE(S) SHOWN BELOW AND RIGHTS INCIDENTAL THERETO, AS GRANTED IN A DOCUMENT: GRANTED TO: SOUTH BEAR CREEK SANITARY DISTRICT PURPOSE: UNDERGROUND SANITARY SEWER LINES RECORDING DATE: APRIL 3, 1956 RECORDING NO.: VOLUME 424, PAGE 196 AFFECTS SUBJECT PROPERTY, PLOTTED.
- EASEMENT(S) FOR THE PURPOSE(S) SHOWN BELOW AND RIGHTS INCIDENTAL THERETO, AS GRANTED IN A DOCUMENT: GRANTED TO: STATE OF OREGON, BY AND THROUGH ITS DEPARTMENT OF TRANSPORTATION PURPOSE: HIGHWAY SLOPES, DRAINAGE AND UTILITIES RECORDING DATE: FEBRUARY 10, 1986 RECORDING NO.: 86-02345 AFFECTS SUBJECT PROPERTY, PLOTTED.

#### LEGAL DESCRIPTION (PER TITLE COMMITMENT)

LOT 13 OF PEPPER AND TAYLOR SUBDIVISION IN JACKSON COUNTY, OREGON ACCORDING TO THE OFFICIAL PLAT THEREOF, NOW OF RECORD. EXCEPTING THEREFROM LAND CONVEYED TO THE STATE OF OREGON (BY AND THROUGH ITS STATE HIGHWAY COMMISSION) BY DEED RECORDED IN VOLUME 372, PAGE 34 OF THE DEED RECORDS OF JACKSON COUNTY, OREGON. ALSO, BEGINNING AT THE SOUTHEAST CORNER OF LOT 13 OF PEPPER AND TAYLOR SUBDIVISION IN JOSEPHINE- CRATER TITLE COMPANIES, INC., AN OREGON CORPORATION, ACCORDING TO THE OFFICIAL PLAT THEREOF, NOW OF RECORD: THENCE SOUTH 89°48' EAST, ALONG THE SOUTH LINE OF LOT 14 OF SAID SUBDIVISION. A DISTANCE OF 116.0 FEET; THENCE NORTHWESTERLY IN A STRAIGHT LINE, TO THE MOST NORTHERLY CORNER OF SAID LOT 13: THENCE SOUTH 12°22' EAST, ALONG THE EASTERLY LINE OF SAID LOT 13, A DISTANCE OF 453.1 FEET TO THE POINT OF BEGINNING. EXCEPTING FROM THE ABOVE DESCRIBED TRACTS THE FOLLOWING: COMMENCING AT A 1" IRON PIPE AT THE SOUTHEAST CORNER OF PEPPER AND TAYLOR SUBDIVISION IN JACKSON COUNTY OREGON, ACCORDING TO THE OFFICIAL PLAT THEREOF, NOW OF RECORD; THENCE NORTH 0°09'33" EAST (RECORD NORTH 0°10' EAST) 30.0 FEET TO THE SOUTHEAST CORNER OF LOT 14 IN SAID SUBDIVISION: THENCE NORTH 89°48'10" WEST (RECORD NORTH 89°48' WEST) ALONG THE SOUTH LINE OF SAID LOT 14, A DISTANCE OF 314.30 FEET; THENCE NORTH 25°41'10" WEST 306.945 FEET TO THE TRUE POINT OF BEGINNING; THENCE SOUTH 49°18'30" WEST 314.24 FEET TO INTERSECT THE NORTHEASTERLY RIGHT OF WAY LINE OF PACIFIC HIGHWAY U.S. NO. 99; THENCE ALONG THE ARC OF A VARIABLE RADIUS SPIRAL CURVE TO THE RIGHT (THE LONG CHORD OF WHICH BEARS NORTH 43°03'40" WEST 170.66 FEET) 170.665 FEET TO INTERSECT THE SOUTHEASTERLY LINE OF LOT 12 IN SAID SUBDIVISION; THENCE NORTH 48°05'50" EAST (RECORD NORTH 48°06' EAST). ALONG SAID LINE, 369.18 FEET TO THE CORNER COMMON TO LOTS 12, 13 AND 14; THENCE SOUTH 25°41'10" EAST 184.61 FEET TO THE TRUE POINT OF BEGINNING.

#### GENERAL NOTES

- 1) FENCE EXTENDS INTO BRUSH AND IS LAYING ON THE GROUND IN MULTIPLE
- 2) STORM DRAIN LINES ARE SHOWN FOR PICTORIAL PURPOSES ONLY. FIELD MARKINGS WERE NOT COMPLETE AT THE TIME OF SURVEY.
- 3) THE BASIS OF BEARING FOR THIS SURVEY IS THE OREGON COORDINATE REFERENCE SYSTEM (OCRS): GRANTS PASS-ASHLAND ZONE, NAD83 (2011) EPOCH 2010 (INTERNATIONAL FEET). AS SHOWN ON SURVEY NUMBER 22683, FILED IN THE JACKSON COUNTY, OREGON SURVEYORS OFFICE AND FIELD VERIFIED BY TIES TO POINTS 1026 AND 2016202 OF SAID SURVEY.
- 4) THE VERTICAL DATUM FOR THIS PROJECT IS NAVD 88, BASED UPON THE OREGON COORDINATE REFERENCE SYSTEM (OCRS): GRANTS PASS-ASHLAND ZONE, NAD83 (2011) EPOCH 2010 (INTERNATIONAL FEET)
- 5) NATIONAL FLOOD INSURANCE PROGRAM FLOOD INSURANCE RATE MAP NUMBER 41029C1987F, WITH AN EFFECTIVE DATE OF MAY 3, 2011, INDICATES THAT THIS SITE IS WITHIN ZONE X (AREAS DETERMINED TO BE OUTSIDE THE 0.2% ANNUAL CHANCE FLOODPLAIN) AND IS NOT IN A SPECIAL FLOOD HAZARD AREA.
- 6) THE UTILITY INFORMATION DEPICTED ON THIS MAP WAS LOCATED BETWEEN NOVEMBER 30 AND DECEMBER 10, 2021 FROM SURFACE FEATURES AND FIELD UTILITY LOCATES. ALL INFORMATION SHOULD BE FIELD VERIFIED BY THE CONTRACTOR PRIOR TO COMMENCING CONSTRUCTION.
- 7) PARKING SPACES: THERE ARE NO MARKED PARKING SPACES AT THIS TIME.
- 8) NO OBSERVED EVIDENCE OF RECENT STREET OR SIDEWALK CONSTRUCTION OR
- 9) LAND AREA: 57,302 SQUARE FEET (1.315 ACRES) MORE OR LESS.
- 10) SITE ADDRESS: 3459 S. PACIFIC HIGHWAY, MEDFORD, OREGON 97501
- 11) THE SUBJECT PROPERTY IS ONE AND THE SAME AS THAT CERTAIN PARCEL CONTAINED IN THE STATUTORY WARRANTY DEED DATED JUNE 6, 2017, RECORDED ON JUNE 9, 2017 IN THE JACKSON COUNTY OFFICIAL RECORDS AS INSTRUMENT NO.
- 12) THE BOUNDARY LINES OF THE PARCELS ARE CONTIGUOUS AND NO GAPS OR GORES EXIST BETWEEN THE BOUNDARY LINES.
- 13) THE SUBJECT PROPERTY HAS DIRECT ACCESS TO SOUTH PACIFIC HIGHWAY.
- 14) NO FIELD DELINEATIONS OF WETLANDS WERE OBSERVED.
- SEWER LINE CROSSING PROPERTY APPEARS TO LIE OUTSIDE OF THE RECORDED EASEMENT.
- 2. POWER POLE NEAR MOST WESTERLY PROPERTY CORNER FALLS INSIDE PROPERTY AND HAS NO APPARENT EASEMENT.

# SURVEY NARRATIVE ON SEPARATE SHEET

TO COMPLY WITH O.R.S. 209.250

SURVEYED BY:

TO THE POINT LAND SURVEYING, LLC 230 EAST MAIN STREET ROGUE RIVER, OR 97537 (541) 855-4280

> Date: January 14, 2022 Project No. 0113-21

### SURVEY NARRATIVE

TO COMPLY WITH O.R.S. 209,250

DATE: JANUARY 14, 2022

SURVEY FOR: HIX SNEDEKER DEVELOPMENT LLC

P.O. BOX 130 DAPHNE, AL 36526

SURVEY BY: TO THE POINT LAND SURVEYING, LLC

230 EAST MAIN STREET ROGUE RIVER, OREGON 97537

LOCATION: LOCATED WITHIN LOTS 13 AND 14 OF PEPPER AND TAYLOR SUBDIVISION IN

THE SOUTHWEST QUARTER OF SECTION 4, TOWNSHIP 38 SOUTH, RANGE 1 WEST,

WILLAMETTE MERIDIAN, JACKSON COUNTY, OREGON.

PURPOSE: TO SURVEY AND MONUMENT A PARCEL OF LAND RECORDED IN INSTRUMENT

NUMBER 2017-019162 OF THE OFFICIAL RECORDS OF JACKSON COUNTY, OREGON,

PER THE REQUEST OF THE CLIENT.

PROCEDURE: THIS SURVEY WAS CONDUCTED USING A LEICA TCRP 1203+ ROBOTIC TOTAL

STATION, DISTANCE PRISMS, A LEICA CS15 DATA COLLECTOR AND JAVAD TRIUMPH-2 SURVEY GRADE GPS RECEIVERS. THE BASIS OF BEARING FOR THIS SURVEY IS THE OREGON COORDINATE REFERENCE SYSTEM (OCRS): GRANTS PASS-ASHLAND ZONE, NAD83 (2011) EPOCH 2010 (INTERNATIONAL FEET), AS SHOWN ON SURVEY NUMBER 22683, FILED IN THE JACKSON COUNTY, OREGON SURVEYORS OFFICE AND FIELD VERIFIED BY TIES TO POINTS 1026 AND 2016202

OF SAID SURVEY.

THE NORTHWEST CORNER OF DONATION LAND CLAIM (D.L.C.) NUMBER 41, TOGETHER WITH THE SOUTHEAST AND NORTHEAST CORNERS OF PEPPER AND TAYLOR SUBDIVISION WERE FOUND TO FIT VERY WELL WITH RECORD DIMENSIONS AND USED TO CALCULATE LOTS 13 AND 14 OF SAID SUBDIVISION.

POINTS 1026 AND 2016202 FROM FILED SURVEY NUMBER 22683 WERE TIED AND FOUND TO FIT VERY WELL, THEREFORE THE RIGHT OF WAY OF SOUTH PACIFIC HIGHWAY WAS CALCULATED AND HELD AS SHOWN ON SAID SURVEY.

ALL OTHER BOUNDARIES WERE CALCULATED AND HELD AT RECORD DIMENSIONS PER INSTRUMENT NUMBER 2017-019162.

\*\* FILED \*\*

Date 2/18/22 By PB

This survey consists of

\_\_\_\_\_ sheet(s) Map

\_\_\_\_\_ page(s) Narrative

JACKSON COUNTY
SURVEYOR

REGISTERED PROFESSIONAL LAND SURVEYOR

OREGON
MAY 8, 2012
JASON M. MARTIN
54729

**RENEWS:** 1/1/2023