

SURVEY IN SE. 1/4 SEC. 17 T 38 S, R 1 W, WM.
 FOR
 WALTER WHITMORE
 67 - 23

BY EDWARD MC GINTY
 PROF. LAND SURVEYOR
 MED FORD, OREGON
 AUGUST 1967

SCALE 1" = 50'
 ⊙ = 3/4" I PIPE FD.
 ○ = 5/8" I. PIN

REGISTERED
 OREGON
 LAND SURVEYOR

Edward A. McGinty

JULY 10, 1953
 EDWARD A. MCGINTY
 301

JACKSON COUNTY
 RECEIVED
 NOV - 8 1967
 SURVEYOR


Survey No. 3581

Survey Narrative to comply with Chap. 555 - O. L. 1963.

Survey for: Mr. Walt Whitmore
Rt. 4, Box 429-B1
Medford, Oregon 97501



Survey by: Edward A. McGinty, L.S.
Medford, Oregon
August 1967

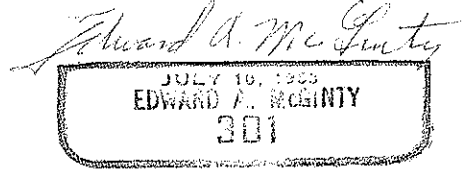

Basis of Bearing: Survey No. 764, shown as North 18°01' East.

Precedence of Survey:

Found a 5/8 in. iron pin being record Survey No. 764 and a 3/4 in. iron pipe being record Survey No. 1573 a monument approx. flush with the surface.

Set 5/8 in. and 20 in. iron pins approx. flush with the surface.

This survey is a partial retracement of previous Surveys No. 764 and 1573, Found distance on remeasurements:

174.03	instead of	174.05	Rec.
151.27	"	"	151.31 Rec.
64.90	"	"	65.00 Rec.

No attempt was made to determine the Northerly line of Pioneer Road and the line shown may be approx. only.

