


PROPERTY SURVEY


SITUATE IN

NW 1/4 SEC 4 T 35 S R 4 W WM
JACKSON COUNTY OREGON

G W PLUMB LAND SURVEYOR MEDFORD OREGON
SCALE 1" = 100' 22 JUNE 1972

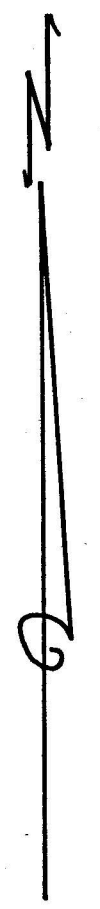

- Bearings based on Record Survey No 3766
- Set 5/8" x 30" iron rod
 - Set 5/8" x 24" iron rod

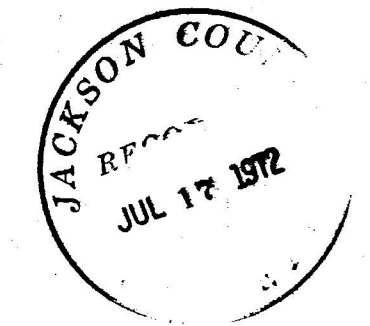

Survey for Ronald P. Haberman and Clyde E. Thompson
c/o Valley of the Rogue Bank
P. O. Box B
Rogue River, Oregon 97537

Survey By G. W. Plumb
Land Surveyor
P. O. Box 904
Medford, Oregon 97501

Location NW $\frac{1}{4}$ Section 4, Township 35 South, Range 4 West, Willamette
Meridian

Found 4 original bearing trees for the corner of Secs. 32 and 33, T. 34 S. and 4 and 5, T. 35 S. Set $\frac{5}{8}$ " x 30" iron rod for the corner from the bearing trees. A 2" iron pipe bears N. 22° 06' W., 4.65'. Found 1 1/2" iron pipe with 2 B.T.'s, set by County Surveyor for quarter corner of Secs. 33, T. 34 S., and 4, T. 35 S. Found $\frac{3}{4}$ " iron pipe, with 2 B.T.'s for quarter corner of Secs. 4 and 5. Found 1" iron pipe with 2 B.T.'s for west center sixteenth corner of Sec 4, per Registered Survey No. 121.

Set $\frac{5}{8}$ " x 30" iron rod for north sixteenth corner of Secs. 4 and 5, proportioned from original survey record. Set $\frac{5}{8}$ " x 30" iron bar for NE corner at proportional distance according to original survey record for NW sixteenth corner of Sec. 4, per agreement between owners of this property and owner of property to north, and prepared description for quit claim deeds to be exchanged between owners, to clear ownership records. Set other $\frac{5}{8}$ " iron rods as shown on accompanying map.

The center line of West Evans Creek Road was established from reference points set by the County Engineer's Office.

G. W. Plumb
Land Surveyor
10 July 1972

