


JACKSON COUNTY  
 RECEIVED  
 FEB 27 1973  
 SURVEYOR

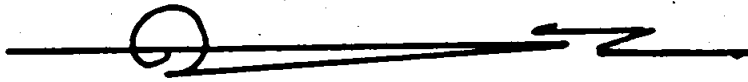

O SET 5/8" X 24" IRON ROD  
 BEARINGS FROM RS 121  
 SCALE 1" = 200'

PROPERTY SURVEY  
 SITUATE IN

SE 1/4 SEC 8 T 35 S R 4 W WM  
 JACKSON COUNTY OREGON  
 G W PLUMB LAND SURVEYOR  
 MEDFORD OREGON 23 FEB 1973

REGISTERED  
 PROFESSIONAL  
 LAND SURVEYOR

*G. W. Plumb*

OREGON  
 JULY 12, 1968  
 G. W. PLUMB  
 #62

5108

Survey for Woodrow Owings  
8105 West Evans Creek Road  
Rogue River, Oregon 97537

Survey by G. W. Plumb Land Surveyor  
P. O. Box 904  
Medford, Oregon 97501

Location SE  $\frac{1}{4}$  Section 8, T. 35 S., R. 4 W., W.M.

Found brass capped monument for the corner of Sections 8,9,16 and 17;  
 $1\frac{1}{2}$  inch iron pipe for the quarter corner of sections 8 and 17;  $\frac{3}{4}$  inch  
iron pipe with two bearing trees for the SE  $\frac{1}{16}$  corner of section 8;  
and the two bearing trees for the south  $\frac{1}{16}$  corner of sections 8 and 9.

Established the position of the south  $\frac{1}{16}$ th corner of 8 and 9 from the  
bearing trees, per Record Survey No. 121. Traversed between found  
corners and calculated the position of the east  $\frac{1}{16}$ th corner of sections  
8 and 17.

Set  $\frac{5}{8}$  inch by 24 inch iron rods to divide property described in Jackson  
County Record No. 71-09057 as requested by the owner, and also at the  
intersection of the East - West center line of the SE  $\frac{1}{4}$  of the SE  $\frac{1}{4}$  of  
Section 8 with the West Right of Way line of West Evans Creek Road.

23 February 1973

REGISTERED  
PROFESSIONAL  
LAND SURVEYOR  
*G. W. Plumb*  
OREGON  
JULY 12, 1968  
G. W. PLUMB  
862

JACKSON COUNTY  
RECEIVED  
FEB 27 1973  
SURVEYOR

T35 58 04.0