
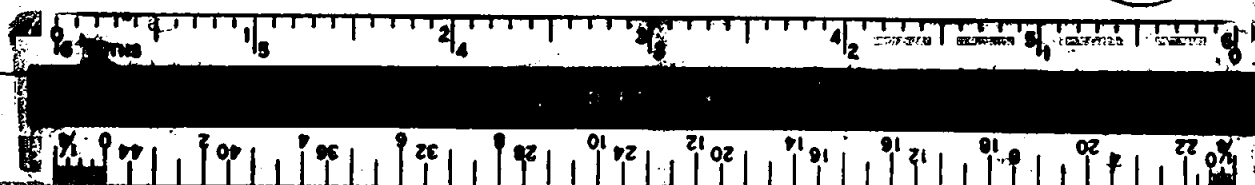


BY MARQUESS & MARQUESS,
CONSULTING ENGINEERS
MEDFORD, OREGON
FEBRUARY 21, 1974

PROPERTY SURVEY
FOR
BRUCE W. & ANN G. BUTTE
465 EAST CALIFORNIA STREET
JACKSONVILLE, OREGON

SCALE 1" = 100'
● = 5/8" I. PIN FND.
○ = 5/8" I. PIN SET
BEARINGS BY RS. 2389

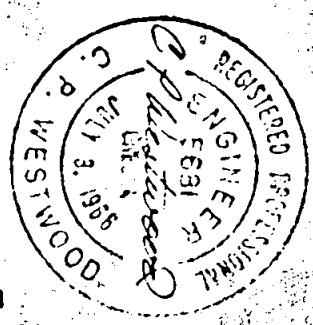

Survey Narrative to accompany
survey prepared for:

Bruce W. & Ann G. Butte
465 East California Street
Jacksonville, Oregon - 97530

By:

Marquess & Marquess
Consulting Engineers
#12 Goldy Building
Medford, Oregon - 97501

Basis of Bearing:

Recorded Survey No.2389

Location of Survey:

North half of Section 32, T 37 S,
R 2 W, W.M. midway between 6th
Street and 8th Street fronting on
California Street in Jacksonville,
Oregon.

Procedure:

Existing monuments recorded on
record surveys No.2389 and 1870
were recovered and accuracy
verified with the record distances
along California Street from 6th
to 8th Street. From the recovered
monuments the required monuments
were set as per the record dis-
tances. Record bearings of Sixth
Street, California Street and
Eighth Street were used as the
basis of bearing for the survey.

