

63.25

OREGON STATE HIGHWAY DEPARTMENT

Locoted Line

# RUCH SECTION

~~MEDFORD-FRODOLE~~ HIGHWAY  
JACKSONVILLE  
JACKSON COUNTY

Scale: 1 inch = 50 feet

Traced by M.L.J.


June, 1968

TRUE BEARINGS

DRG. NO. 9B-4-25

ACCESS CONTROL LINE \_\_\_\_\_

*'Set Pin' Indicates Set 3/8" x 30" Capped Iron Pin & Guard Post*

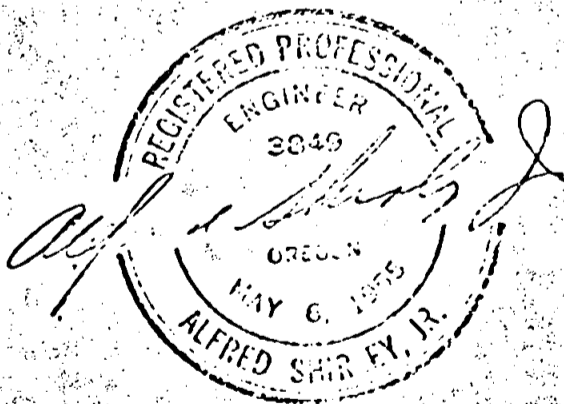

27(A) 38 3W

63.25

OREGON STATE HIGHWAY DEPARTMENT

Located Line

# RUCH SECTION

~~MEDFORD ROAD~~ HIGHWAY

JACKSONVILLE  
JACKSON COUNTY

Scale: 1 inch = 50 feet

Traced by M.L.J.

June, 1968

TRUE BEARINGS

DRG. NO. 9B-4-25

ACCESS CONTROL LINE \_\_\_\_\_

*'Set Pin' Indicates Set 5/8" x 30" Capped Iron Pin & Guard Post*

