


8868

Survey for JACK DEAL


Located in the NW 1/4, NE 1/4 Sec. 21, T.36S., R.3W., W.M., Jackson County, Oregon

August 25, 1981

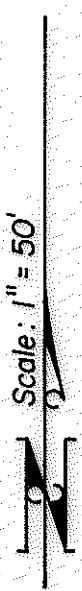

LEGEND
 ○ Set 5/8" x 24" iron pin
 ● Fd. mon. of record

BASIS OF BEARINGS
 Record Survey No. 900

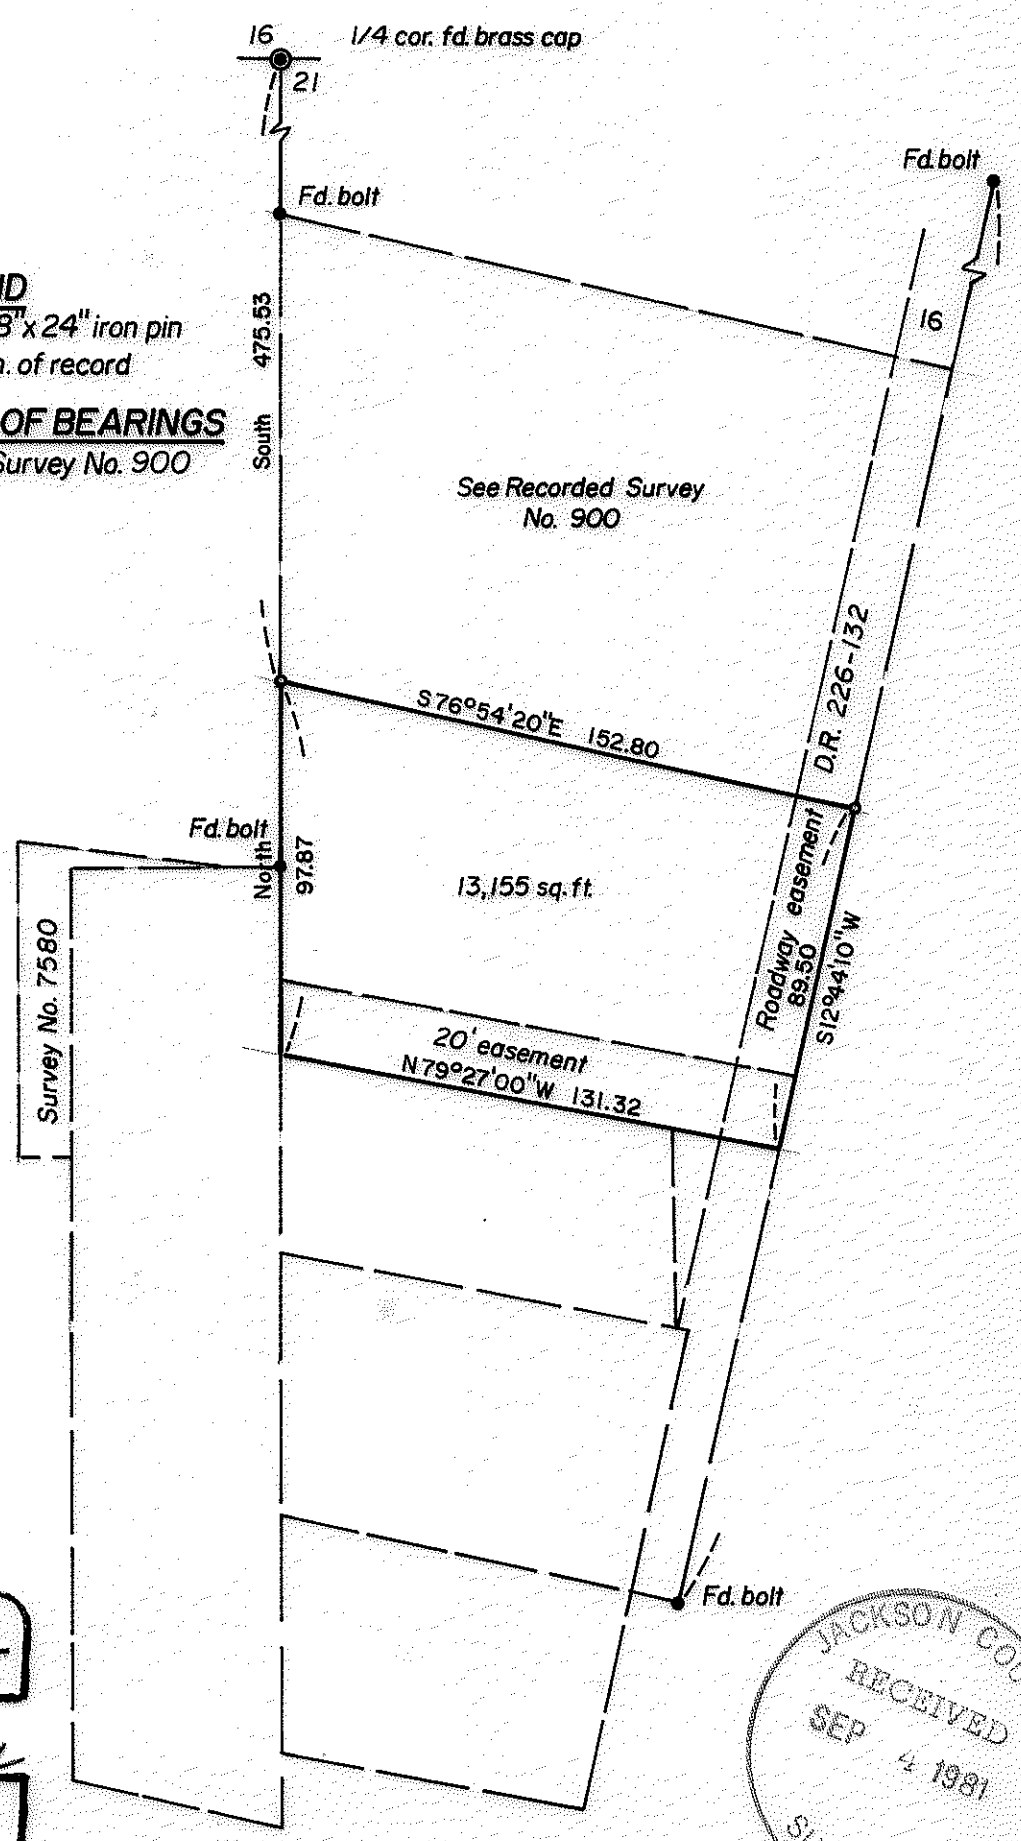

REGISTERED
PROFESSIONAL
 LAND SURVEYOR

Verlyn Thomas
 OREGON
 MAY 13, 1960
 VERLYN B. THOMAS
 503

JACKSON COUNTY
 RECEIVED
 SEP 4 1981
 SURVEYOR

Survey by Verlyn Thomas, Professional Land Surveyor, Medford, Oregon.

8868

36 3X 21 AB

SURVEY NO. 8988

SURVEY NARRATIVE TO COMPLY WITH O.R.S. 209.250

SURVEY FOR: Jack Deal
P.O. Box 33
Gold Hill, Oregon

PURPOSE: To establish a line for tax lot line adjustment purpose.

PROCEDURE: Recovered monuments established by Recorded Survey No. 900,
and monumented division line as shown on the accompanying plat.

REGISTERED
PROFESSIONAL
LAND SURVEYOR
Verlyn D. Thomas
OREGON
MAY 13, 1960
VERLYN D. THOMAS
905

JACKSON COUNTY
RECEIVED
SEP 4 1981
SURVEYOR