

E 784
NW Cor.
Lot 3.

SE Cor. Lot 4

3
21.2 Ac
N Line Lot 4

4
21.2 Ac

N 10° W
Rock

Lower Ditch
N 6° W 1574'

Upper Ditch

S. 8° W. 2197'
COUNTY

36" W Oak
600'S N 47° E 20.7 H.
FROM I.P.

1267'
LANE

1110' to Ditch
N 16° 36'

NE Cor. D.L.C. #1

I.P.

N 225'

North 1790'

33

34

4

3

3 links

22'


40'

40'

60'

FIELD NOTES of a division line of the Cantrall Lands.
In Section 33, T 38 S., R 3 W., W. M.

Beginning at the Southeast corner of said Section 33

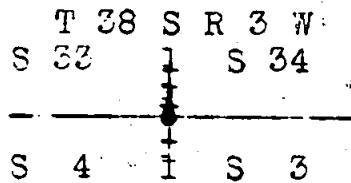

Run North between Sections 33 and 34
Feet

1790.0 to the North line of an existing lane
Run West

225.0 Set an iron pipe 3 feet long 2" diam., 3 feet in the ground
for an established corner.

A White Oak, 36 inches in diam. bears N 47° E 20.7 feet/
A rock, marked x, is 1267 feet West and 30 feet South,
said rock is known as being the NE corner of DLO No. 41.

Run North 6° West
1574.0 to the North line of lot 4. Corner not set.

Surveyed October 4th, 1947 by

