

WILLIS M. AUSLAND

REGISTERED CIVIL ENGINEER

446 ALLISON STREET
ASHLAND, OREGON

April 30, 1947

Re-established corner on Section Line Between Sections 31 and 32, Town ship 35 South, Range 2 West of Willamete Meridian.

Found original black oak, now 36 inches in diameter, scribed 1/4 S; Set 3/4 galv. iron pipe, 24 inches long at one quarter section corner from original bearing tree


93. An Original Black Oak 36" dia. , Bears S 13° W
1 feet

62° A Laurel, 12" dia., previously blazed, Bears South West 30.5 feet

A 15" Black Oak, Bears S 41 1/2° E, 140.1 feet.

Please have this recorded

Bob Jones

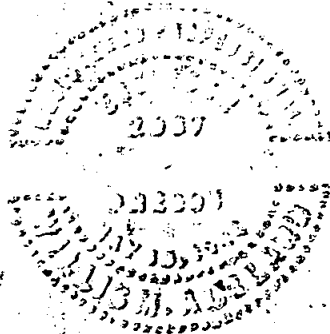

Received 5/5/47
P.D.R.
Co. Surv.