
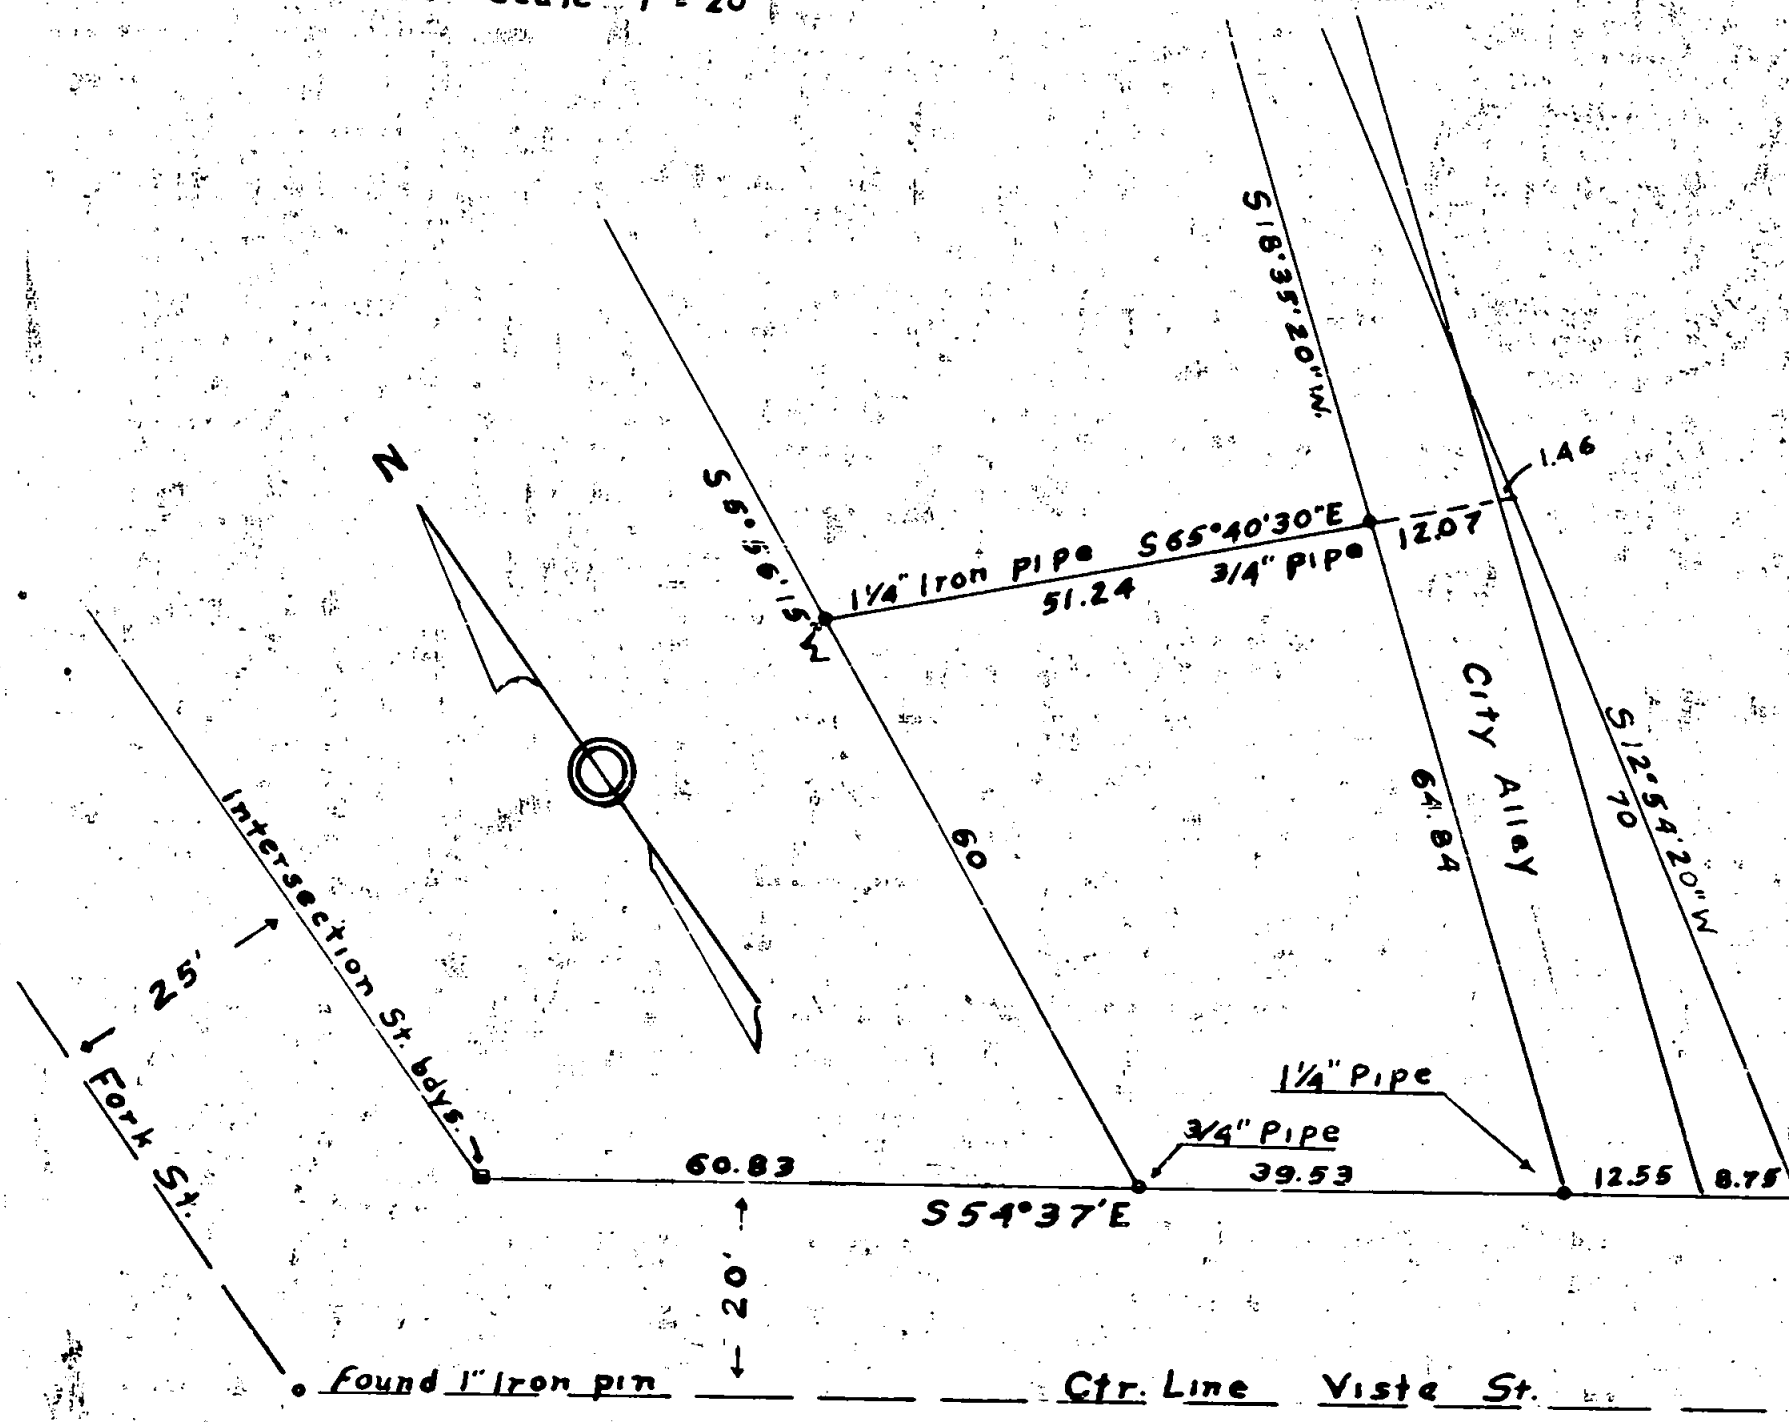


05

ADA G. JONES

Property Located in City of Ashland  
Portion of Hargadine Tracts  
Surveyed Oct 1947

Scale 1" = 20'

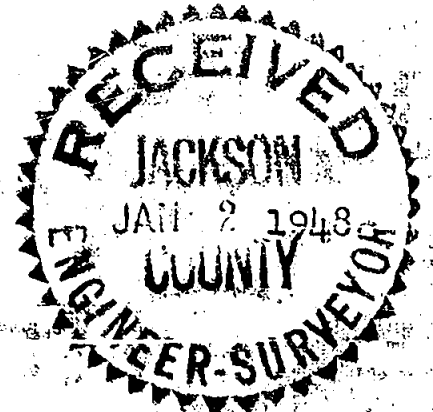

REGISTERED  
OREGON  
LAND SURVEYOR

*C. Z. Boyden*

MARCH 10, 1944  
C. Z. BOYDEN  
7

Survey narrative as per Section 87 330 Oregon Law 1947

Ada G. Jones survey, part of Lot No. 1, Hargadine Tract, Ashland, Jackson County, Oregon.

Found all the street center monuments adjoining Lots 1, 2, 3, 4, 5, 6, 15 and 16, Hargadine Tract marked with iron pins in good condition from which set a wood stake for intersection of the East boundary of Fork Street with the Northeasterly boundary of Vista Street; run S. 54°-37' E. along the said boundary of Vista Street 60.83 feet and set a 3/4" x 24" iron pipe for property corner on single proportion distance found to exist along the Southwest boundary of the above mentioned Lots of the Hargadine Tract; continue S. 54°-37' E. 39.53 feet and set a 1 1/4" x 24" iron pipe at the Westerly boundary of the city alley as described in said County Deed Records, Volume 56, Page 184 for property corner. Run N. 18°-35'-20" E. along the Westerly boundary of said alley 64.84 feet and set a 3/4" x 24" iron pipe for property corner. Run N. 65°-40'-30" W. 51.24 feet and set 1 1/4" x 24" iron pipe for property corner; run S. 5°-56'-15" W. 60.0 feet to the aforesaid property corner, control for the meridian the center line of Hargadine Street as 54°-41' E.

REGISTERED  
OREGON  
LAND SURVEYOR

*C. Z. Boyden*  
MARCH 10, 1944  
C. Z. BOYDEN  
7

Surveyed September and  
October, 1947

RECEIVED  
JACKSON  
COUNTY  
ENGINEER-SURVEYOR  
JAN 21 1948