

Survey No. _____ Recorded in the County Surveyor's Office.

For Percy Haley

Surveyed, September, 1947.

Boundary survey for three tracts adjoining Little Butte Market Road located in Section 35, Twp. 35 S., R. 1 W., W.M. Found the 1 1/2" iron pipe for the Southwest corner of D.L.C. No. 39 as officially re-established September 10, 1943. Also found a 1/2" iron pin old P.I. at Station 13+43.0 also 1" iron pipe at Station 25+46.8 of Little Butte Creek Market Road #5 now State Road No. 236, as surveyed December 28, 1927 and shown in County Engineer's Field Book. No. 45, page 6 which data and monuments was used for the control center line of said State road.


From the above mentioned Southwest corner of D.L.C. No. 39, run S. 89°-57' E. along the South boundary of said D.L.C. No. 39 907.5 feet; run North 34.52 feet and set a 3/4" x 30" iron pipe of the Northerly right of way line of the State Highway No. 236, continue North 240.8 feet and set a 3/4" x 37" iron pipe for the Northwest corner of a 1.11 acre tract, continue North 389.32 feet to the Northwesterly property corner which falls in an irrigation canal (set a 3/4" iron pipe for reference corner which bears South 14.25 feet); run N. 75°-05'-30" E. 206.44 feet and set a 1-3/4" iron pipe; run S. 5°-24' E. along the boundary of property referred to in Suit to Quiet Title, filed in Circuit Court Journal, Volume 79, Page 363, 11.61 feet; run N. 75°-50' E. following the boundary of the property referred to in said Suit to Quiet Title for 511.3 feet and set a 3/4" iron pipe; run S. 6°-02'-30" E. 191.63 feet and set a 3/4" iron pipe; on the Northwesterly right of way line of State Road No. 236; run S. 28°-39'-30" W. along said road right of way 397.89 feet and set a 3/4" iron pipe; run along the arc of said road right of way on a 490.87 foot radius curve for a distance of 415.13 feet and set a 3/4" iron pipe for the Southeast corner of the said 1.11 acre tract.

Continue on said road right of way curve along the arc 102.19 feet and set a 3/4" iron pipe, which long chord bears S. 83°-04'-40" W. 102.0 feet; run S. 89°-02'-30" W. 102.74 feet to the Southwest corner of the said 1.11 acre tract.

Return to the said Northwest corner of the 1.11 acre tract and run East 204.0 feet and set a 3/4" iron pipe for the Northeast corner of the 1.11 acre tract; run South 226.8 feet to the aforesaid Southeast corner of the 1.11 acre tract.

From the aforesaid Southwest corner of D.L.C. No. 39, run S. 89°-57' E. along the South boundary of said D.L.C. No. 39, 1313.75 feet and set a 3/4" iron pipe for the Southwest corner of a 1.38 acre tract; run North 73.22 feet and set a 3/4" iron pipe on the Southeastly right of way line of the aforesaid State Road No. 236; run along said right of way line along the arc of a 550.87 foot radius curve for 258.44 feet and set a 3/4" iron pipe (the long chord bears N. 42°-06' E. 256.08 feet); run N. 28°-39'-30" E. along the said right of way line 311.23 feet and set a 3/4" iron pipe; run S. 6°-02'-30" E. 217.72 feet to a point in Little Butte Creek, S. 49°-58'-45" W. 53.03 feet to a point in said creek, S. 30°-00' W. 330.0 feet by deed to a point in said creek, N. 89°-57' W. on the South boundary of said D.L.C. No. 39 138.25 feet to the Southwest corner of the 1.38 acre tract.

C. Z. Boyden

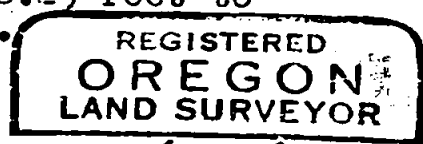

C. Z. Boyden

