

REED ET.AL.  
Located in Sec. 5 T38S R1W  
Surveyed Nov. 1947

REGISTERED  
OREGON  
LAND SURVEYOR

*C. Z. Boyden*

MARCH 10, 1944  
C. Z. BOYDEN  
7



Scale 1" = 200'

S.W. Cor DLC. N° 50 Found 3/4" Pipe 200

1" Iron pin  
QUICK  
200

352.4  
108.9  
NO°04'W 1659.2

3/4" pipe  
550.1

REED

3/4" pipe

1" Pipe (found)  
803.6

North

1491.5

687.9

NI°47'E

167.78

1 1/2" Steel tube  
589°55'E  
557.3

3/4" pipe  
NI°47'E 19.02

East 231.8  
5/8" iron pin

SHEARIN

25.0 R/W

1" pipe

3/4" PIPE

463.6

433.1

NO°05'E 30'


HOCKERSMITH

East 90.57  
found 2" L bar

S.P.R.

3/4" pipe

33°08'E

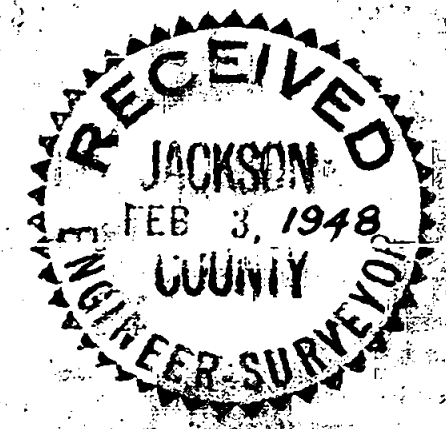

Record Reestablished  
SE Cor DLC. N° 50  
1 1/2" pipe

Survey narrative as per section 87-330 Oregon Law 1947.

Reed, Shearin, Hockersmith and Quick survey located in Section 5, also D.L.C. No. 50, Twp. 38 South, Range 1 West, W.W.

Found the  $1\frac{1}{2}$ " pipe and references as described in the official re-establishment of the Southeast corner D.L.C. No. 50, Twp. 38 S., R 1 W., W.M., as established February 20, 1940. Run N.  $0^{\circ}-05'$  E. 30.0 feet; run N.  $89^{\circ}-55'$  W. parallel to and 30 feet from the South boundary of said D.L.C. No. 50 for 433.1 feet and set a  $\frac{3}{4}$ " iron pipe for the Southeast corner of the Hockersmith property described in Jackson County, Oregon Deed Records, Volume 241, Page 238; continue running N.  $89^{\circ}-55'$  W. 463.6 feet and found the 1" iron pipe being the Southeast corner of the Reed property described in Volume 279, Page 477 in said County Deed Records; continue running N.  $89^{\circ}-55'$  W. for 550.1 feet and set a  $\frac{3}{4}$ " iron pipe for the Southwest corner of the Reed property as above mentioned, also being the Southeast corner of the Quick property described in said County Deed Records, Volume 268, Page 38; continue running N.  $89^{\circ}-55'$  W. 200.0 feet and set a 1" iron pin for the Southwest corner of the Quick property as above described; continue running N.  $89^{\circ}-55'$  W. for 200.0 feet and found the  $\frac{3}{4}$ " iron pipe as set by myself March, 1940 to be correct. Return to the  $\frac{3}{4}$ " pipe as set for the division line between the Reed and Quick property and run N.  $0^{\circ}-04'$  W. 352.4 feet; set a temporary corner; continue running N.  $0^{\circ}-04'$  W. 108.9 feet and set a  $\frac{5}{8}$ " iron pin for the Southeast corner of the property described in the Deed Records, Volume 280, Page 294; continue running N.  $0^{\circ}-04'$  W. 1197.9 feet and set a  $1\frac{1}{2}$ " steel tube for the Northwest corner of the Reed property.

Return to the aforesaid 1" pipe at the Southeast corner of the Reed property; run North along the East boundary of the Reed property at 803.6 feet; set a  $\frac{3}{4}$ " iron pipe for the Southwest corner of the Shearin property; continue North between the Reed and Shearin property at 687.9 feet; set a 1" iron pipe for the angle point in the property boundary; run N.  $1^{\circ}-47'$  E. 167.78 feet and set a 1" iron pipe for the Northeast corner of the Reed property; continue N.  $1^{\circ}-47'$  E. for 19.02 feet and set a  $\frac{3}{4}$ " iron pipe for the Northwest corner of the Shearin property; run East 231.8 feet and set a  $\frac{3}{4}$ " iron pipe for the Northeast corner of the Shearin property.

Found the 2" x 2" iron angle bar set for the most Easterly corner of that certain 25 foot right of way described in Registered Title No. 5304 and established by myself in March of 1940, from said corner run West 30.57 feet. No evidence of the old corner; set a  $\frac{3}{4}$ " iron pipe for the angle point in the Hockersmith description; run N.  $35^{\circ}-08'$  W. 107.0 feet found a  $\frac{3}{4}$ " pipe for corner, at the same location of the  $\frac{3}{4}$ " pipe as found; set a 1" x 24" iron pipe for the North corner of the Hockersmith property.

Surveyed November 6, 7, and 8, 1947.

REGISTERED  
OREGON  
LAND SURVEYOR

*C. Z. Boyden*

MARCH 10, 1948  
C. Z. BOYDEN

7

