


SECTION LINE SURVEY FOR MRS. HAMILTON, ON ANDERSON CREEK, NORTH

LINE SECTION 5, in TOWNSHIP 39 SOUTH, RANGE 1 WEST, WM., JACKSON COUNTY OREGON

FEBRUARY 9, 1948

J. H. CLABBY, CONS. ENGR.

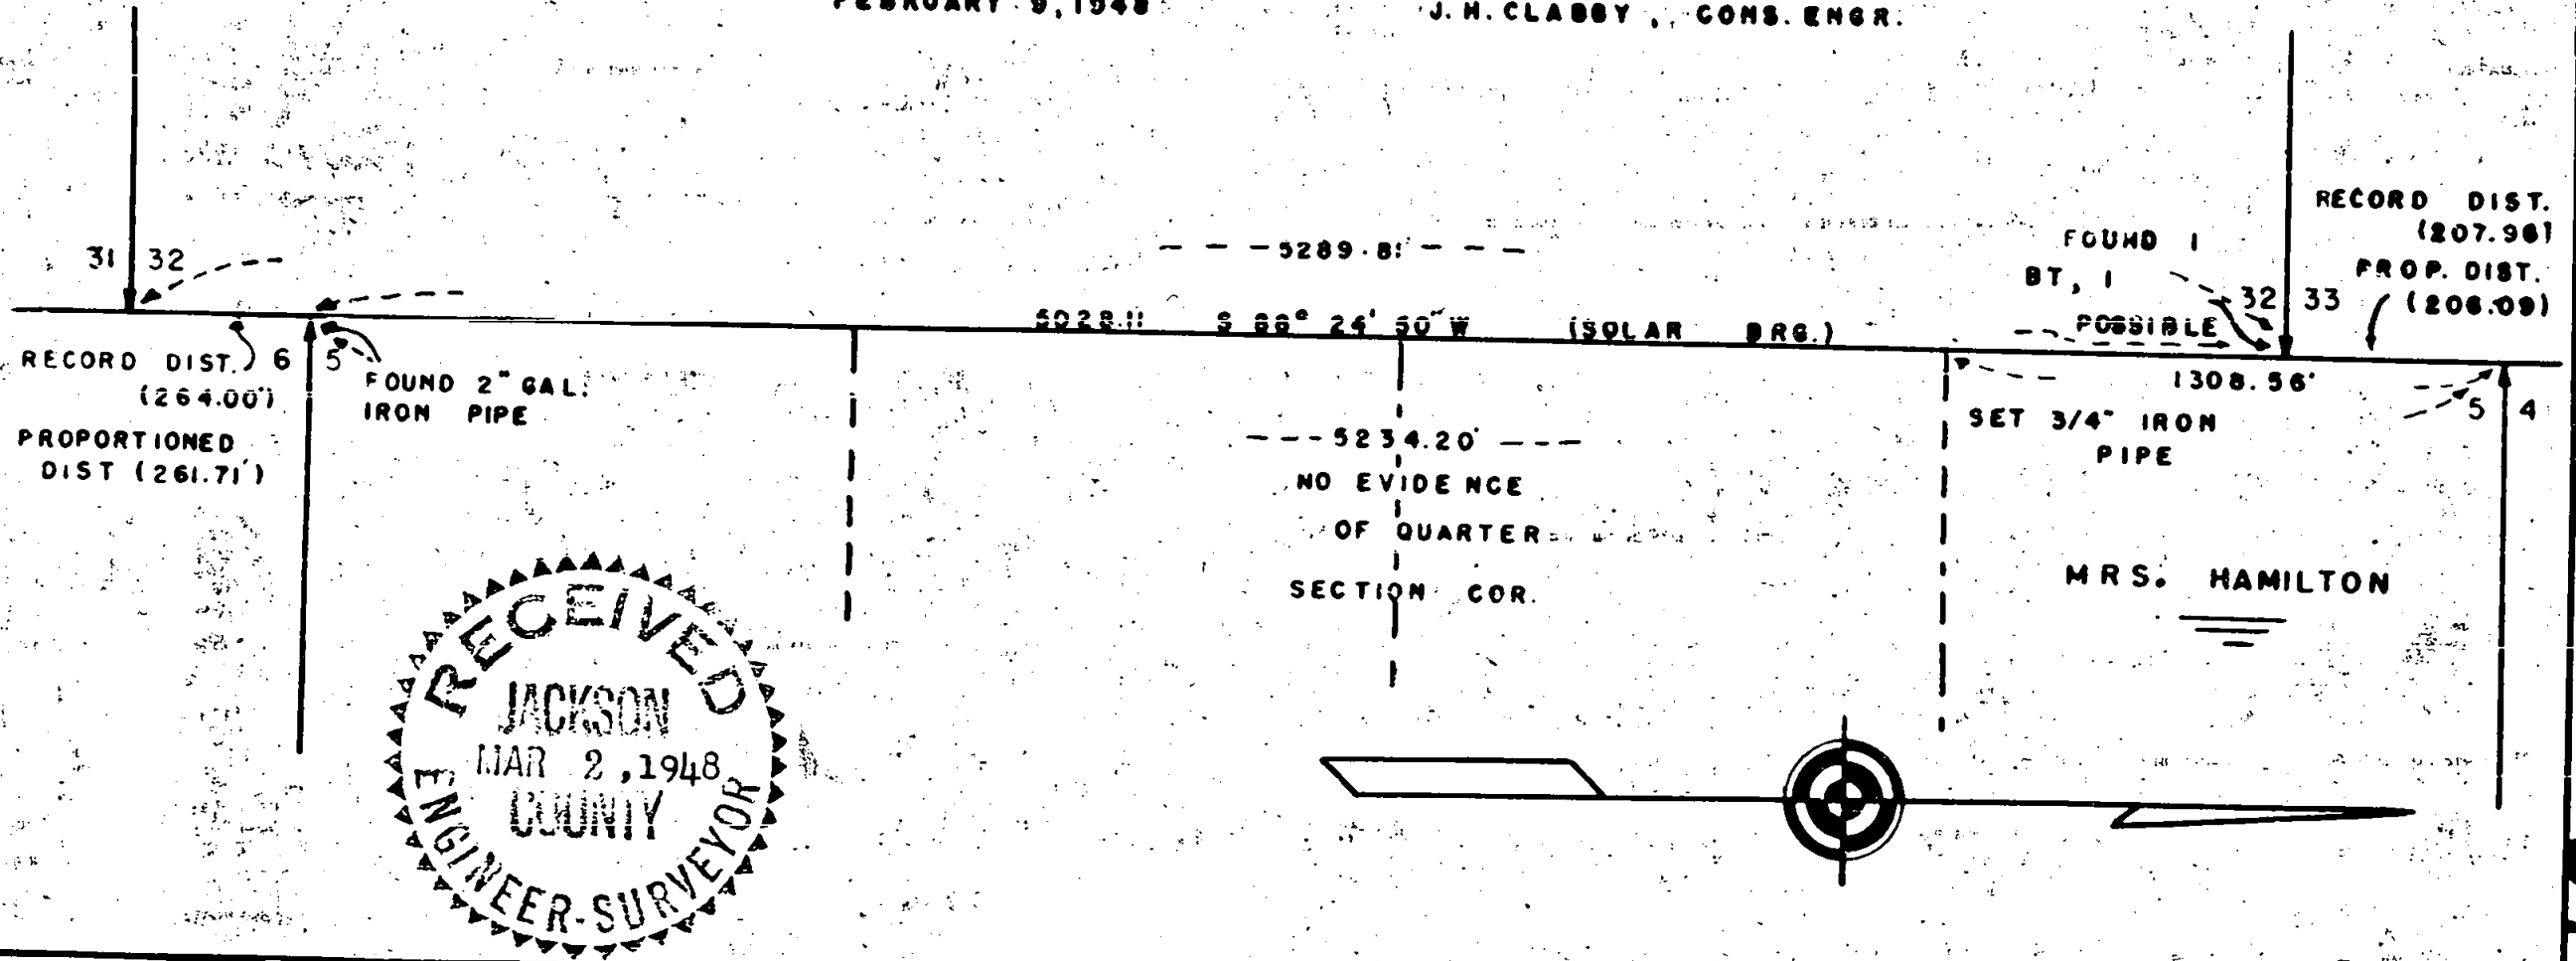

#27

Survey for Mrs. Hamilton, Anderson Creek.

Purpose of Survey:

To locate Section line and set 1/16 corner, which is the Northwest corner of the Northeast Quarter of the Northeast Quarter of Section 5, Township 39 South, Range 1 West, Willamette Meridian.

Commencing at the Southwest corner of Section 33, on the North line of Section 5, Township 39 South, Range 1 West, Willamette Meridian, Jackson County, Oregon. At said corner, located one original bearing tree and one possible tree, from said corner run South  $88^{\circ} 24' 50''$  West (bearing computed by solar observation) 5028.11 feet to the Northwest corner of said Section 5. No evidence remains of original Northeast corner of Section 5, using record proportioned distance for said corner, total distance is 5234.20 feet for Section 5, set  $3/4 \times 18''$  iron pipe for 1/16 corner 1102.47 feet South  $88^{\circ} 24' 50''$  West from the Southeast corner of Section 33, Township 38 South, Range 1 West, Willamette Meridian.

J. H. Clabby

February 1948

