

#29


SURVEY OF LOTS 8 & 9 OF THE CONROY CLANCY SUBDIVISION

FOR CHRIS SCHEMPP MEDFORD OREGON.

J. H. CLABBY CONS. ENG.


FEBRUARY 18 1948

SCALE 1" = 40'

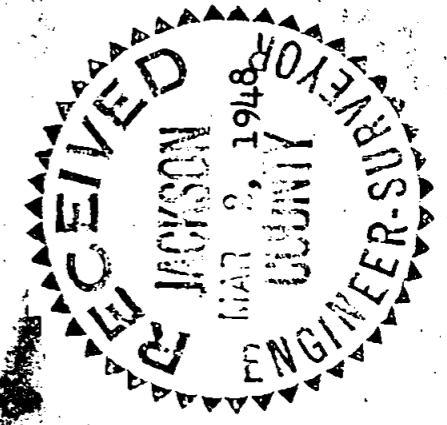

STREET

ACADEMY

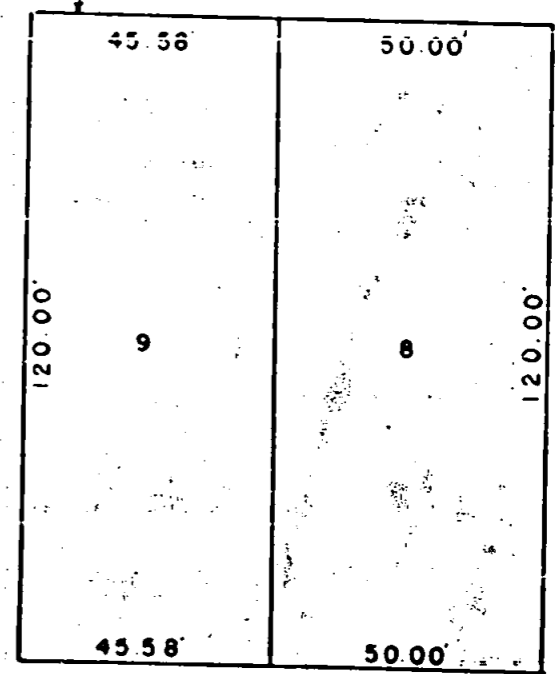

SE COR. D.L.C.
NO. 42., TWP
37 S., RIW.

EAST MAIN STREET

30.00'

POINT BEARS EAST 1557.52'
FROM SE COR. D.L.C. 42.

Survey for Mr. Chris Shempp, 305 Laurel Street, Medford, Oregon

Purpose of Survey: Stake two lots, Lots 8 and 9 of the Conroy Clancy Subdivision,
Medford, Oregon.

Commence at a point in the center of East Main Street which bears East 1557.52 feet from the Southeast corner of D. L. C. No. 42, Township 37 South, Range 1 West Willamette Meridian, run thence North 30.00 feet and set a 3/4 x 18" iron pipe for the Southwest corner of Lot 9, Block 1: continue North 120.00 feet and set a 3/4 x 18" iron pipe for the Northwest corner of Lot 9, Block 1, run thence East 95.58 feet and set a 3/4 x 18" iron pipe for the Northeast corner of Lot 8, Block 1: run thence South 120.00 feet and set a 3/4 x 18" iron pipe for the Southeast corner of Lot 8, Block 1: run thence West 95.58 feet to terminate traverse at the Southwest corner of Lot 9.

J. H. Clabby

February 1948

