


LOT SURVEY FOR Mr. R. W. DENMAN on No. 24 North Orange Street in Medford Oregon # 41

SCALE 1" = 100.0'

MARCH 18, 1948

J. H. CLABBY, CONS. ENGINEER R.

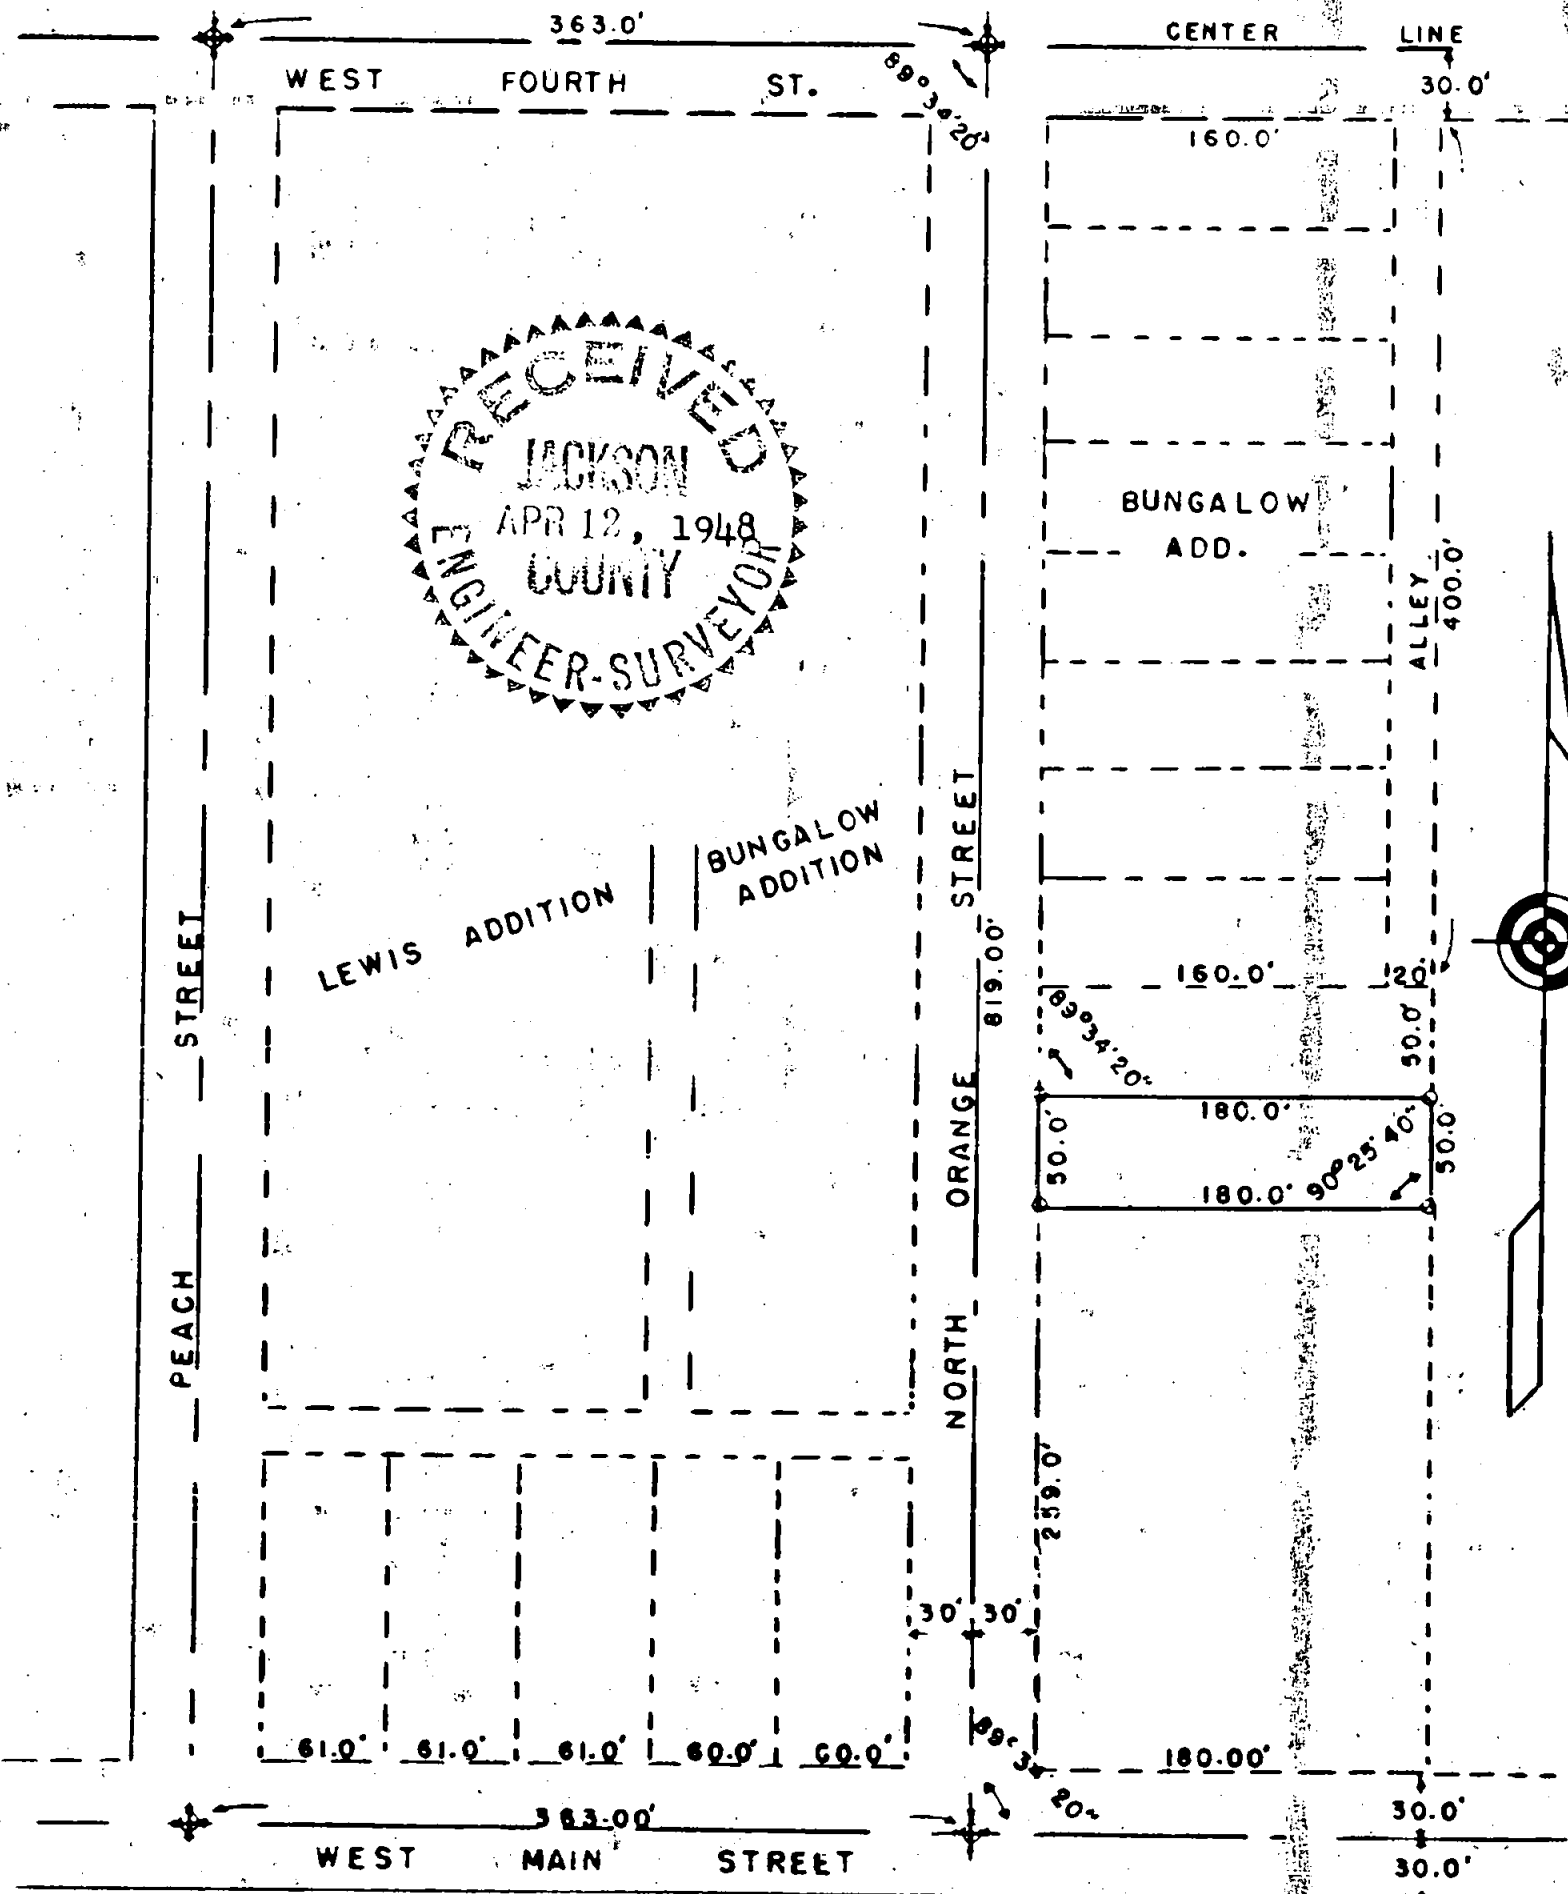

NOTE:
SET 3/4" PIPE ON ALL
LOT CORNERS.

Survey Narrative to Comply with Section 87-330, Oregon State Laws.
41

Purpose of Survey: To stake and survey property owned by R. W. Denman located in the Bungalow Addition to the City of Medford (14 North Orange Street)

Survey procedure:

Commencing at the center line intersection monument located at West 7th and Peach street and projecting a line along the 7th street center line Easterly ^{MAP 363²} 360.00 feet to establish the center line intersections of West 7th and Orange street.

Commencing at the center line intersection of Peach street and West 4th street and projecting the center line of West 4th street Easterly ^{MAP 363²} 360.00 feet to establish the center line intersection of West 4th street and Orange street.

Thence running Southerly along the established center line of Orange street 818.97 feet to the established intersection of Orange and West 7th street. The record distance being 819.00 feet,

The difference was considered too small to proportion and the lot was staked on neat lines as shown on the attached plat with the North and South lines of lot parallel to the center line of 7th and 4th street and the East and West lines parallel to the center line of Orange street.

J. H. Clabby
Consulting Engineer.

March 19, 1948

