


51

RAY WYATT

Sec. 11, T36S, R2W, W.M.  
SUVEYED APRIL 12, 1948

© NE Cor. DLC N° 42

N

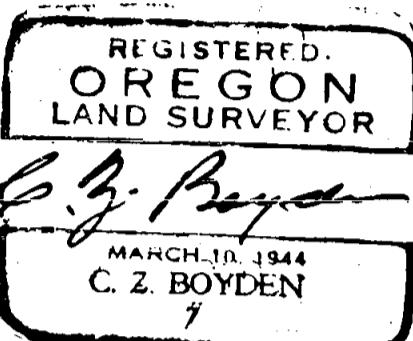

SCALE 1" = 60'

50°03'E  
240.42  
N 0°03'W  
1" Iron Pin  
11.46

0.92 Acre

S58°51'E  
278.57

571°05'30"W  
440.4


N 81°09'E  
192.0

S58°51'E  
128.7

1" Iron Pin

COUNTY ROAD

30°  
30°

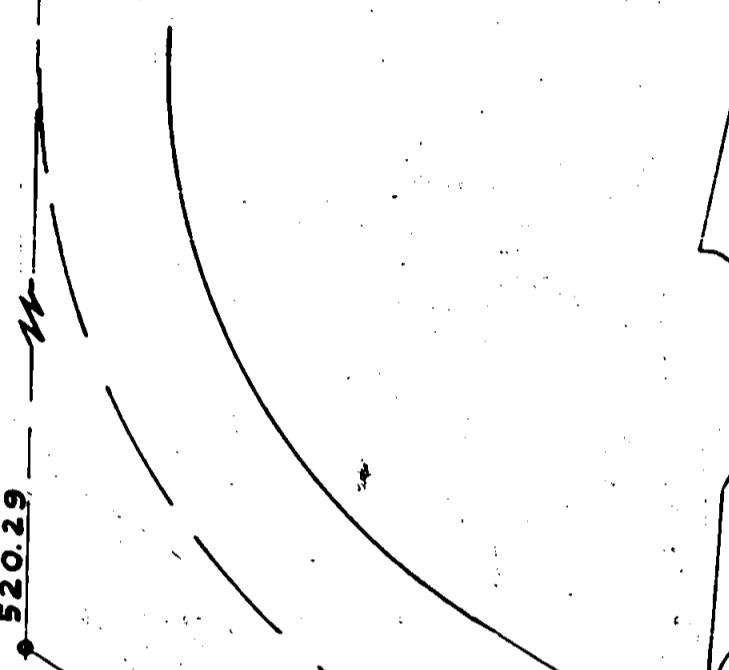

**51**

Survey \_\_\_\_\_ for Ray Wyatt.

Survey to establish the corners and prepare description for the transfer of the property.

Establish the Northeast corner D.L.C. No. 42, Township 36 South, Range 2 West, Willamette Meridian from the references as recorded in the County Surveyor's Office for said corner run S.  $0^{\circ} 03'$  E. along the East boundary of said D.L.C. No. 42, 330.9 feet to the P.I. of the curve; run S.  $58^{\circ} 51'$  E. and set a point on the center line of the Table Rock Market Road from which point set a 1" x 33" iron pin  $90^{\circ}$  00' right for 30 feet and set a corner being the Easterly corner of the premises to be transferred.

From the said Northeast corner D.L.C. No. 42, run S.  $0^{\circ} 03'$  E. 520.29 feet; thence S.  $58^{\circ} 51'$  E. 11.46 feet and set a 1" x 24" iron pin for the point of beginning of said premises, run S.  $58^{\circ} 51'$  E. along the Southwesterly boundary of the premises described in said County Deed Record Volume 275, Page 232, for 278.57 feet, run N.  $31^{\circ} 09'$  E. 132.0 feet to the East corner of the premises described in the said Volume 275, Page 232, run S.  $58^{\circ} 51'$  E. along the Southerly right of way line of the Table Rock Market Road 128.7 feet to a point being a 1" x 33" iron axle shaft for the East corner as above described, run S.  $71^{\circ} 05' 30''$  W. 440.4 feet and set a 1" x 30" iron pin for the South corner; run N.  $0^{\circ} 03'$  W. parallel with the East boundary of said D.L.C. No. 42, 240.42 feet to the point of beginning.

April 12, 1948

