

60'

N 22° 30'

Property Line


Not Found

Total Lot + Street Distance

Not Found  
S.W. Cor.  



Property Line

STREET

CALIFORNIA

LINE SURVEY

Scale 1" = 100'  
Harris Inge  
Civil Engineer

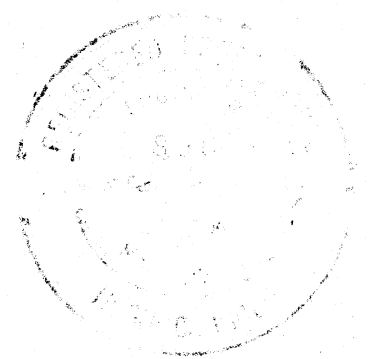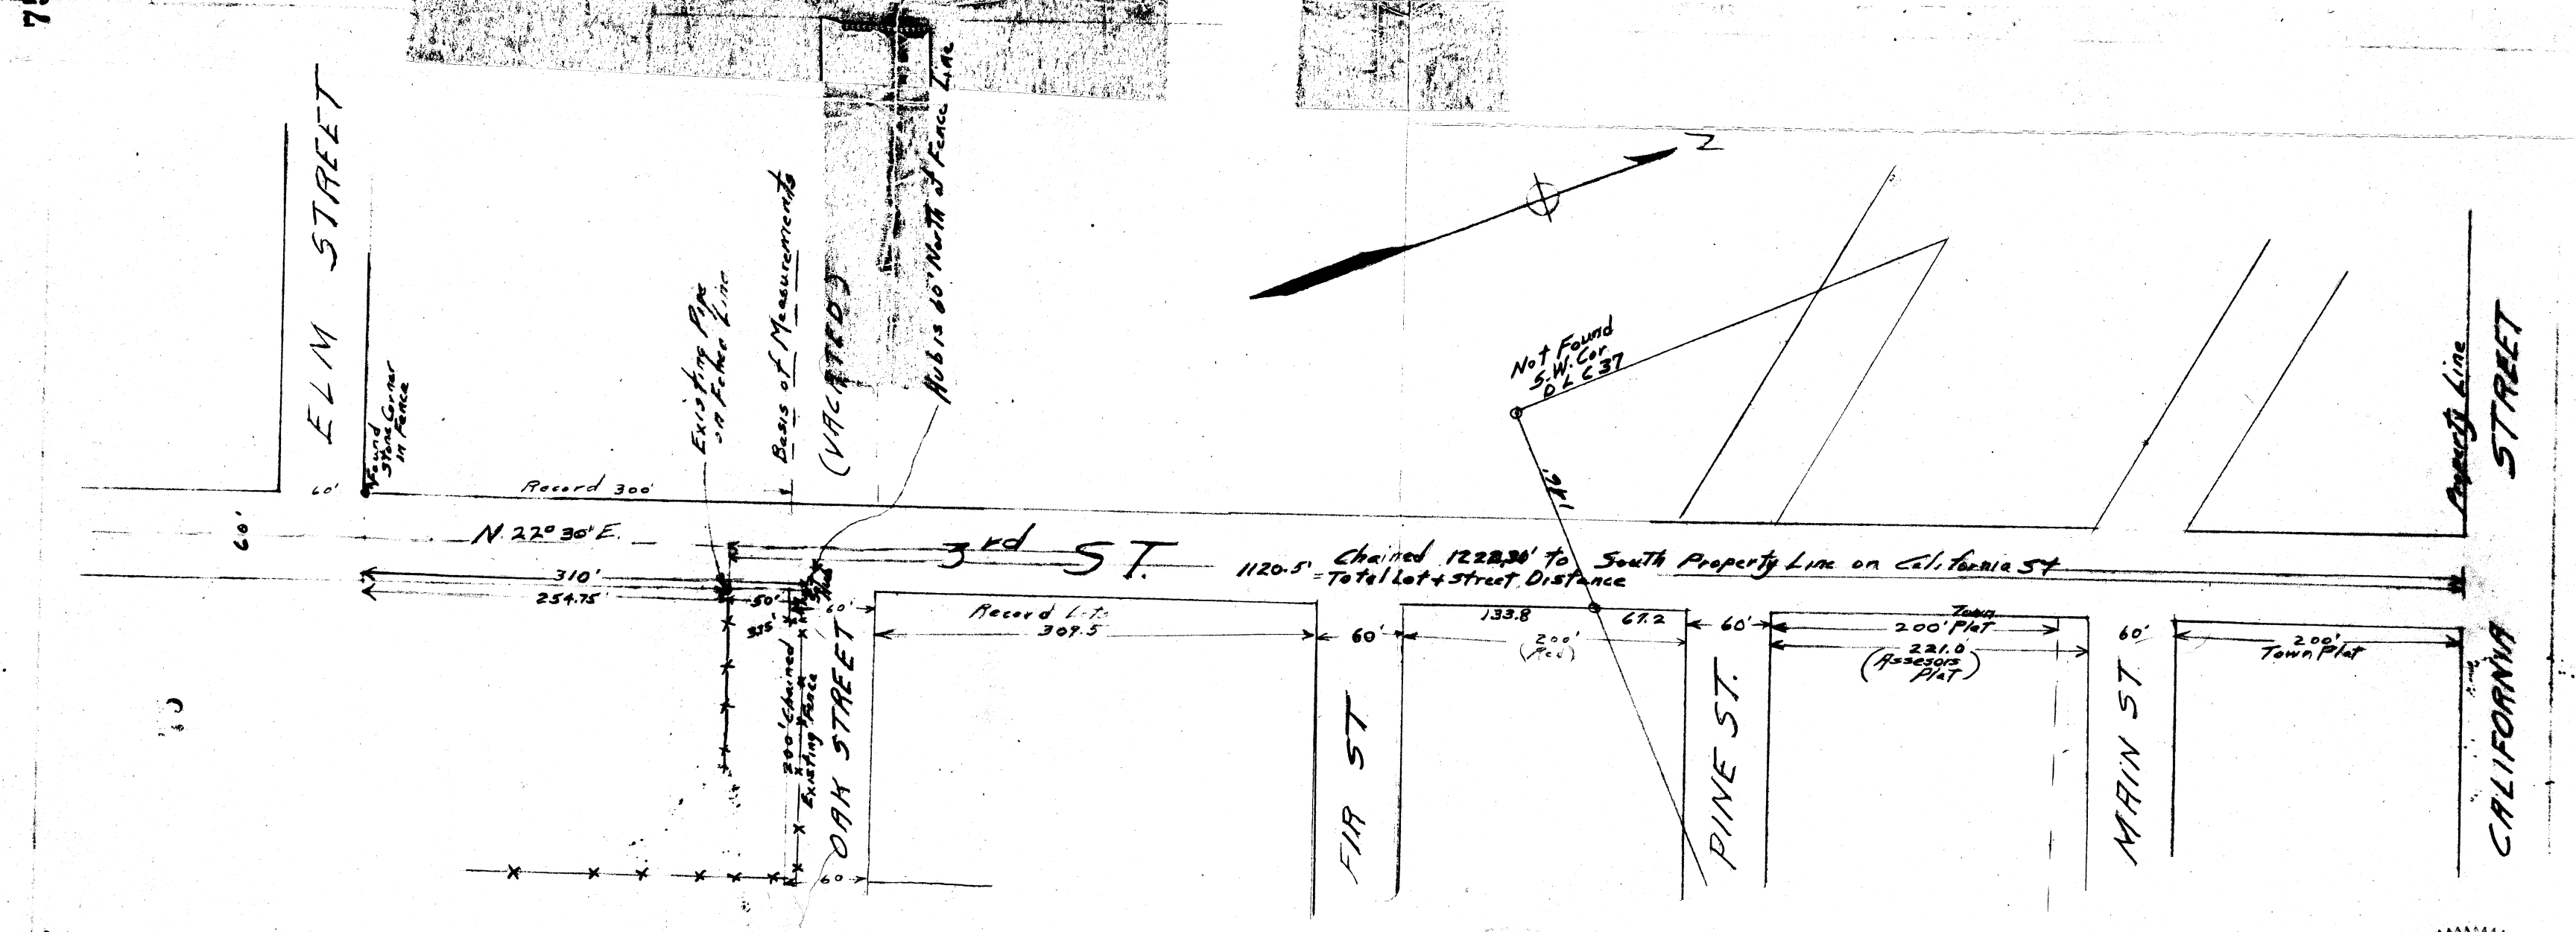

PLAT  
 LINE SURVEY  
 TO  
 MOON PROPERTY CORNER  
 3rd + OAK STREET  
 JACKSONVILLE OREGON  
 July 2, 1948  
 Scale 1" = 100'

Hugh C. Ingle  
 Civil Engineer

