


76
96

76

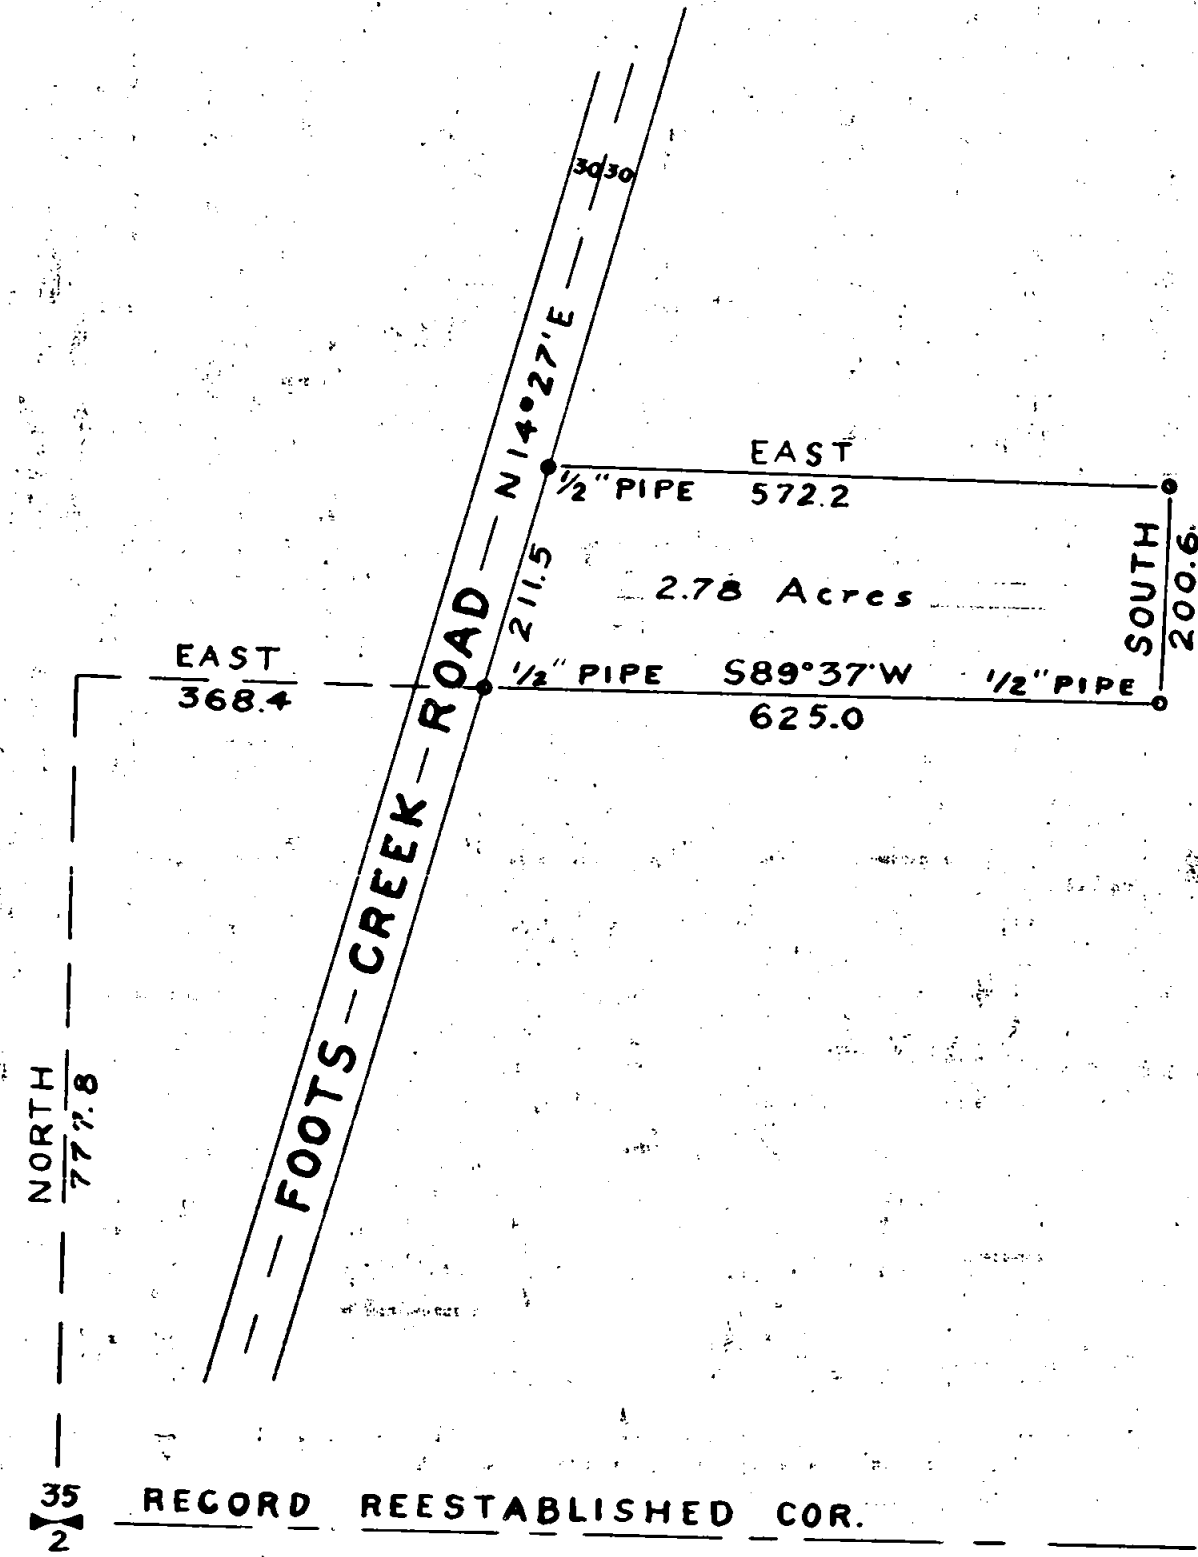

FRANK A. FREEBURGER
 LOCATED IN SEC. 35, T36S, R4W, W.M.
 SURVEYED MAY 21, 1948

REGISTERED
 OREGON
 LAND SURVEYOR
C. Z. Boyden
 MARCH 10, 1944
 C. Z. BOYDEN
 7



SCALE - 1" = 200'

RECORD REESTABLISHED COR.

Survey No. 76 for Frank A. Freeburger.

Purpose of Survey: Establish boundaries and prepare description for transfer of the property.

Commencing at a $3/4$ " x 36" galvanized iron pipe, the record re-established $1/4$ section corner between Section 35, Township 36 South, Range 4 West, and Section 2, Township 37 South, Range 4 West, and ran by traverse to and along the county road and set a $1/2$ " pipe on the Easterly boundary of said county road for the point of beginning, which point is 777.8 feet North and 368.4 East of the $1/4$ section corner aforementioned.

From the point of beginning, ran S. $87^{\circ} 37'$ W. 625.0 feet and set a $1/2$ " pipe for the Southeast corner of the tract being surveyed. Returned to the point of beginning and ran N. $14^{\circ} 27'$ E. 211.5 feet along the Easterly boundary of the county road and set a $1/2$ " pipe; ran thence East 572.2 feet (a calculated distance) to a point north of the Southeast corner and set a $1/2$ " pipe; ran thence South 200.6 feet to the Southeast corner to complete the survey.

May, 1948

REGISTERED
OREGON
LAND SURVEYOR

C. Z. Boyden

MARCH 10, 1944
C. Z. BOYDEN
7

