

40.00 Acres

HILLCREST ORCHARDS.

SURVEY OF A TRACT of LAND

For Mr TED GUETZLAFF,

Located in


Section 21, 22, Township 37 South, Range 1W, of the

Willamette Meridian

JACKSON COUNTY ORE.


SCALE 1"=200.0'

AUGUST 22, 1948

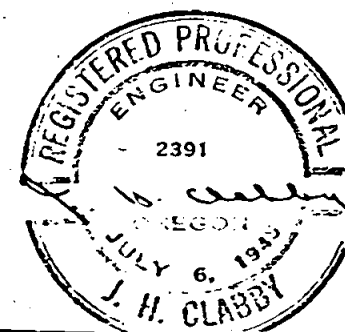

J. H. CLABBY, CONSULTING ENGINEER

87

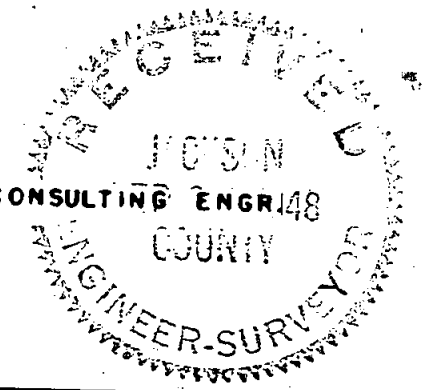

Survey Narrative to Comply with Section 87, 330, 1947 Oregon State Laws

87

87

Survey for: Mr. Ted Guetzlaff, located in Sections 21 and 22, Twp 37 S R 1 West
of the Will. Meridian Jackson County Oregon.

Purpose of survey:

To stake and describe a 40.00 acre tract, located within said sections.

Survey Procedure:

Located and tied by traverse, the following DLC corners, the NE corner of DLC 63, the most easterly SE corner of DLC 63, the NE corner of DLC 61, and the NE corner of DLC 60.

Commence at the easterly SE corner of DLC 63, run thence $N0^{\circ}09'E$ (Bearings by solar observation) on the East line of DLC 63, 1163.21 feet and set $3/4"$ by 18" iron pipe, run thence $S89^{\circ}35'20"E$ 1502.18 feet and set $3/4"$ iron pipe, run thence $S0^{\circ}09'W$ 1153.21 feet and set $3/4"$ iron pipe, run thence $N89^{\circ}35'20"W$ 504.97 feet, run thence $S0^{\circ}09'W$ 10.00 feet to the NE corner of DLC 61, run thence along the North line of DLC 61, 997.19 feet to terminate traverse at the point of beginning.

J. H. Clabby

August 1948

