

1/4 SECTION CORNER

SEC. 32, TWP. 38 S, 2 W.


SEC. 5, TWP. 39 S, 2 W.

FOUND 1" PIPE

LINE RUN For Mr. O.E. TUTTLE,

Sec. 5, Twp. 39 S, R2 W, of the Will. Meridian,

JACKSON COUNTY OREGON.

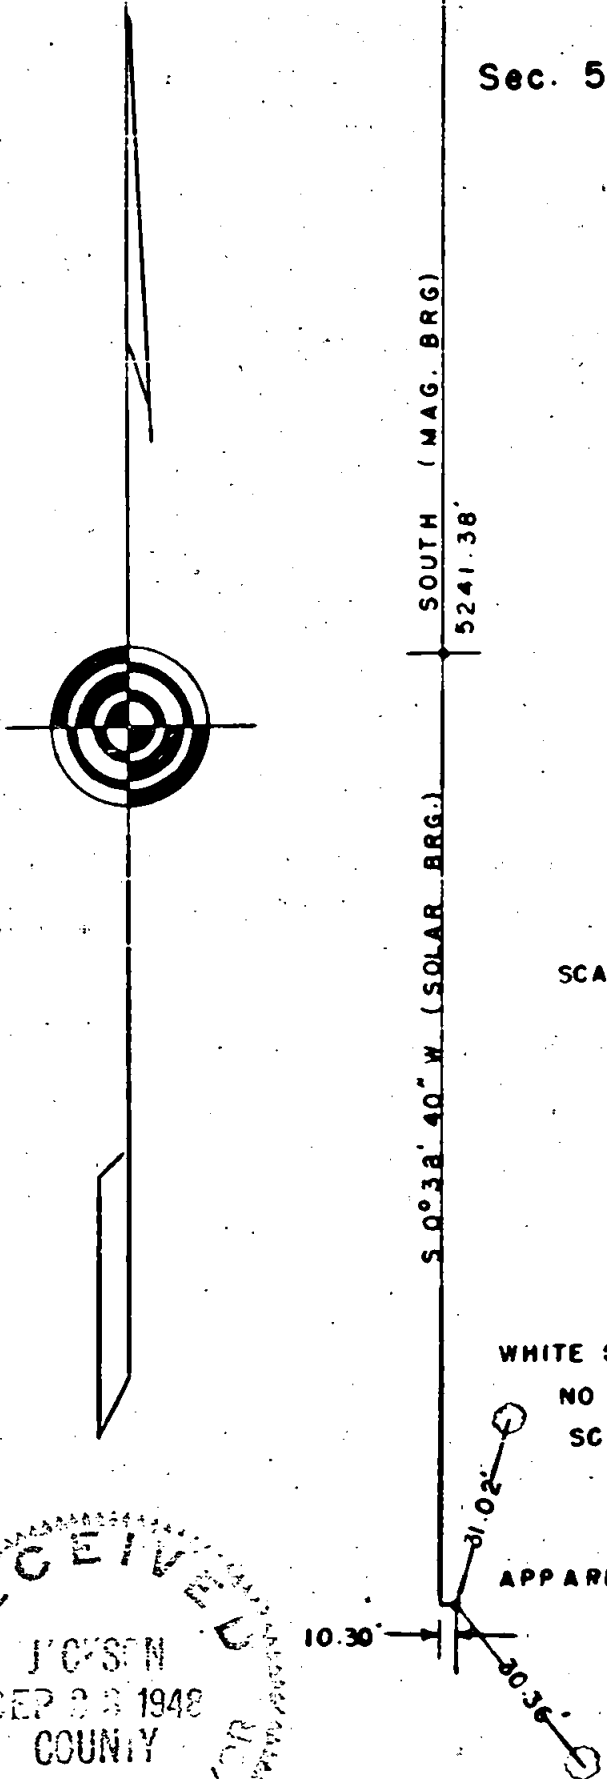

SCALE 1" = 600.0'

AUGUST 7, 1948


J.H. CLABBY, CONS. ENGR.

88

WHITE OAK (DOWN)  
NO SCRIBING BUT  
SCARS EVIDENT.

APPARENT INTERSECTION

BLACK OAK (DOWN), HAS  
BEEN CHOPPED INTO BEFORE  
(NO ACTUAL SCRIBING)  
VISIBLE.

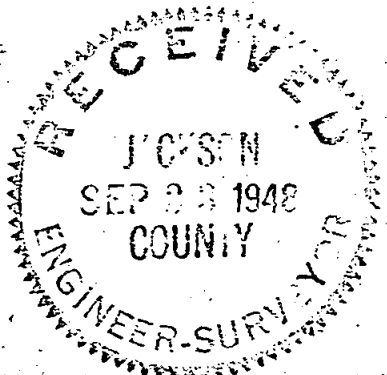

Survey Narrative to Comply with Section 87, page 330-1947 Oregon State Laws.

88

Survey for:

Mr. E. O. Tuttle, Section 5, Township 39 South, Range 2 West of the Willamette Meridian, Jackson County, Oregon.

Purpose of Survey:

To run line South through the center of Section 5, to verify the feet that buildings are on own property.

Survey Procedure:

Commence at the Quarter corner common to Section 32, Township 38 South, Range 2 West and Section 5, Township 39 South, Range 2 West of the Willamette Meridian, said corner being a 1" by 36" gal. iron pipe as called for in the re-established corner notes of said County, run thence South (Mag. bearing), South  $0^{\circ} 38' 40''$  West (Solar Bearing) 5241.38 feet where we located two trees which could possibly have been the bearing trees. For the Quarter corner on the South boundary of Section 5, trees had every indication of bearing trees being/ but actually no scribing was found on either.

J. H. Clabby

August 1948

