

NARRATIVE REPORT

SURVEY and SURDIVIDING PARCELS

92


in
L. A. RICE D. L. C. #59, T. 37 S., R. 2 W. W. M.

JACKSON COUNTY, OREGON

Purpose of this survey was to establish existing property boundaries and partitioning out and establishing corners of three parcels within the land boundaries indicated on the attached plat as parcels Nos. 1, 2 and 3.

Survey was started from found pipe marking the Southwest corner of Donation Land Claim #59 and running East by line over pipe marking Northwest Corner of Donation Land Claim #60. Measurement chained East and North in accordance with property description to the point of beginning. Point of beginning agreed with Southeast fence corner on property.

Measurements made by bearing West to the East boundary of Northern tract was in accord with Deed description and agreed with East fence. Distance West to East line of Table Rock Road was determined by chaining. The most Northerly fence line of property was found to be North of called distance as shown by the plat. Corners established are marked by 1" diameter iron pins.

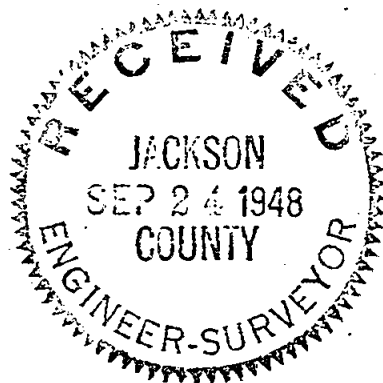

HUGH C. INGLE,
Civil Engineer

